

RESTORED CORNER FOR OREGON STATE BOARD OF FORESTRY

Section corner common to Sections 27, 28, 33 &
34, T. 23S, R. 10W, W.M., Douglas and Coos
Counties, Oregon.

ORIGINAL

Post (now missing) from which a:

- 20" Fir bears N26E 25 lks.; now 27" uproot, face grown over.
- 18" Fir bears S52E 32 lks.; now 20" uproot, face grown over.
- 14" Fir bears S57W 84 lks.; now 24", original axe work and portion
of scribe visible.
- 8" Fir bears N79W 124 lks.; now missing.

RESTORED

Var. 20°E


Set 1½" x 36" galvanized iron pipe with 3" bronze cap marked "OREGON STATE
BOARD OF FORESTRY T23S R10W S27 S28 S33 S34 1958 RS359", 33 inches in
ground, and from which a:

- 27" Fir bears N26E 45.9 ft.; scribed T23S R10W S27 BT RS359.
- 15" Fir bears N43W 37.8 ft.; scribed T23S R10W S28 BT.
- 22" Fir bears S42E 23.4 ft.; scribed T23S R10W S34 BT.
- 24" Fir bears S66W 74.1 ft.; scribed T23S R10W S33 BT.

Oregon State Board of Forestry metal location poster on 22" Fir BT.

Dated November 26, 1958

Restored by Elbert Driver under my direction.
Elbert Driver, Transitman

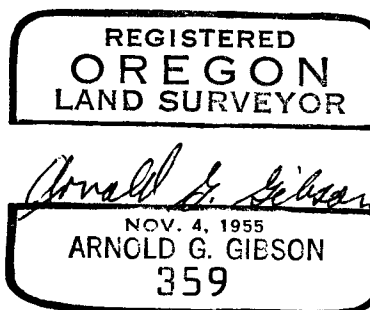

Present and witnessed by Robert Banks
Derald Timmons
Don McConnell