

RESTORED CORNER FOR OREGON STATE BOARD OF FORESTRY

One Quarter Section corner common to Sections 33
and 34, T23S, R10W, W.M., Coos & Douglas Counties,
Oregon.

ORIGINAL

Post (Now missing - found hole where rotted out) from which a:

24" Hemlock bears S69E 39 lks.; now 32", face overgrown.
36" Fir bears N74W 51 lks.; now 42", scribes BT visible.

RESTORED

Set 1½" x 36" galvanized iron pipe with 3" bronze cap marked "OREGON STATE
BOARD OF FORESTRY T23S R10W 1/4 S33 S34 1960 RS359", 33 inches in ground,
and from which a:

Original 24" Hemlock bears S69E 25.7 ft.; scribed RS359 BT (near bottom).
Original 36" Fir bears N74W 33.7 ft.; scribed BT (near bottom).


Oregon State Board of Forestry metal location poster on original 24"
Hemlock BT.

Douglas County Forest Appraisal Tag on original 24" Hemlock BT.

Set 4" x 4" x 6' white painted Cedar post N45E, 1.5' from pipe.

Dated May 17, 1960

Restored by George E. Shore, Jr. under my direction.
George E. Shore, Jr., Transitman

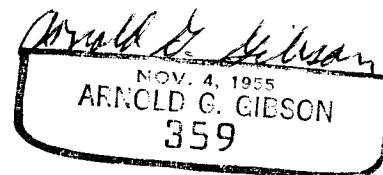

Present and witnessed by P. Lewellyn
G. Mahoney