

RESTORED CORNER FOR STATE OF OREGON-DEPARTMENT OF FORESTRY

Section corner common to Sections 22, 23, 26 and 27, T23S,
R10W, W.M., Douglas County, Oregon.

ORIGINAL

Fir Post (now missing) from which a:

- 6" Fir bears N88E 28 lks.; now 8" uproot, point falls in slid out area,
BT out of place downhill, scribes S23 BT visible.
- 6" Fir bears S80E 10 lks.; now missing.
- 7" Fir bears S70W 28 lks.; now 10" uproot with lower roots still in
place, scribes T2S W S27 visible.
- 8" Fir bears N02W 23 lks.; now missing.

RESTORATION by Levi C. Walker May 1906

Fir Post (now missing) from which a:

- 8" Fir bears S75E 22 lks. now missing.

RESTORED

Set 3" bronze cap marked "OREGON STATE BOARD OF FORESTRY T23S R10W S22 S23
S26 S27 1962 RS359", in mortar on a sandstone projection of which
3' x 4' x 2' is exposed, and from which a:

- 14" Maple bears N40E 70.1 ft.; scribed T23S R10W S23 BT.
- 20" Fir stump bears S58½W 96.5 ft.; scribed T23S R10W S27 BT RS359.

20' wide x 15' high sandstone face bears N86E 13.4 ft.; marked X B0 on
westerly edge.

Oregon State Forestry Department metal location poster on 8" Maple N87E
21.0 ft.

Set 4" x 4" x 72" white painted Cedar post 2.5' N.W. of corner point.

Dated April 13, 1962


Restored by Donald L. McConnell under my direction.
Donald L. McConnell, Transitman

FILED
RECEIVED

MAY 14 1962

COUNTY SURVEYOR
DOUGLAS COUNTY, ORE.

Present and witnessed by T. South
M. Pounds
D. Smith

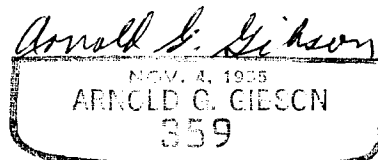

+10

C.S. File No. 42/422-9