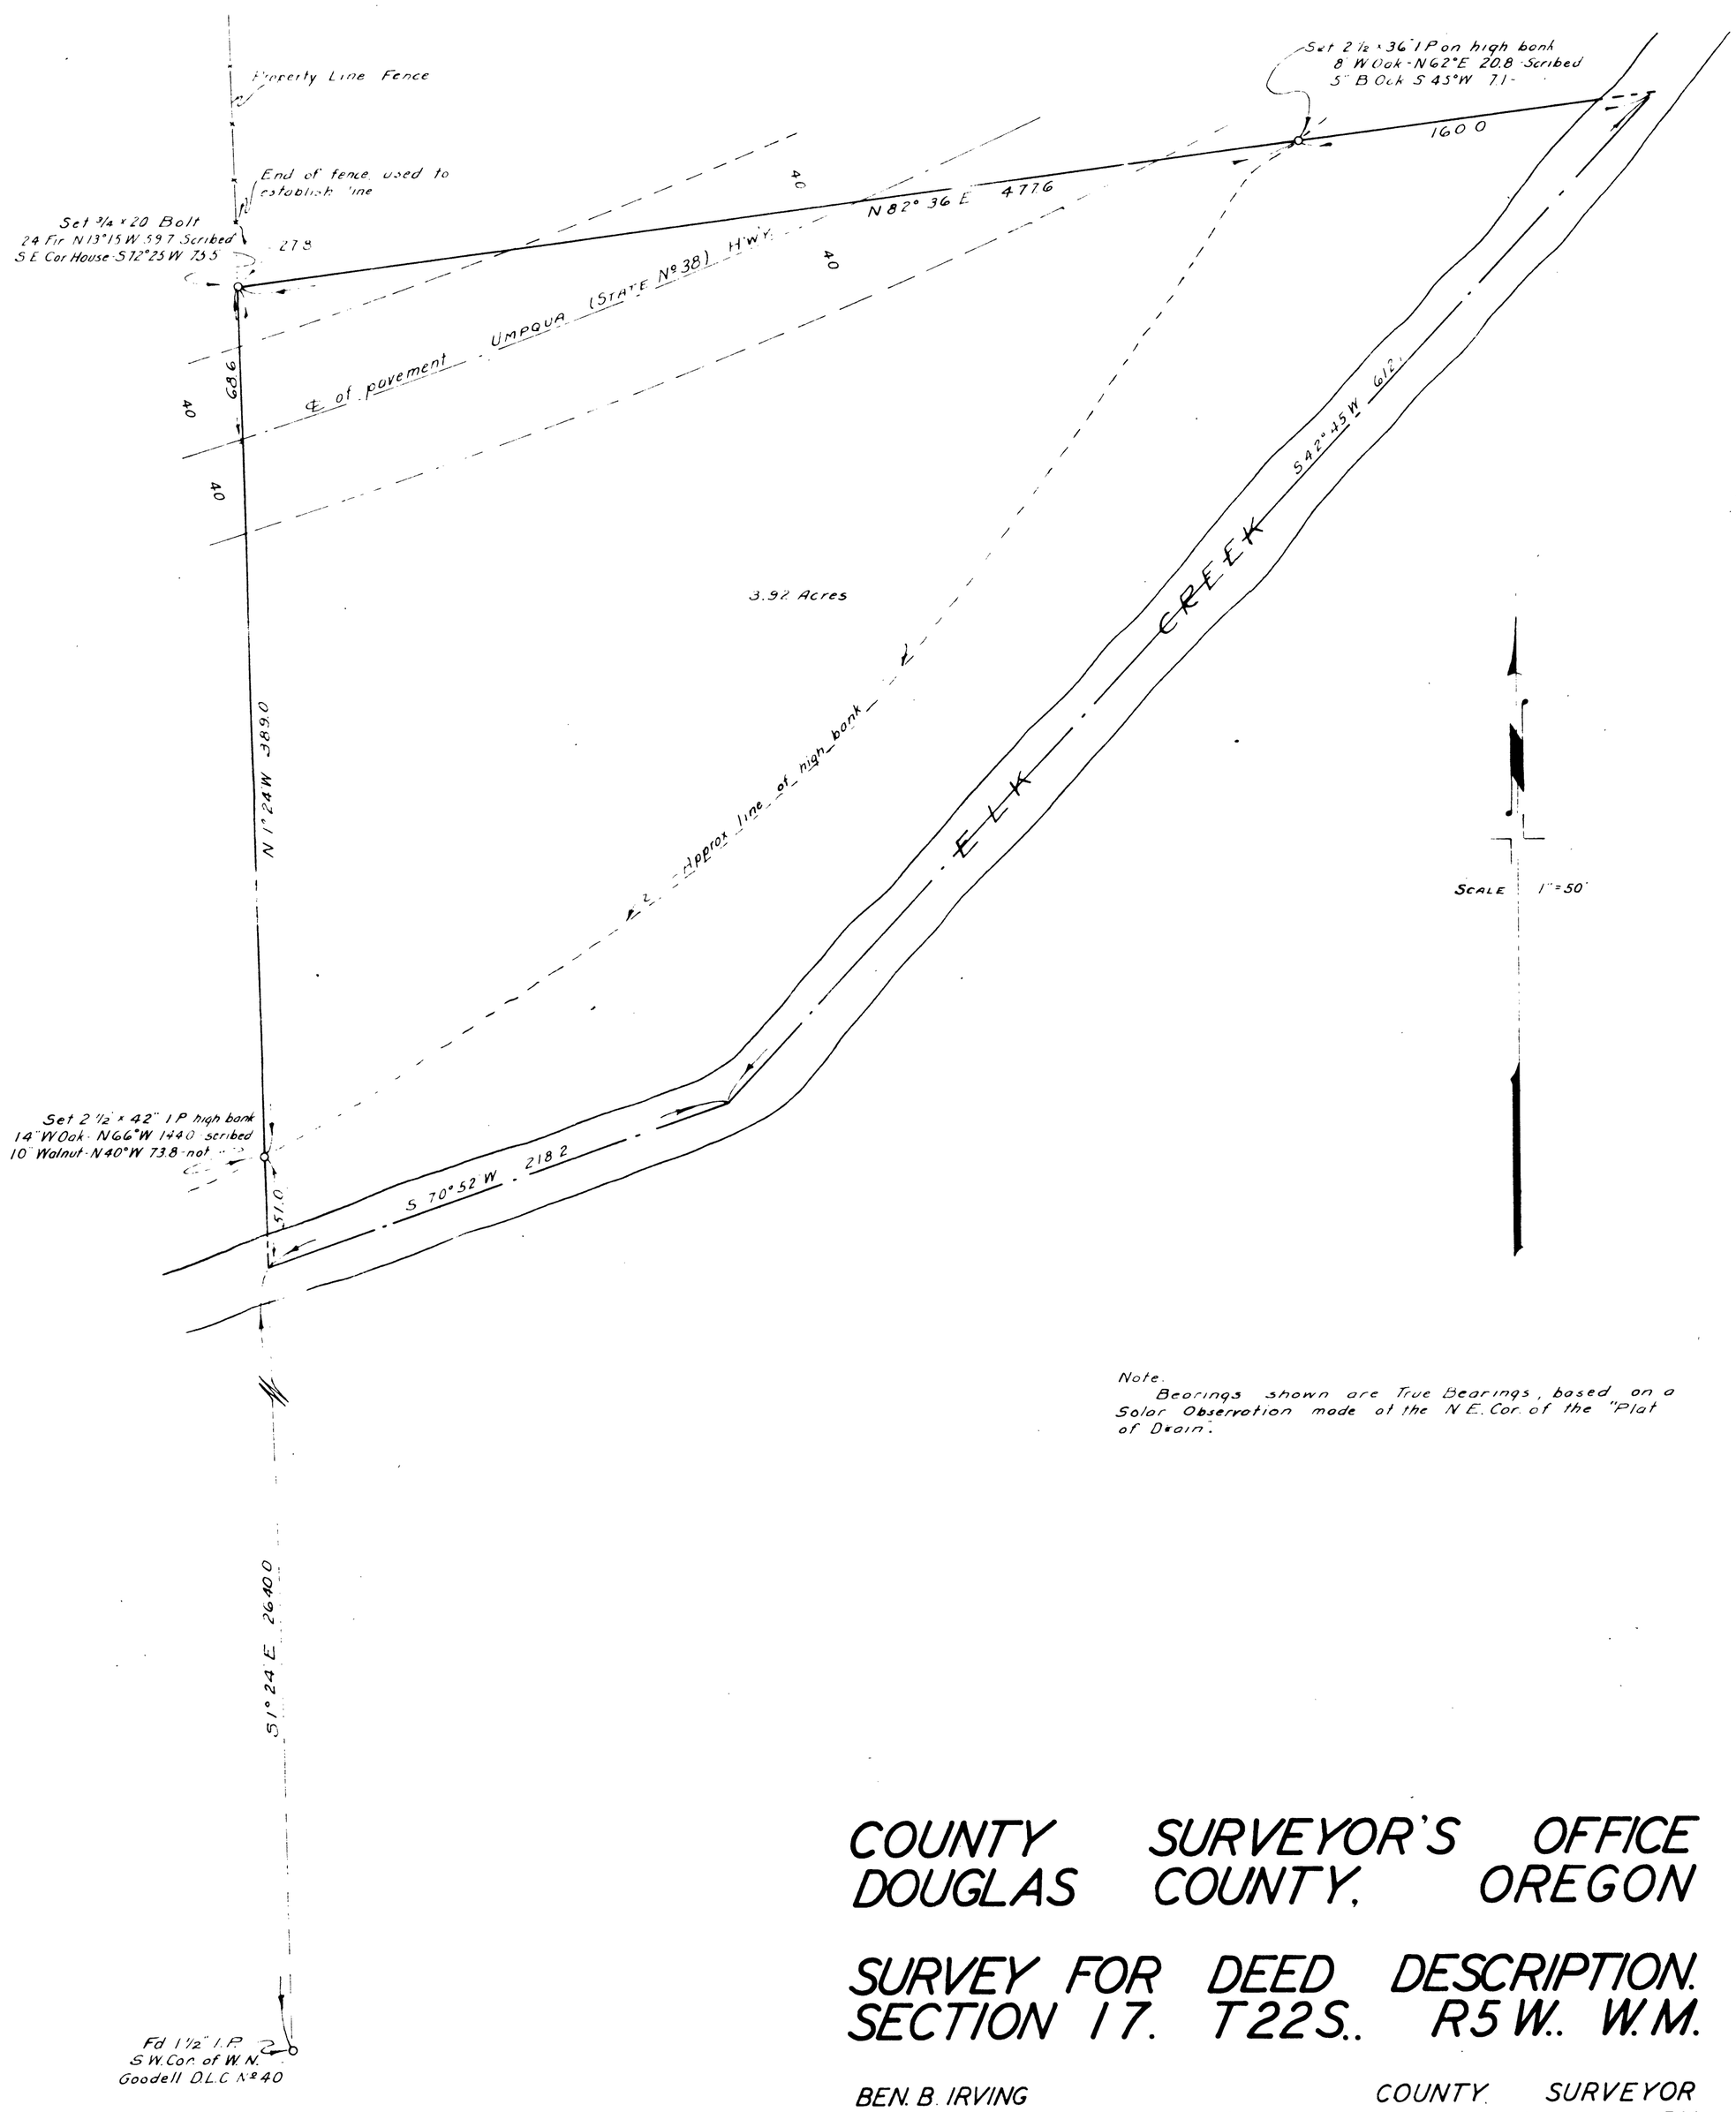

Note:
Bearings shown are True Bearings, based on a Solar Observation made at the N.E. Cor. of the "Plat of Drain".

COUNTY SURVEYOR'S OFFICE
DOUGLAS COUNTY, OREGON

SURVEY FOR DEED DESCRIPTION.
SECTION 17. T22S., R5W., W.M.

BEN. B. IRVING — COUNTY SURVEYOR
SURVEYED DECEMBER. 1948 — BY
Arthur R. Evans — A.R. EVANS — DEPUTY