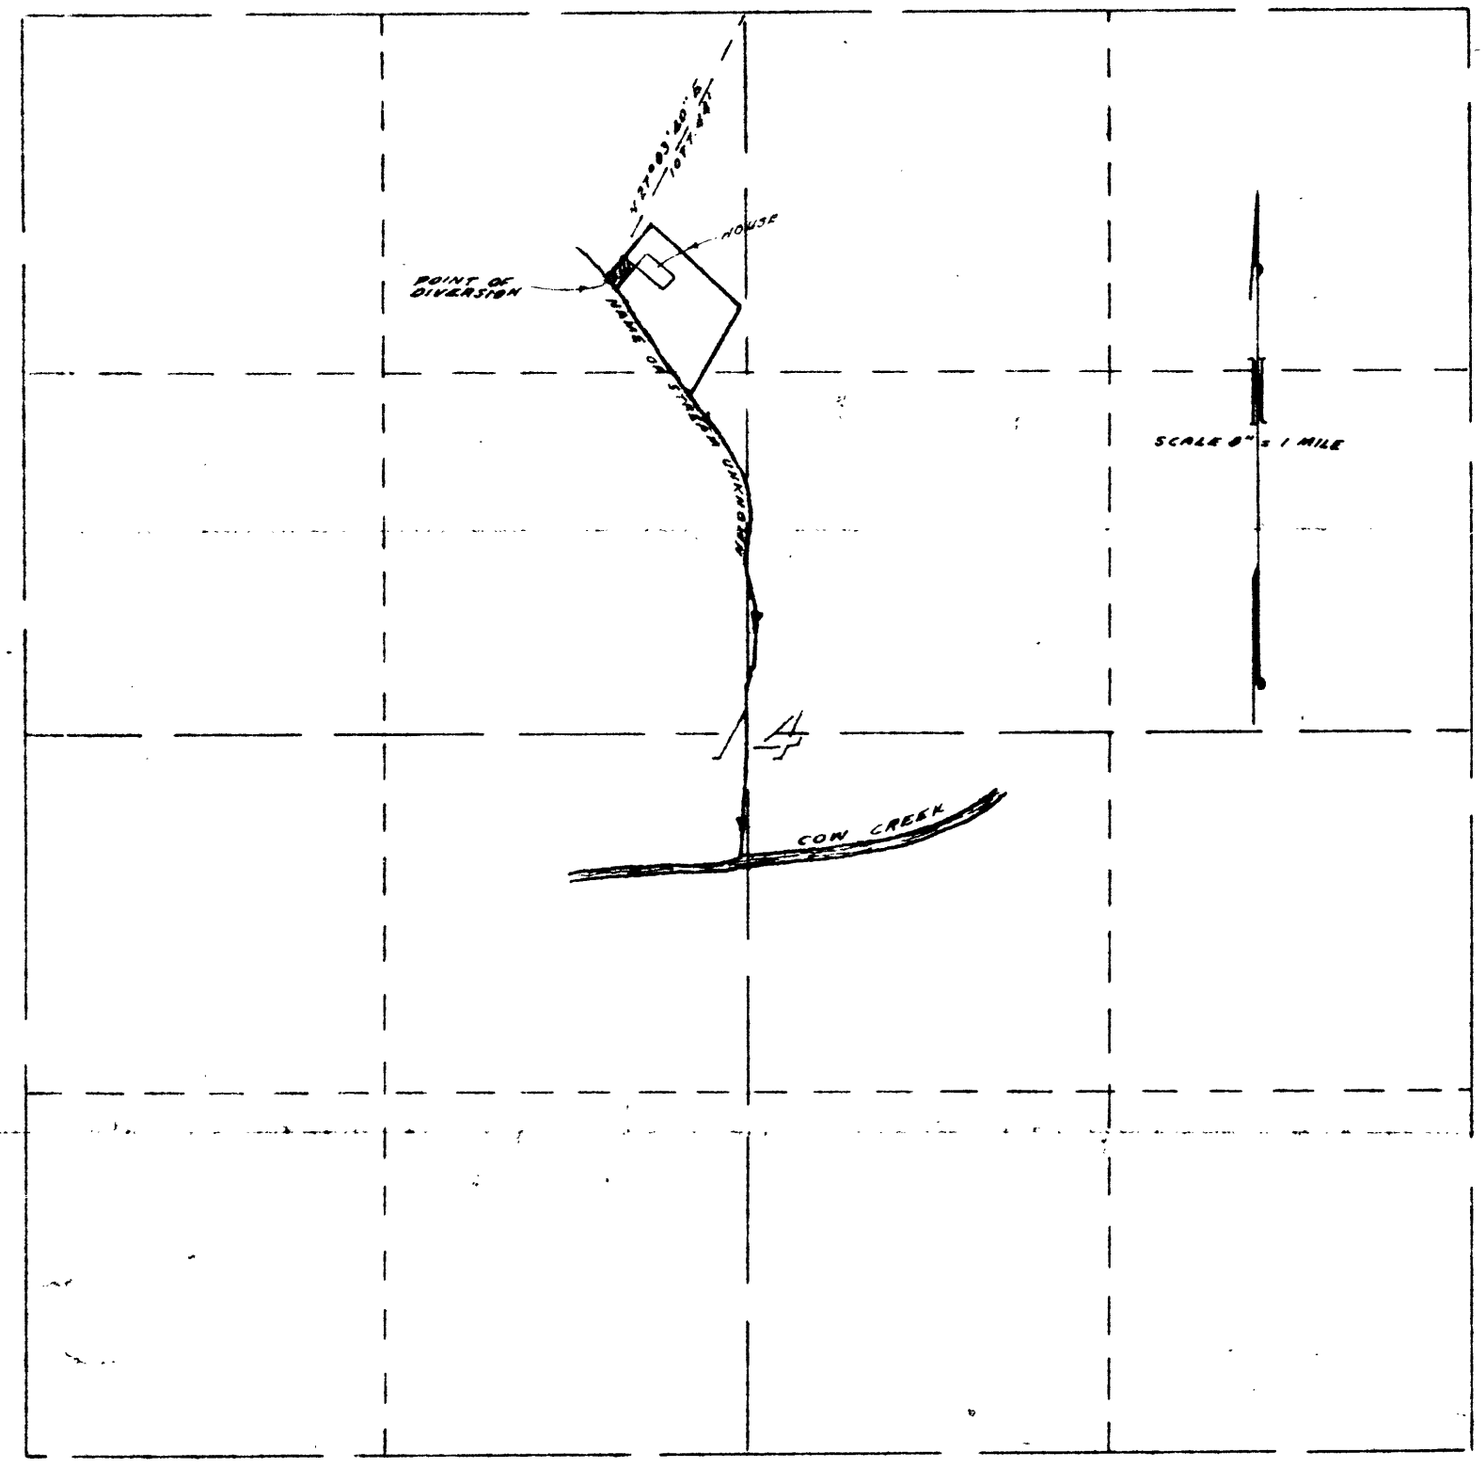

WATER RIGHT
FOR
H. F. ROBERTS
SECTION 14, T32S., R5W, W.M.

OFFICE OF
FRED M. DARBY
COUNTY SURVEYOR, DOUGLAS COUNTY
ROSEBURG, OREGON

C. S. File No. 48/2902

DOMESTIC ONLY