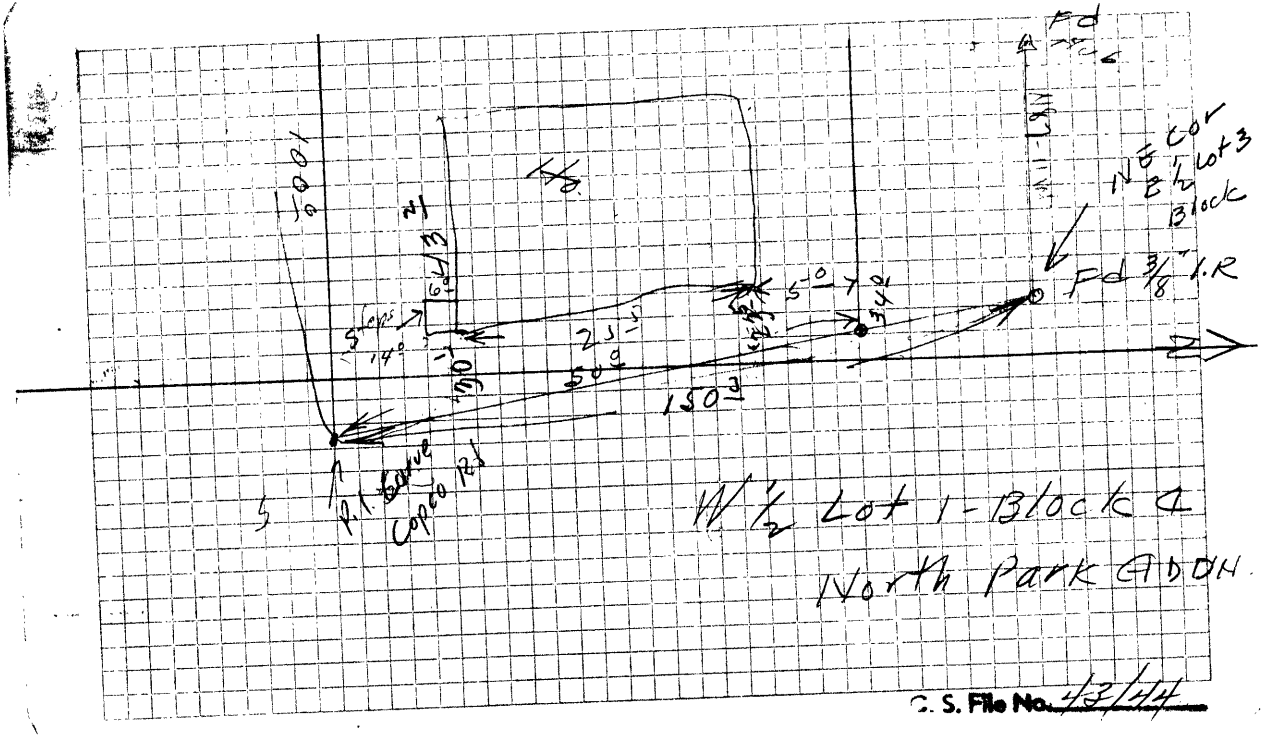

C. S. File No. 43/44