MAP

SHOWING LOCATION OF
RESIDENCE ON & BOUNDARIES OF
E'LY 85º FT. LOT 3 BLOCK 2
PINKERTON'S HOMESITES
IN THE
COUNTY OF DOUGLAS
AND
STATE OF OREGON

SURVEYED 12-10-49 SCALE 1" = 30'

I HEREBY CERTIFY THAT I HAVE SURVEYED THE ABOVE DESCRIBED PROPERTY, AND THAT THE IMPROVEMENTS SHOWN AND DESCRIBED HEREON ARE WITHIN THE PROPERTY LINES.

REGISTERED PROFESSIONAL ENGINEER 2741 OREGON NOV. 7, 1947 ARTHUR R. EVANS

Arthur R. Evans

ARTHUR R. EVANS
DEPUTY COUNTY SURVEYOR

COUNTY SURVEYORS FILE DATA
DO NOT REMOVE FROM OFFICE

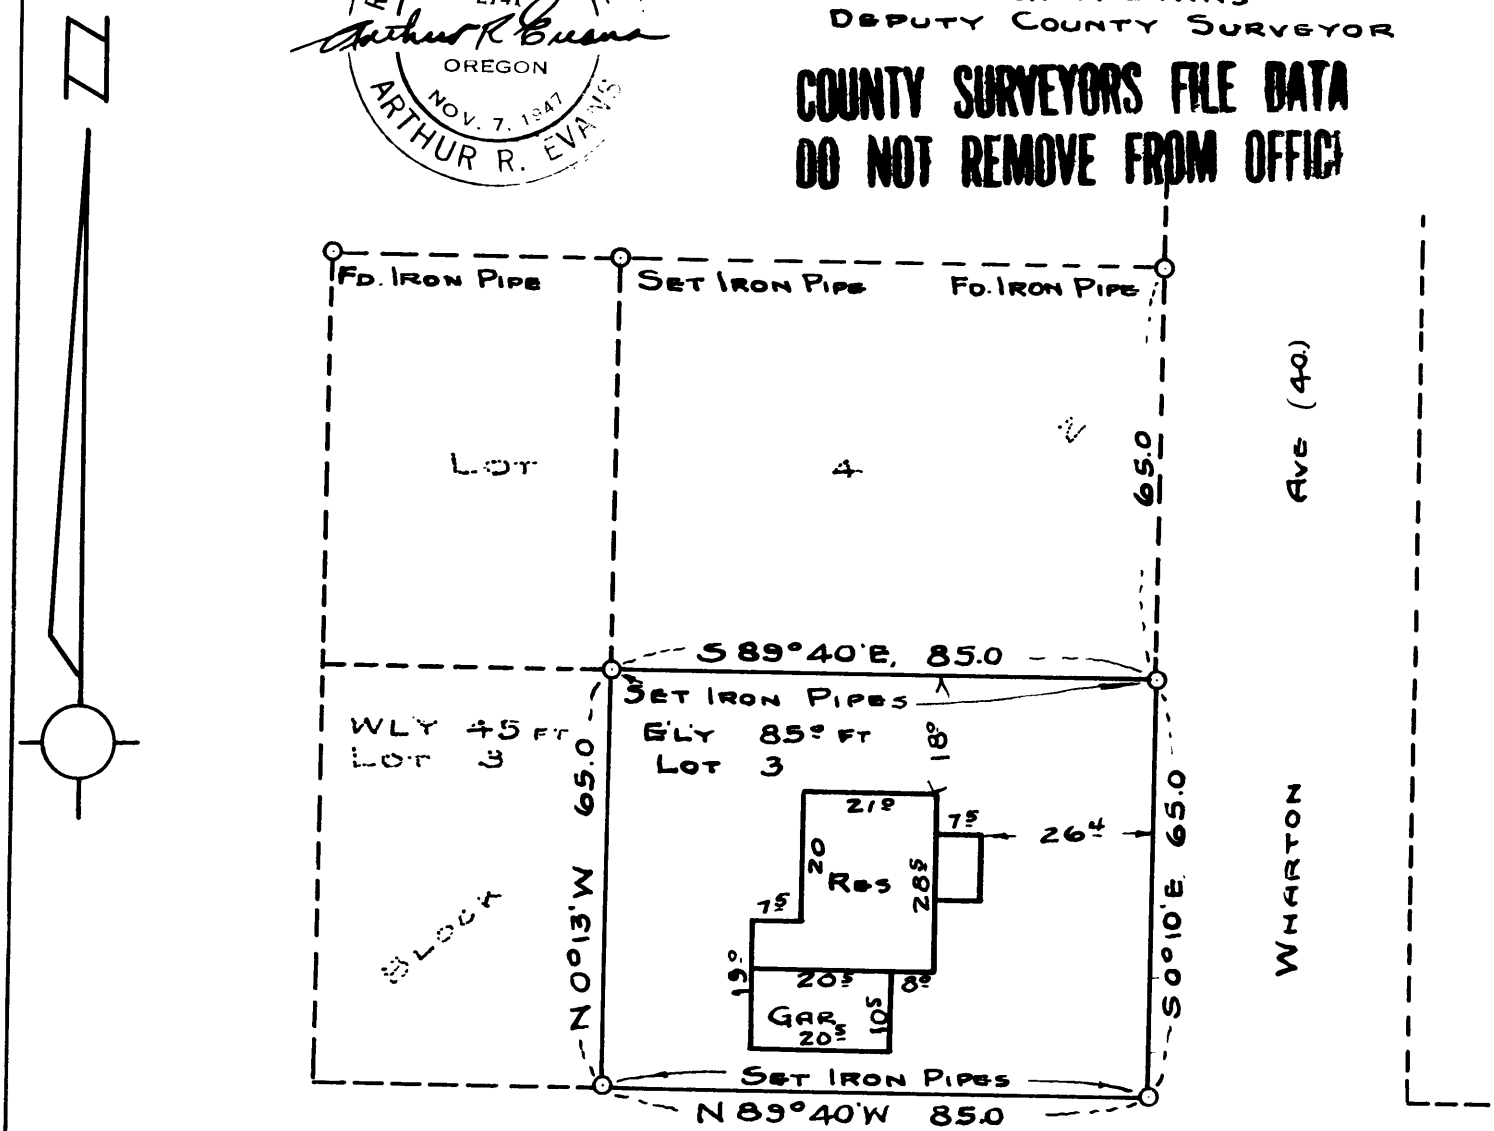

CS 43/45-2

5

FILE 45-2 DRAWER 43