MAP

SHOWING LOCATION OF RESIDENCE ON & BOUNDARIES OF LOT 3, & S'LY 5' OF LOT 4, CLOAKES FERRY, IN THE ↑ BLOCK 6, COUNTY OF DOUGLAS AND STATE OF OREGON

SURVEYED 11-18-49 SCALE 1"=40'

I hereby certify that I have surveyed the above described property and that the improvements shown and described hereon are within the property lines.

REGISTERED OREGON LAND SURVEYOR

N E Richardson
JULY 7, 1944
N. E. RICHARDSON
35

N E Richardson
N.E. Richardson
Deputy County Surveyor.

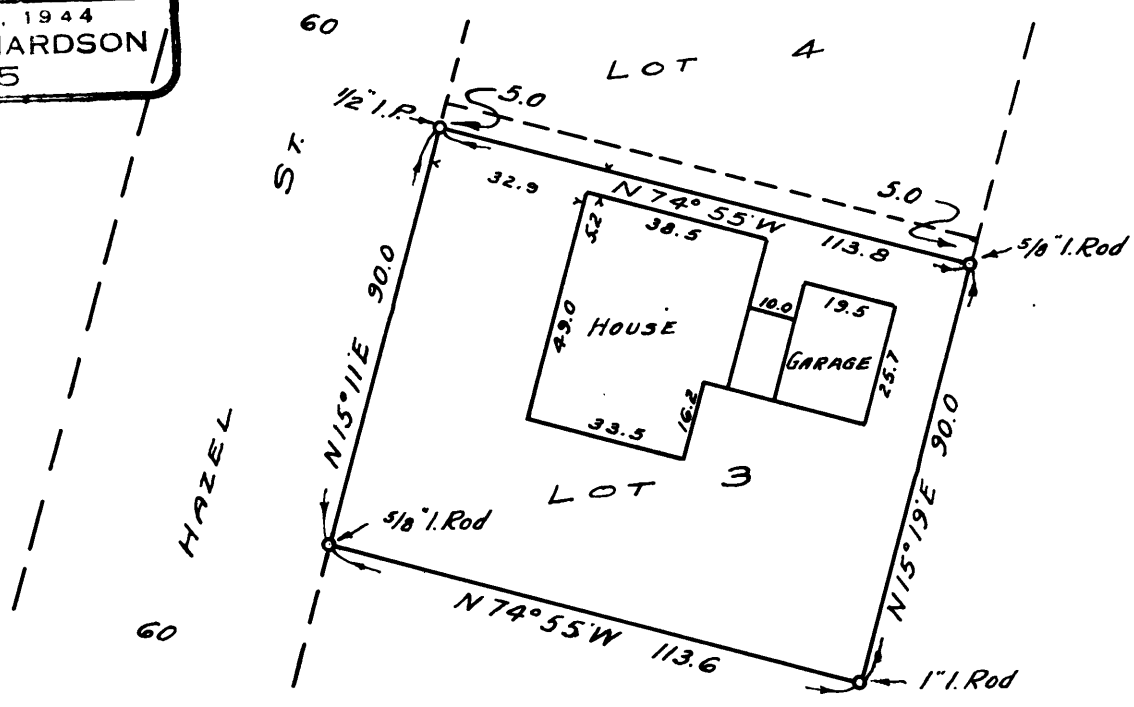

COUNTY SURVEYORS FILE DATA
DO NOT REMOVE FROM OFFICE

CS 43/46-2 P 4

FILE #3 DRAWER #3