MAP

SHOWING LOCATION OF RESIDENCE ON & BOUNDARIES OF

LOT 7, BLOCK 2, "CLOAKE'S FERRY"

IN THE COUNTY OF DOUGLAS AND STATE OF OREGON

SURVEYED 2-20-50 SCALE 1" = 30'

I HEREBY CERTIFY THAT I HAVE SURVEYED THE ABOVE DESCRIBED PROPERTY AND THAT THE IMPROVEMENTS SHOWN AND DESCRIBED HEREON ARE WITHIN THE PROPERTY LINES

Arthur R. Evans

ARTHUR R. EVANS
DEPUTY COUNTY SURVEYOR

COUNTY SURVEYORS FILE DATA
DO NOT REMOVE FROM OFFICE

REGISTERED PROFESSIONAL ENGINEER
2741
OREGON
NOV. 7, 1947
ARTHUR R. EVANS

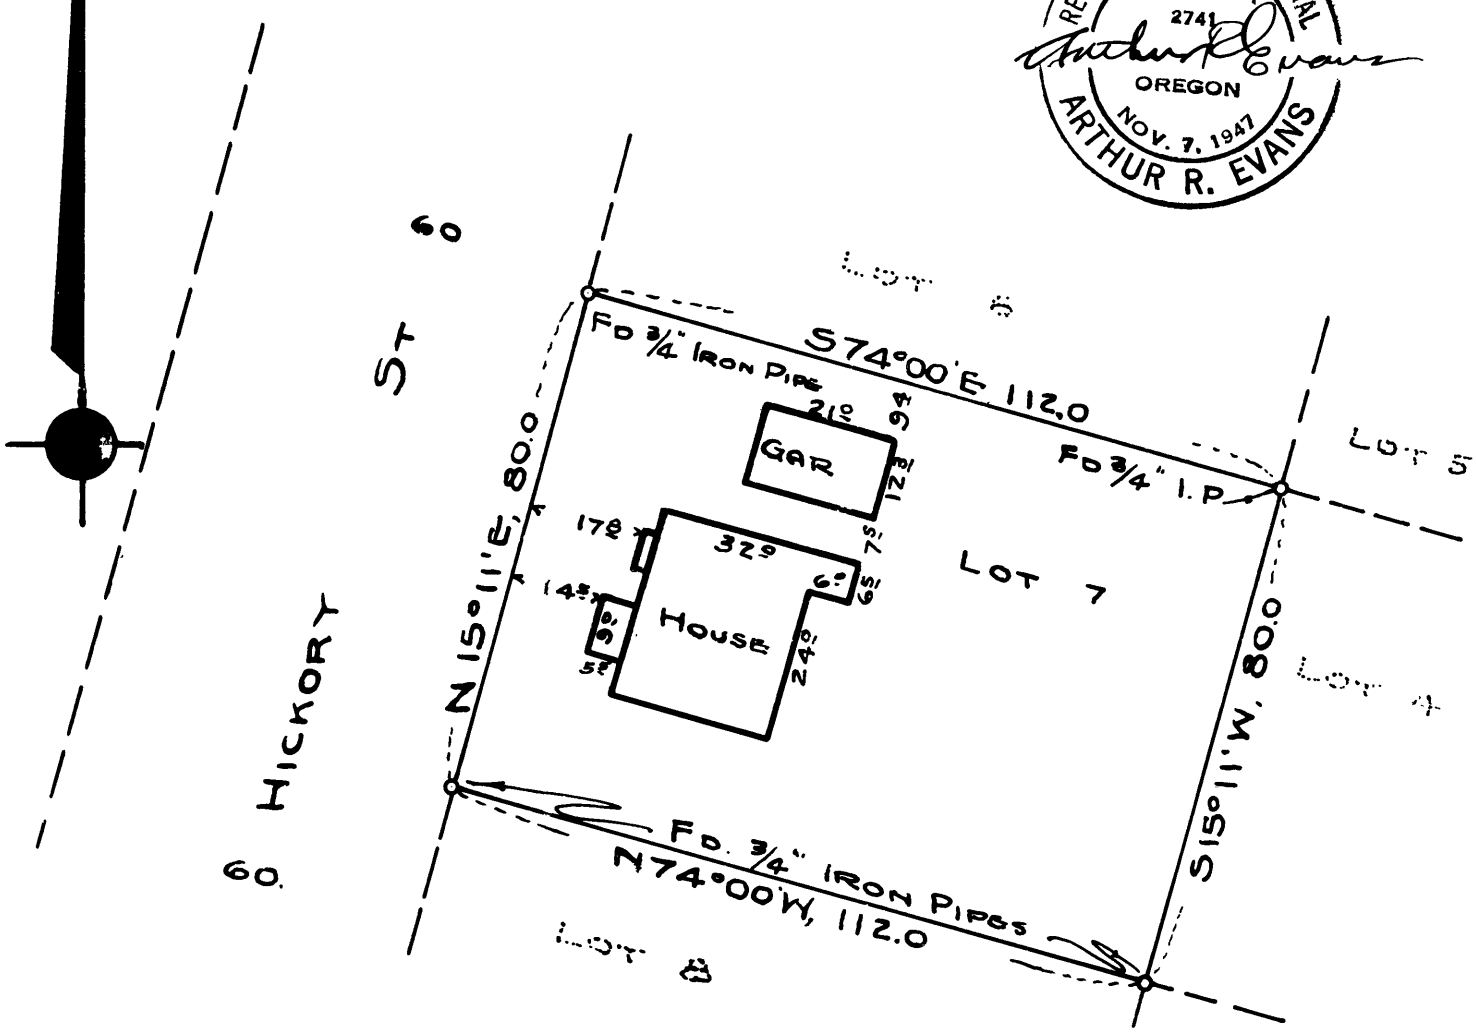

CS 43/46-6

FILE 46 DRAWER 43