MAP

SHOWING LOCATION OF
RESIDENCE ON & BOUNDARIES OF

LOT 9, BLOCK 2, BEULAH ADDITION TO ROSEBURG

IN THE
COUNTY OF DOUGLAS
AND
STATE OF OREGON

SURVEYED, 8-26-49 SCALE 1" = 40'

I HEREBY CERTIFY THAT I HAVE SURVEYED THE ABOVE DESCRIBED PROPERTY, AND THAT THE IMPROVEMENTS SHOWN AND DESCRIBED HEREON ARE WITHIN THE PROPERTY LINES

COUNTY SURVEYORS FILE DATA
DO NOT REMOVE FROM OFFICE

Arthur R. Evans

ARTHUR R. EVANS
DEPUTY COUNTY SURVEYOR

REGISTERED PROFESSIONAL ENGINEER
ARTHUR R. EVANS
OREGON
NOV. 7, 1941

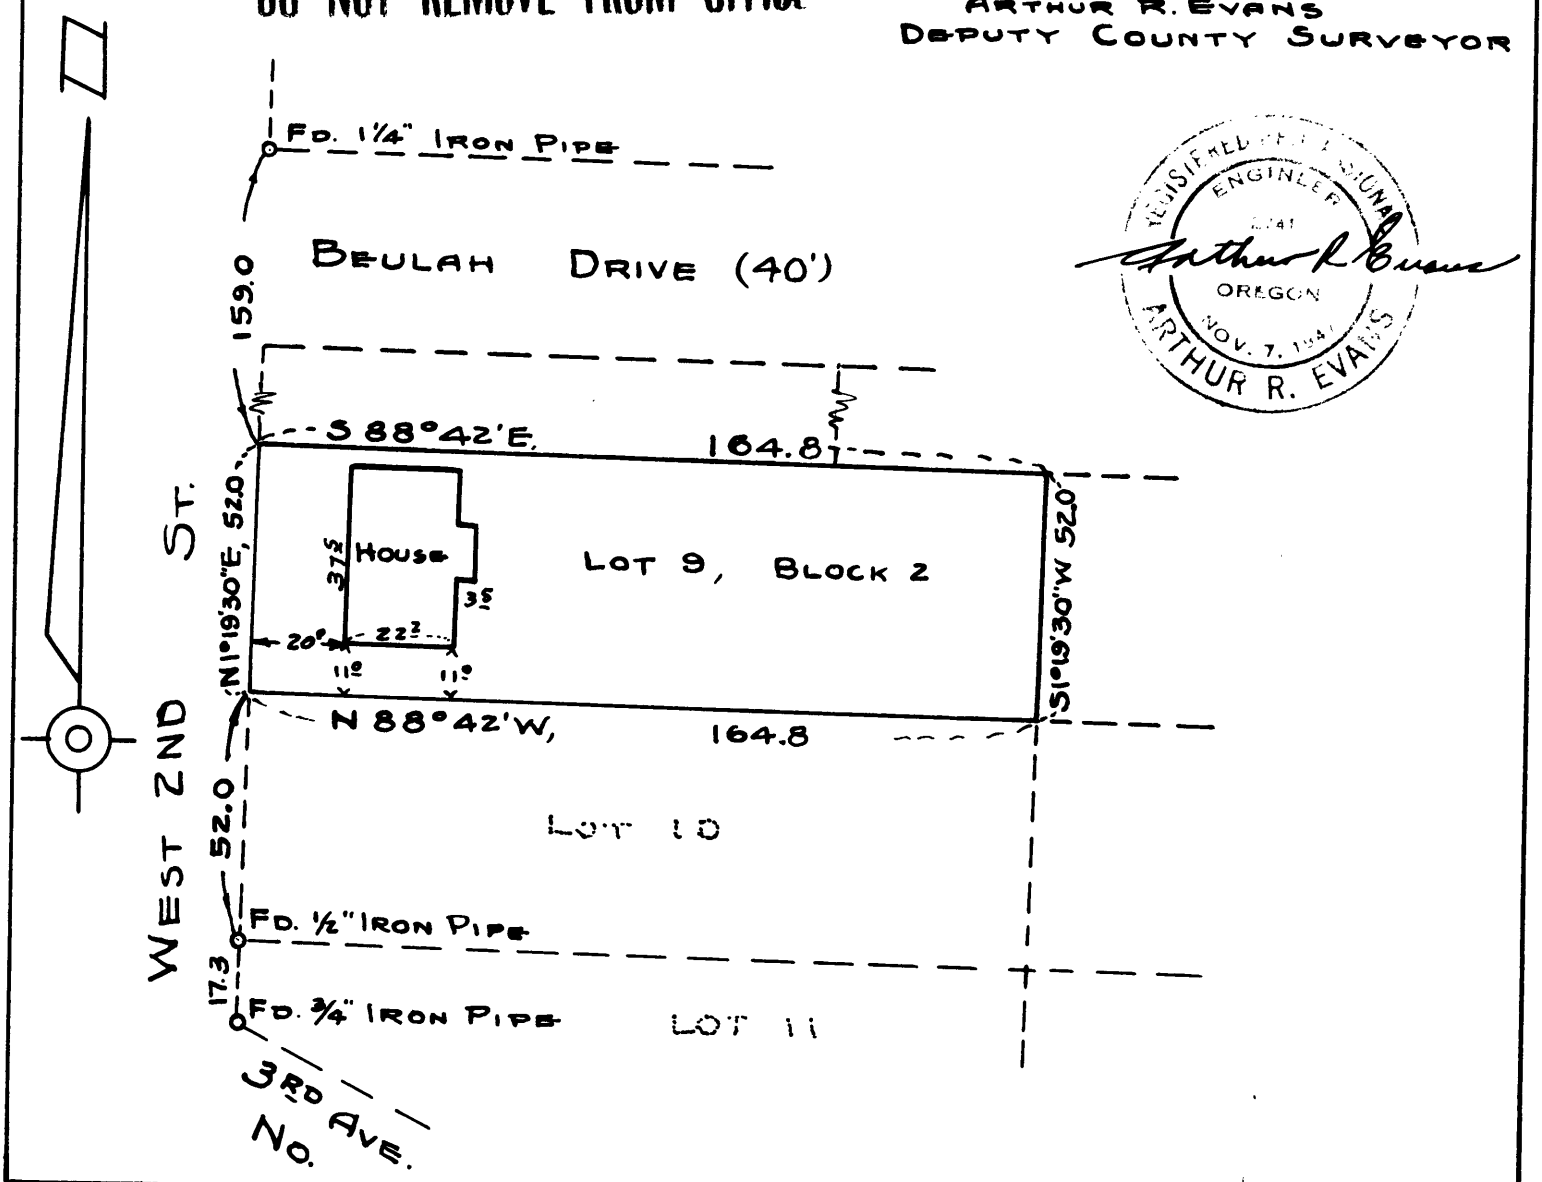

43/48 — 1

FILE 48-1 DRAWER 43 4