COUNTY SURVEYOR'S OFFICE
DOUGLAS COUNTY OREGON
SURVEY FOR DEED DESCRIPTIONS
SECTION 30, T21S., R4W. WM.

BEN B. IRVING COUNTY SURVEYOR
SURVEYED, MARCH 1949 BY
A.R. EVANS, DEPUTY COUNTY SURVEYOR

REGISTERED PROFESSIONAL ENGINEER
2741
Arthur R. Evans
OREGON
NOV. 7, 1947
ARTHUR R. EVANS

COUNTY SURVEYORS FILE DATA
DO NOT REMOVE FROM OFFICE

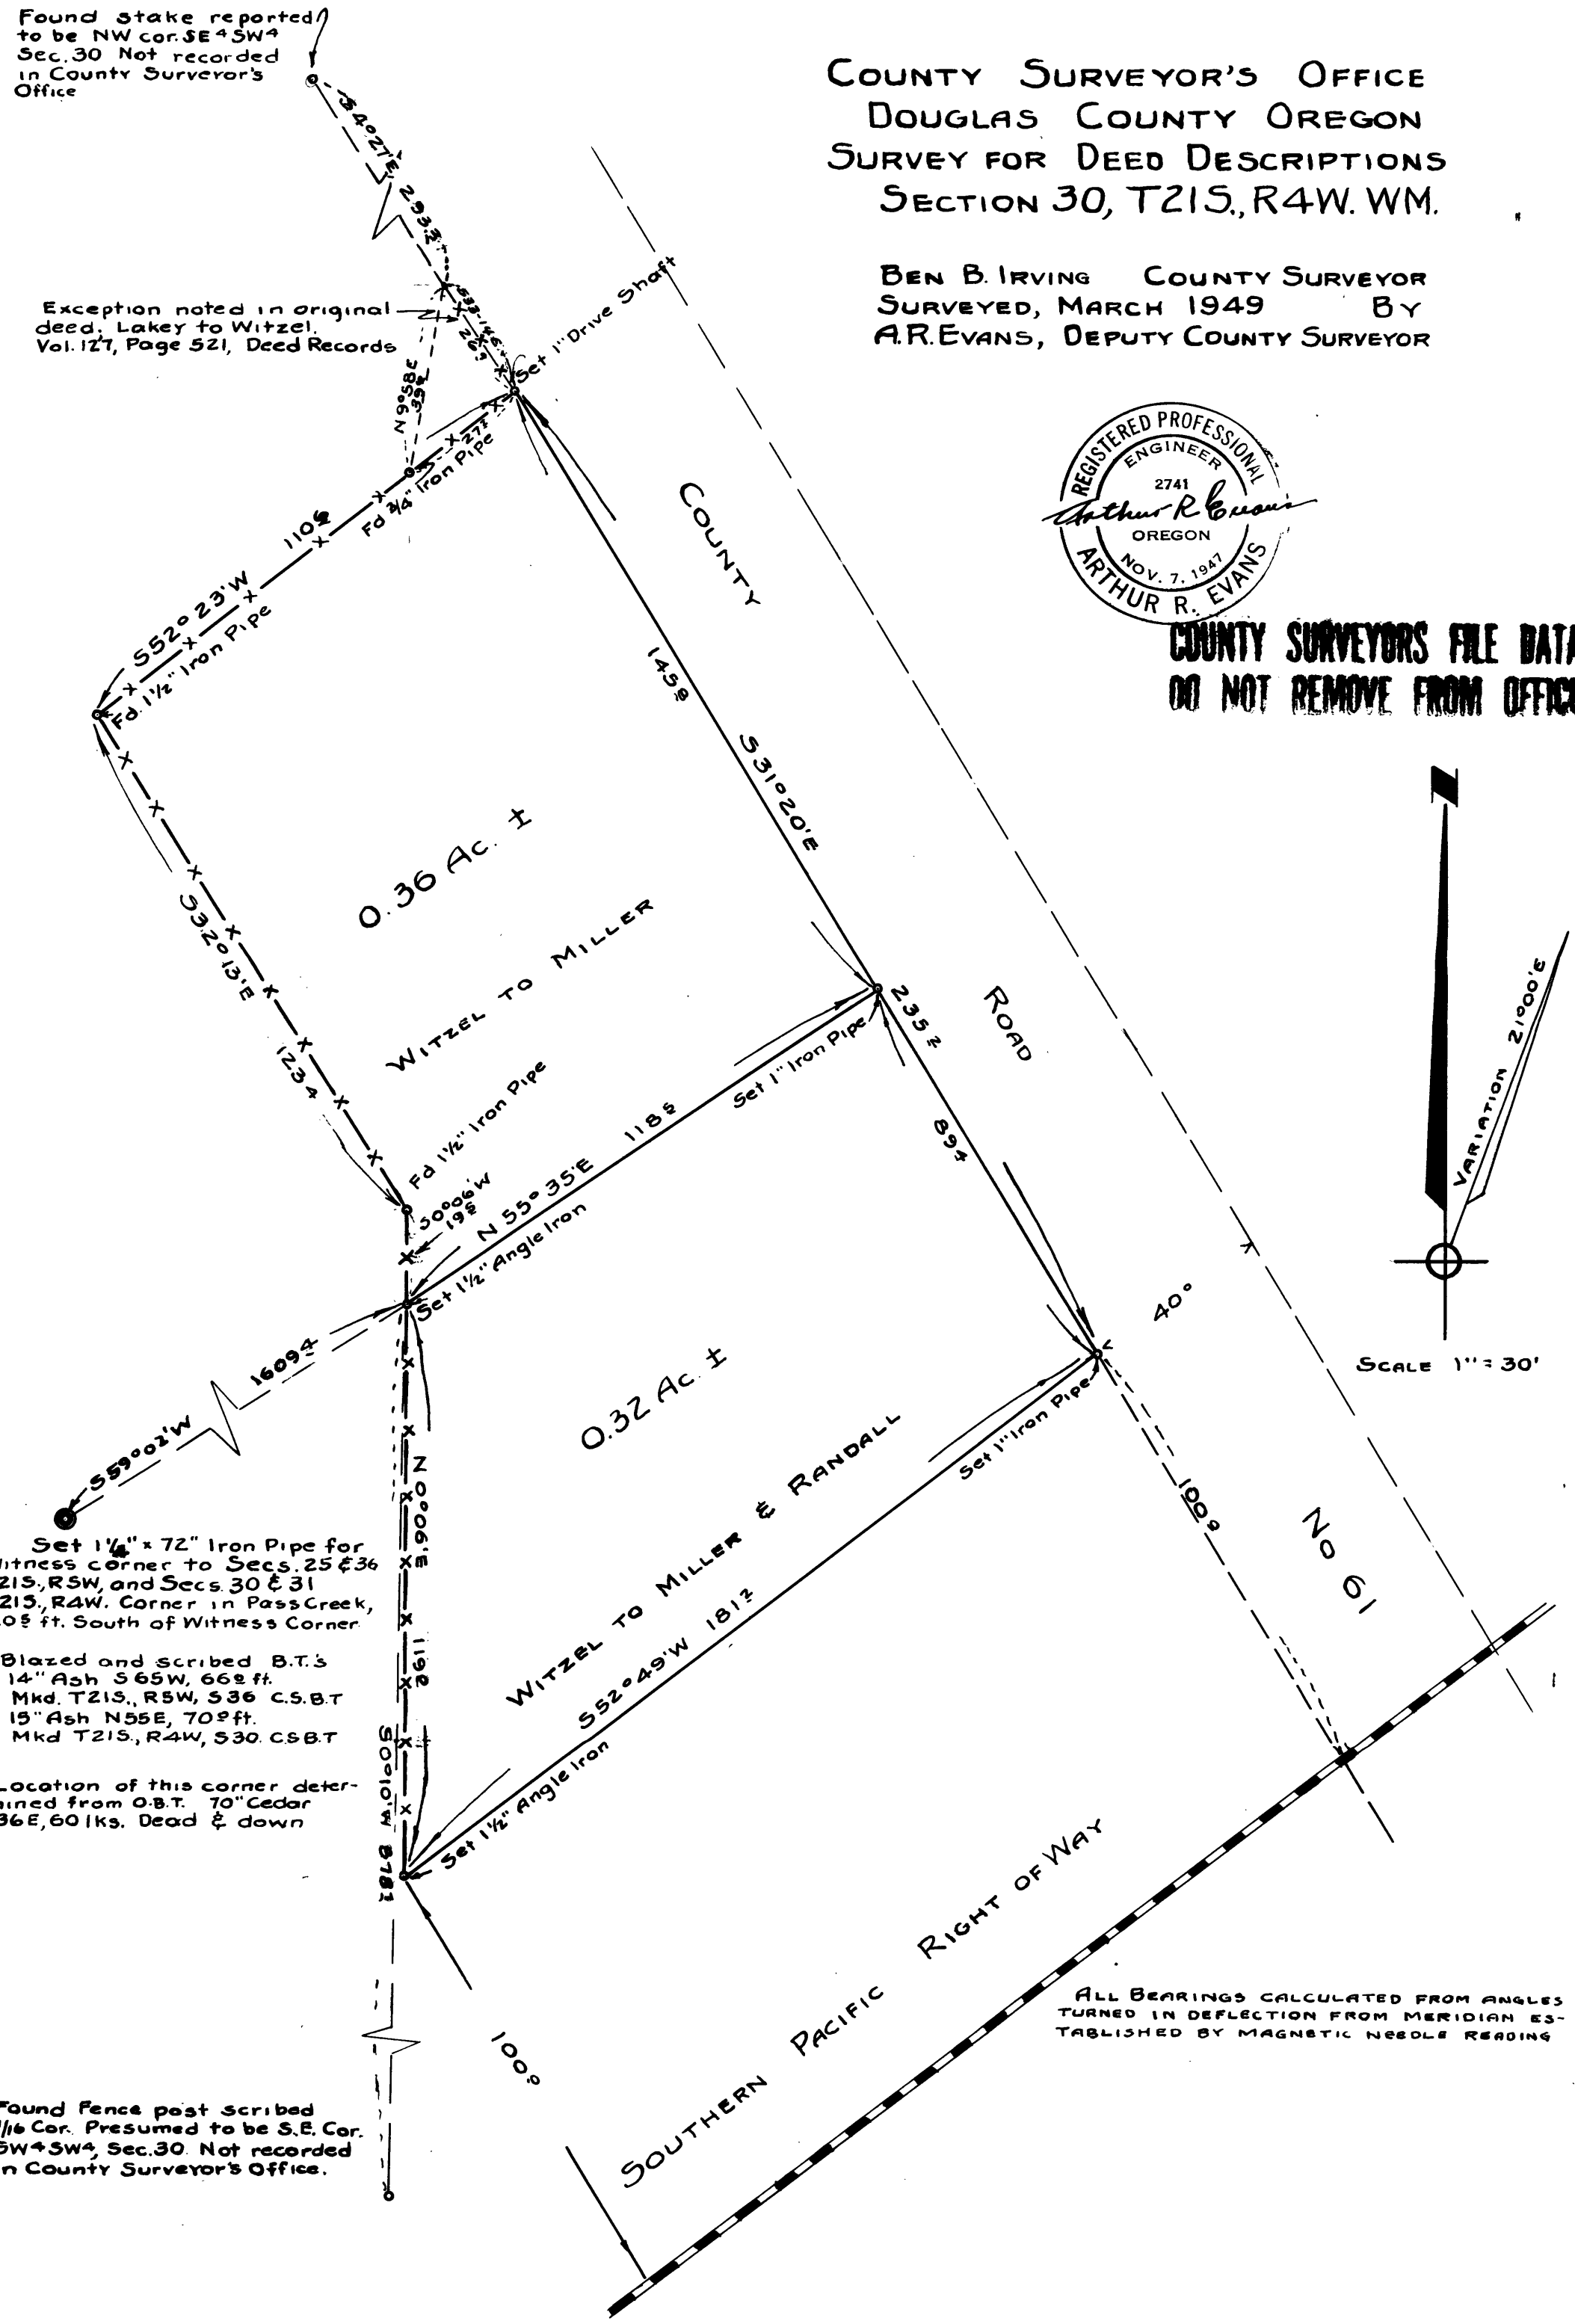

Set 1¼" x 72" Iron Pipe for Witness corner to Secs. 25 & 36 T21S., R5W, and Secs. 30 & 31 T21S., R4W. Corner in Pass Creek, 20' ft. South of Witness Corner.

Blazed and scribed B.T.'s
14" Ash S 65W, 66' ft.
Mkd. T21S., R5W, S36 C.S.B.T
15" Ash N55E, 70' ft.
Mkd T21S., R4W, S30. C.S.B.T

Location of this corner determined from O.B.T. 70" Cedar S36E, 60 lks. Dead & down

Found Fence post scribed 1/16 Cor. Presumed to be S.E. Cor. SW¼SW¼, Sec. 30. Not recorded in County Surveyor's Office.

ALL BEARINGS CALCULATED FROM ANGLES TURNED IN DEFLECTION FROM MERIDIAN ESTABLISHED BY MAGNETIC NEEDLE READING

FILE 76 DRAWER 43