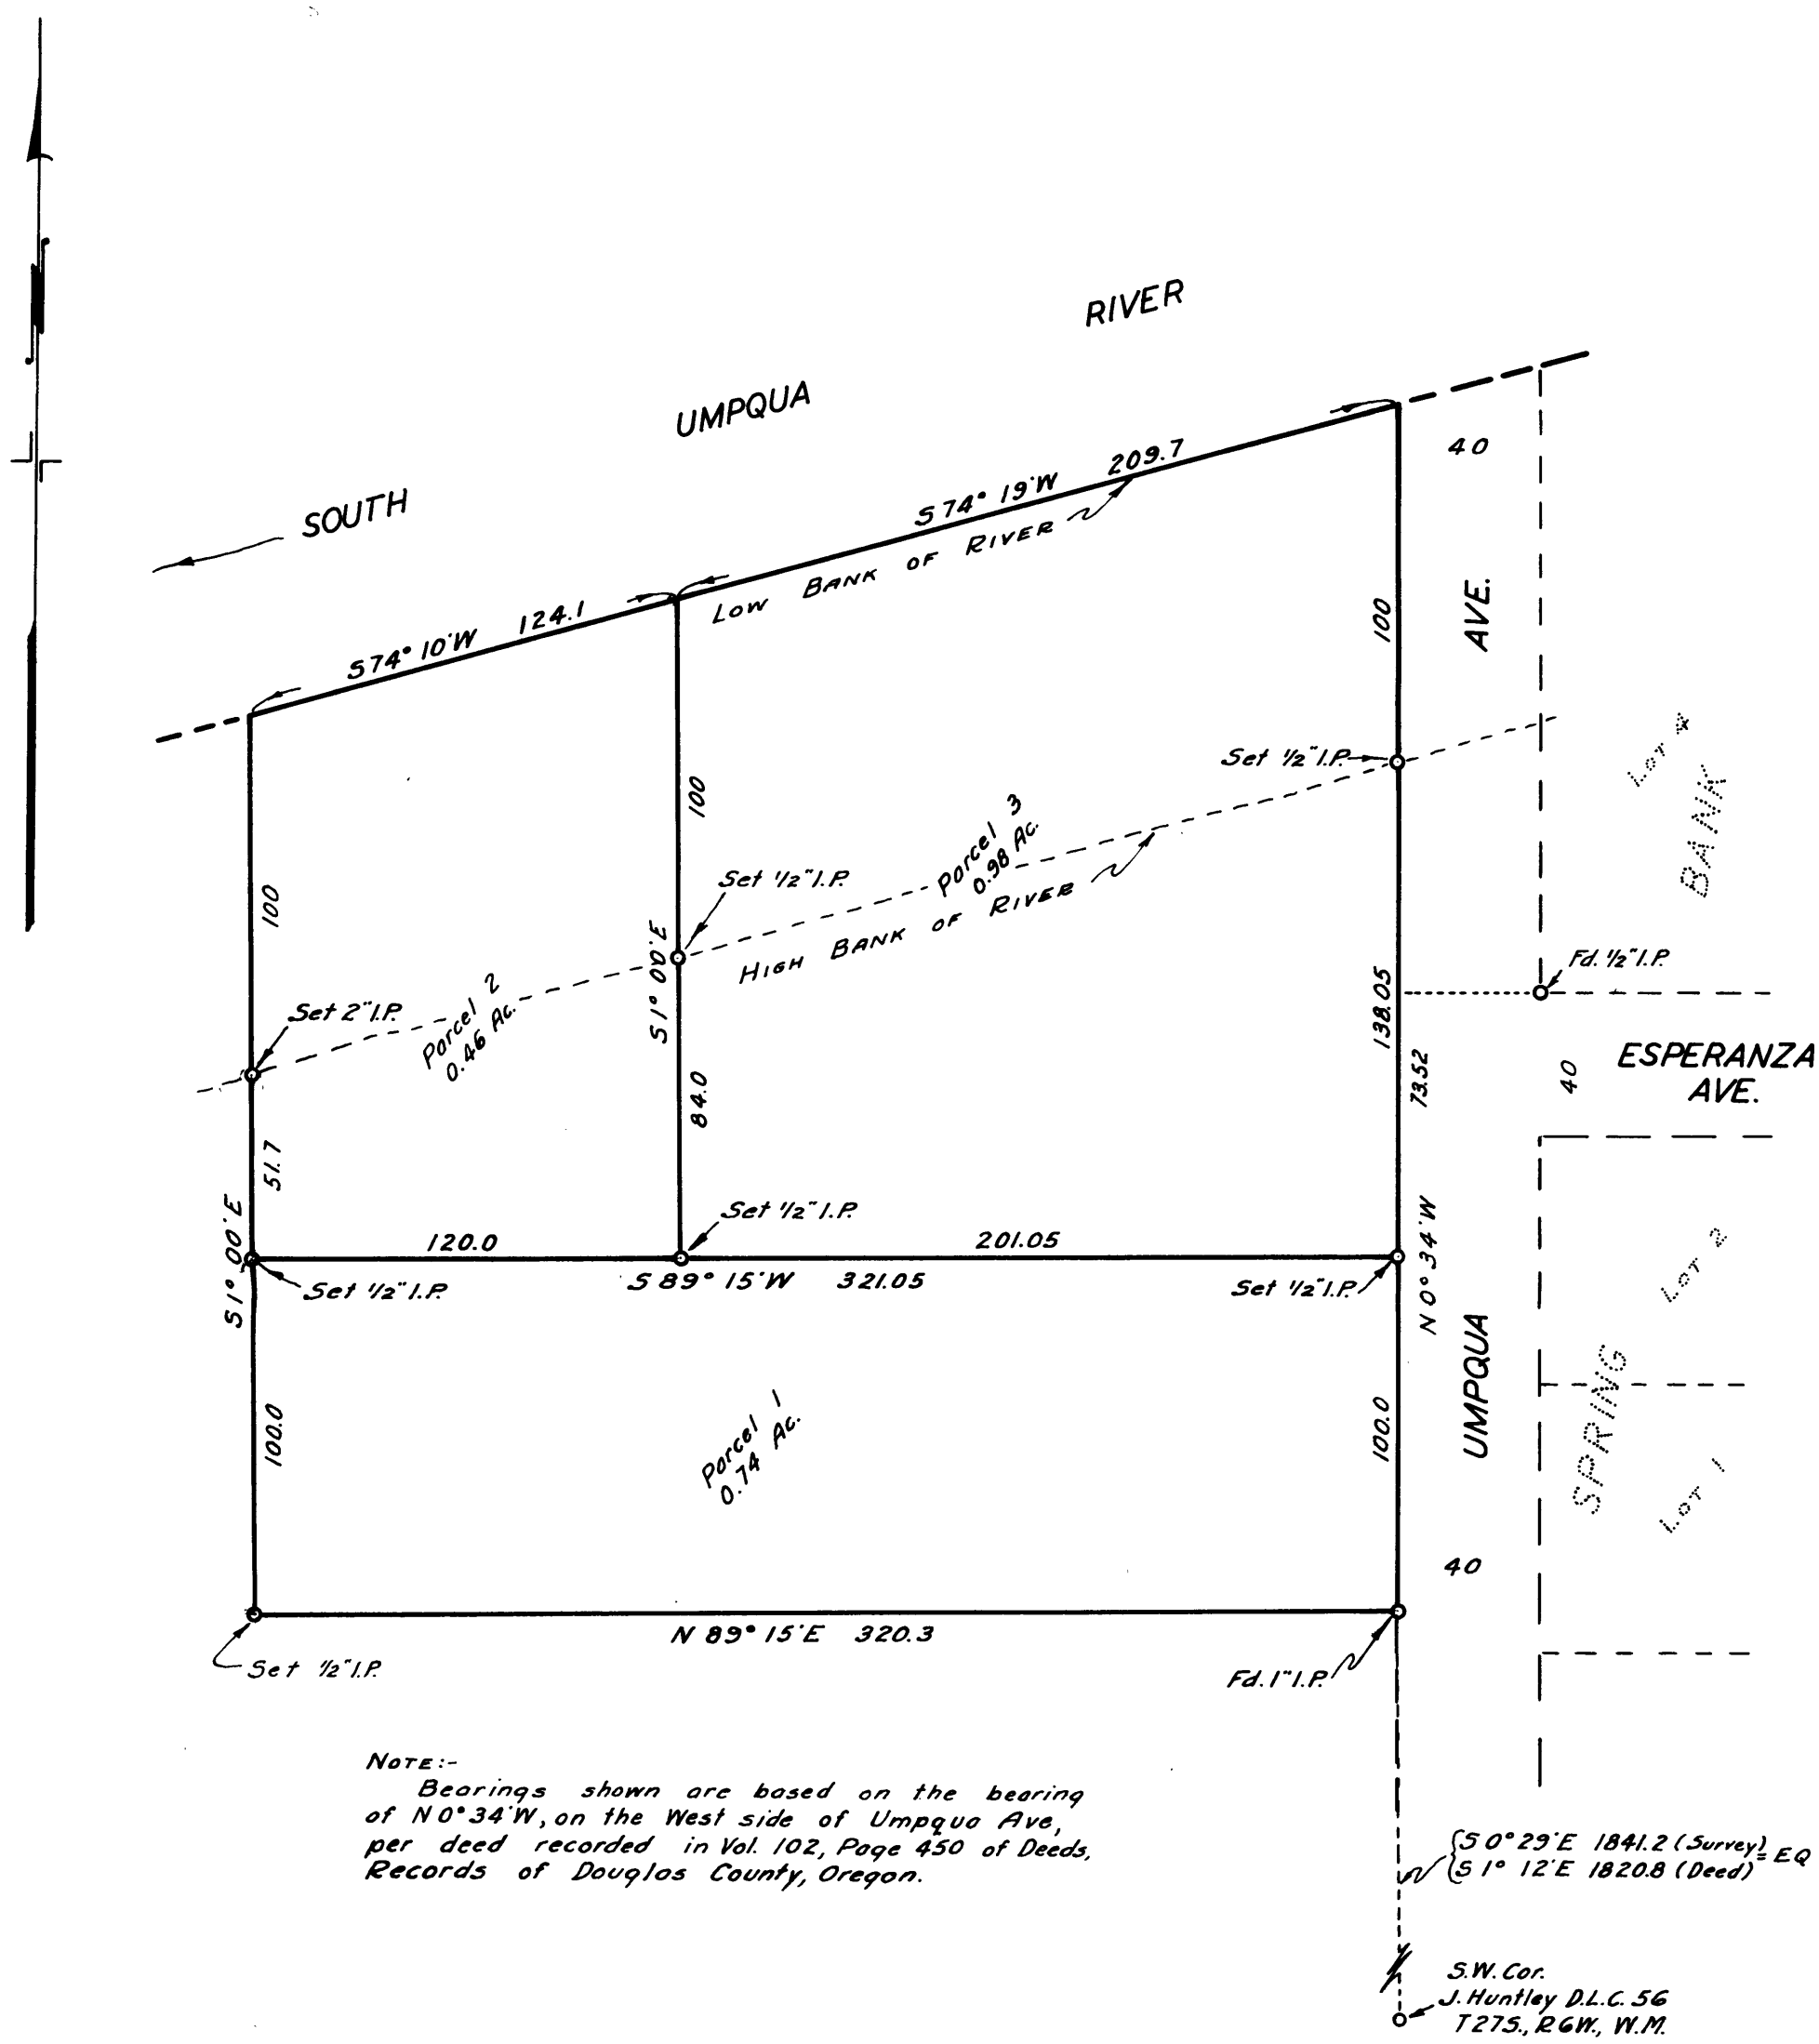

NOTE:-
Bearings shown are based on the bearing of N 0° 34'W, on the West side of Umpqua Ave, per deed recorded in Vol. 102, Page 450 of Deeds, Records of Douglas County, Oregon.

COUNTY SURVEYORS FILE DATA
DO NOT REMOVE FROM OFFICE

COUNTY SURVEYOR'S OFFICE
DOUGLAS COUNTY, OREGON.

SURVEY FOR DEED DESCRIPTION.
IN WEST ROSEBURG.

BEN. B. IRVING COUNTY SURVEYOR
SURVEYED APRIL 13. 1949 BY
N.E. RICHARDSON DEPUTY

SCALE 1" = 50'

REGISTERED
OREGON
LAND SURVEYOR

N E Richardson

JULY 7, 1944
N. E. RICHARDSON
35

FILE 78 DRAWER 43