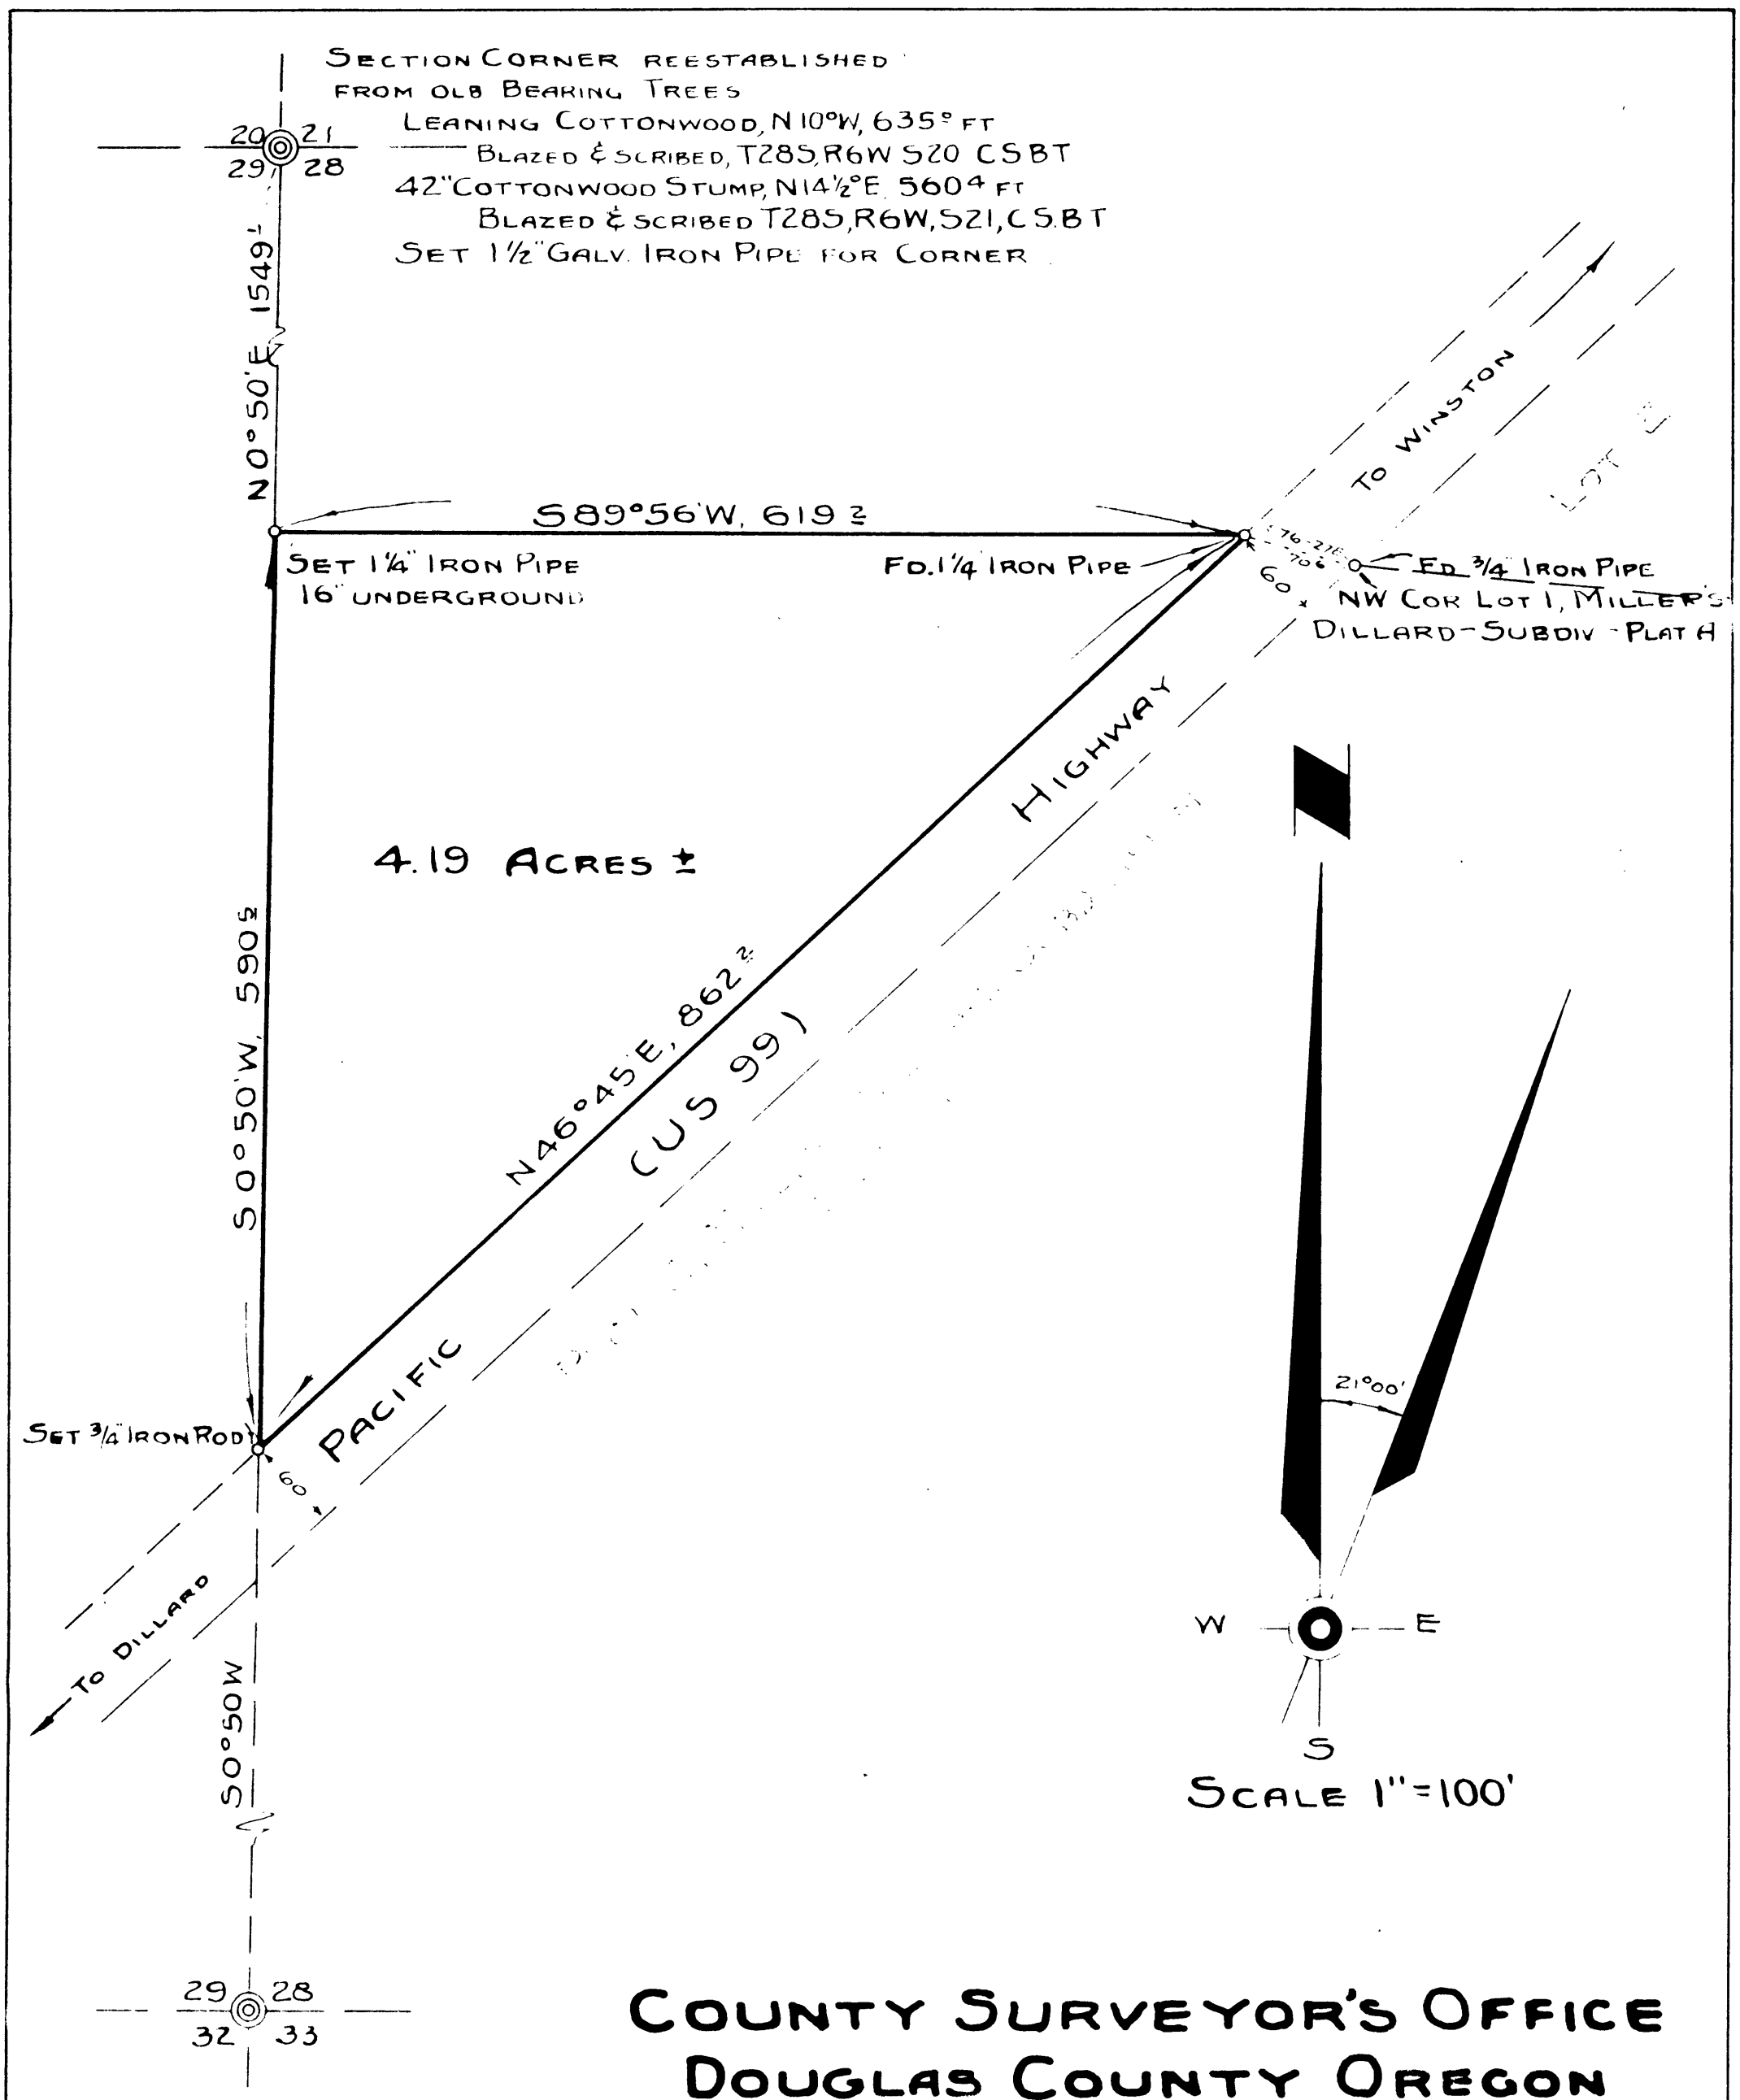

COUNTY SURVEYOR'S OFFICE
DOUGLAS COUNTY OREGON
SURVEY FOR DEED DESCRIPTION
SECTION 28, T28S., R6W. WM.

BEN B. IRVING COUNTY SURVEYOR
SURVEYED & PLATTED, MAY, 1949, BY
A.R. EVANS, DEP. COUNTY SURVEYOR

C. S. File No. 43/93