MAP

SHOWING LOCATION OF RESIDENCE ON & BOUNDARIES OF PORTIONS OF LOTS 8, & 9, BLOCK H OF AMENDED PLAT OF LAURELWOOD ADDITION,

IN THE COUNTY OF DOUGLAS AND STATE OF OREGON

SURVEYED 1-25-50 SCALE 1" = 40'

I HEREBY CERTIFY THAT I HAVE SURVEYED THE ABOVE DESCRIBED PROPERTY AND THAT THE IMPROVEMENTS SHOWN AND DESCRIBED HEREON ARE WITHIN THE PROPERTY LINES.

REGISTERED PROFESSIONAL ENGINEER 240 OREGON NOV 8. 1919 BEN B. IRVING

BEN: B. IRVING
COUNTY SURVEYOR.

COUNTY SURVEYORS FILE DATA
DO NOT REMOVE FROM OFFICE

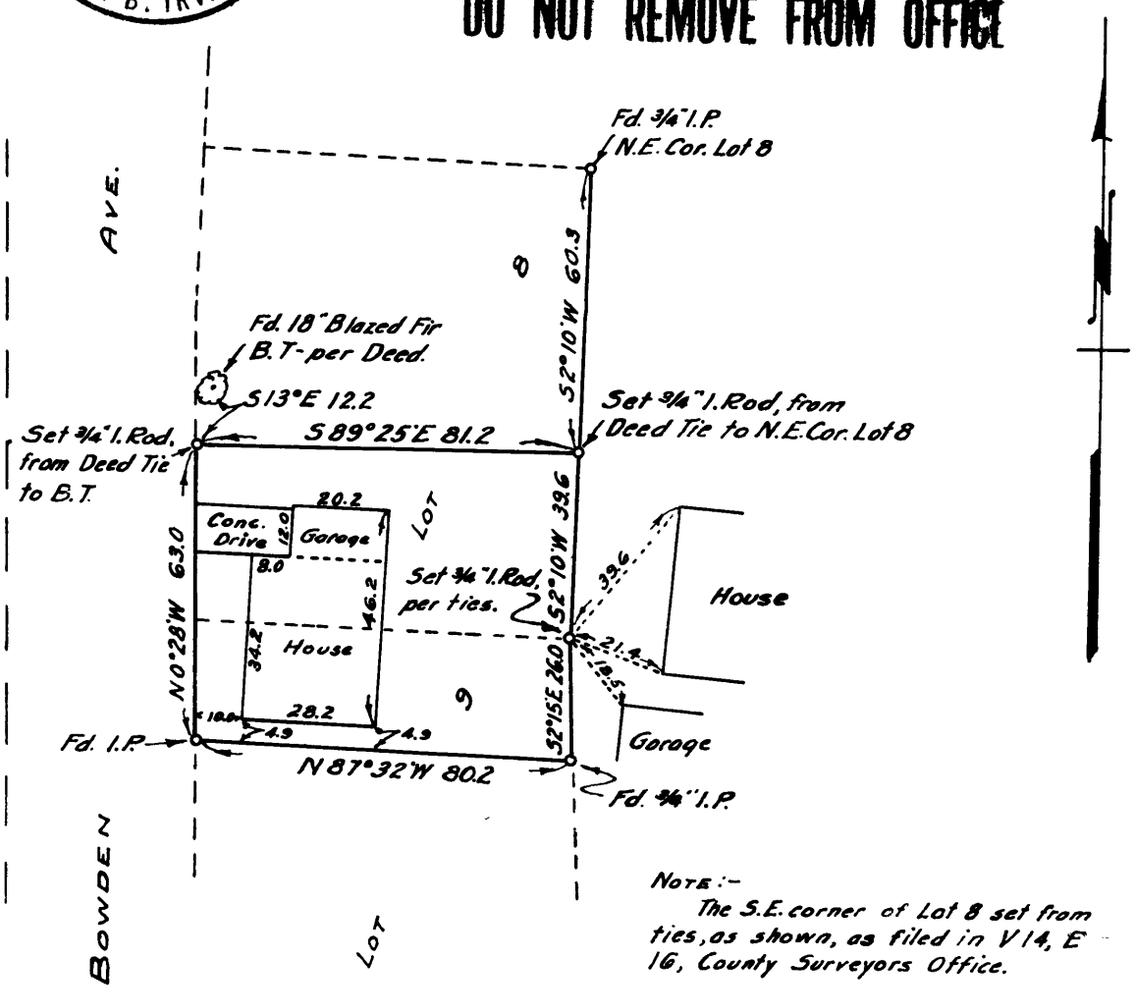

NOTE:-
The S.E. corner of Lot 8 set from ties, as shown, as filed in V14, E 16, County Surveyors Office.

C. S. 843/127-2 (4)
File 127-2 Drawer 43