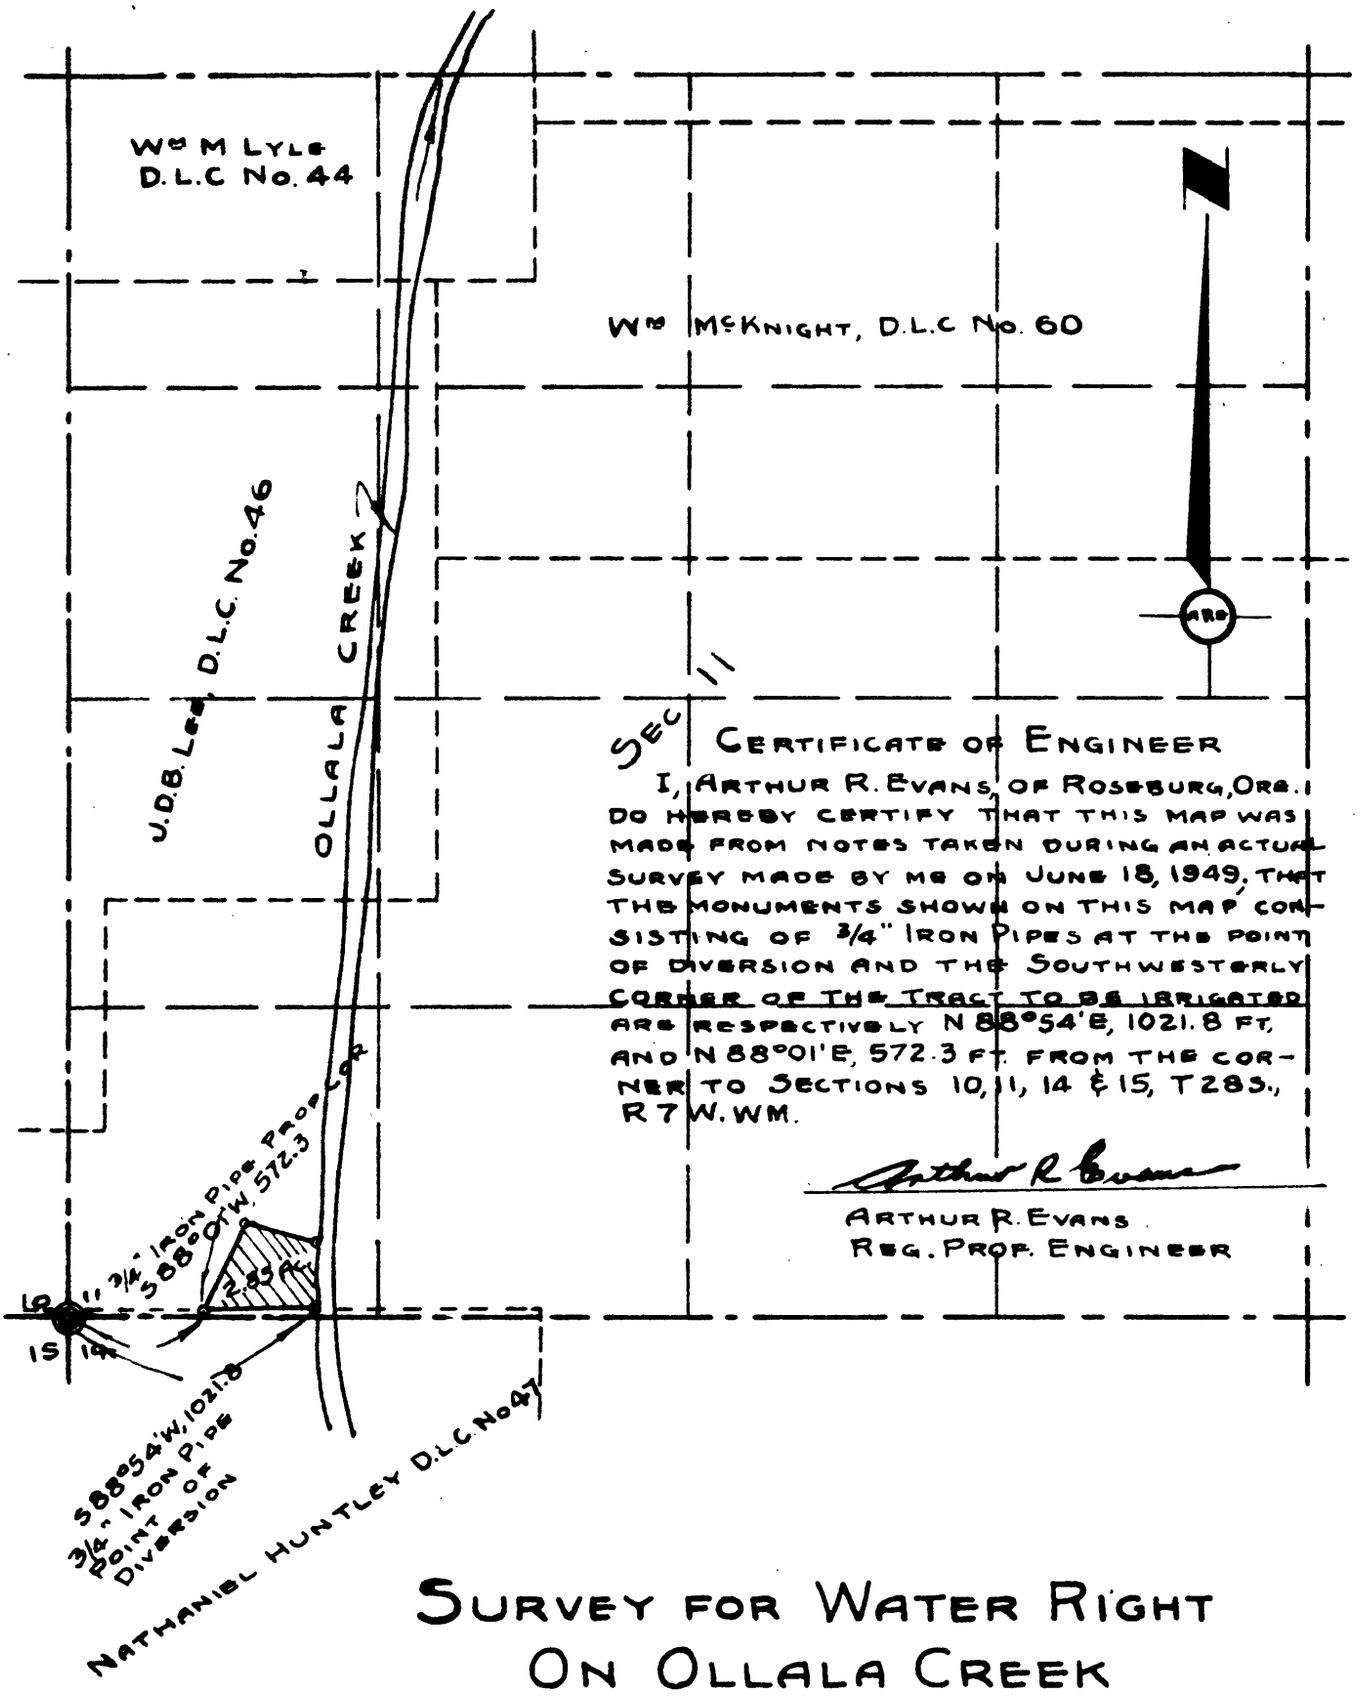

Certificate of Engineer

I, Arthur R. Evans, of Roseburg, Ore. do hereby certify that this map was made from notes taken during an actual survey made by me on June 18, 1949, that the monuments shown on this map consisting of 3/4" Iron Pipes at the point of diversion and the Southwesterly corner of the tract to be irrigated are respectively N 88°54' E, 1021.8 ft. and N 88°01' E, 572.3 ft. from the corner to Sections 10, 11, 14 & 15, T 28 S., R 7 W. WM.

Arthur R Evans

Arthur R. Evans
Reg. Prof. Engineer

Survey for Water Right On Ollala Creek

SW¼SW¼, Section 11, T28S., R7W.WM.
Douglas County Oregon

Surveyed June 18, 1949 By
A.R. Evans, Deputy County Surveyor
Scale 1" = 800'

Registered Professional Engineer
2741
Oregon
Nov. 7, 1947
Arthur R. Evans

C. S. File No. 43132