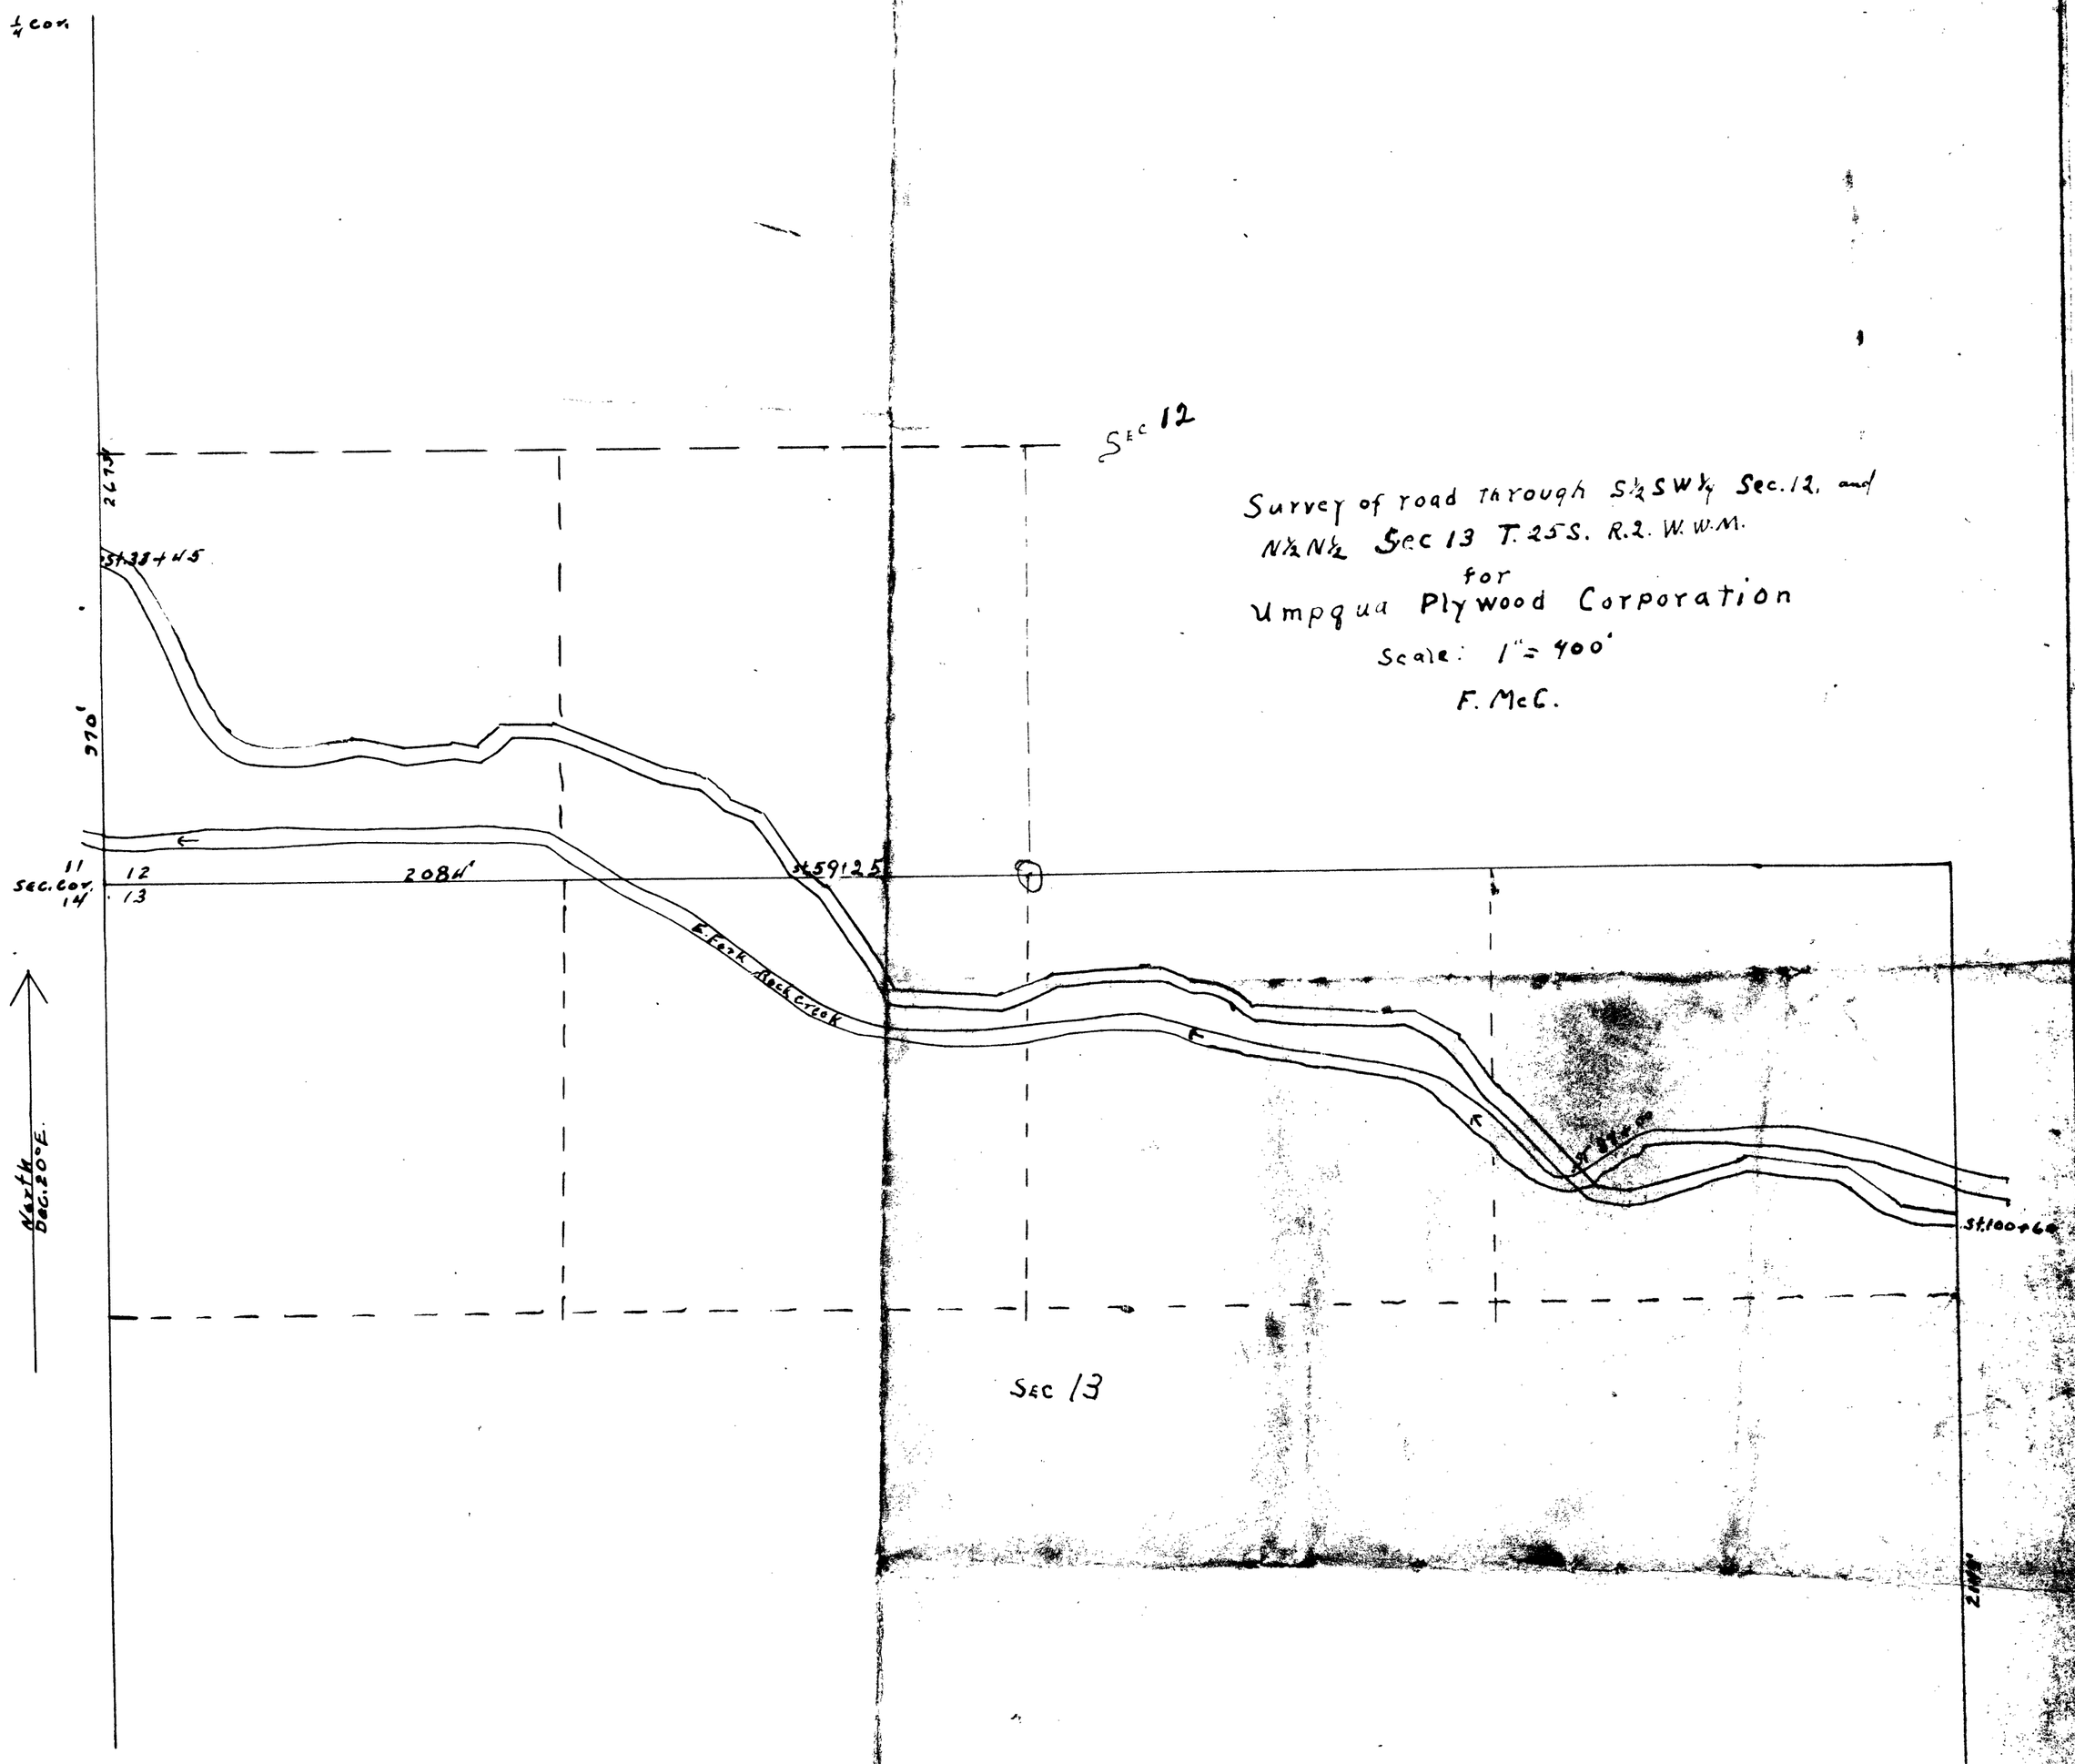
1/4 cor.
Sec 12
Survey of road through S½SW¼ Sec. 12, and
N½N½ Sec 13 T. 25S. R. 2. W.W.M.
for
Umpqua Plywood Corporation
Scale: 1" = 400'
F. McC.
2673'
St 38+45
370'
11
12
Sec. Cor.
14
13
208H'
St 59+25
E. Fork Rock Creek
St 88+60
St 100+60
North
Dec. 20° E.
Sec 13
2.1W.M.
40
Stamped
Sec. Cor.
13

C.S 43/168-2