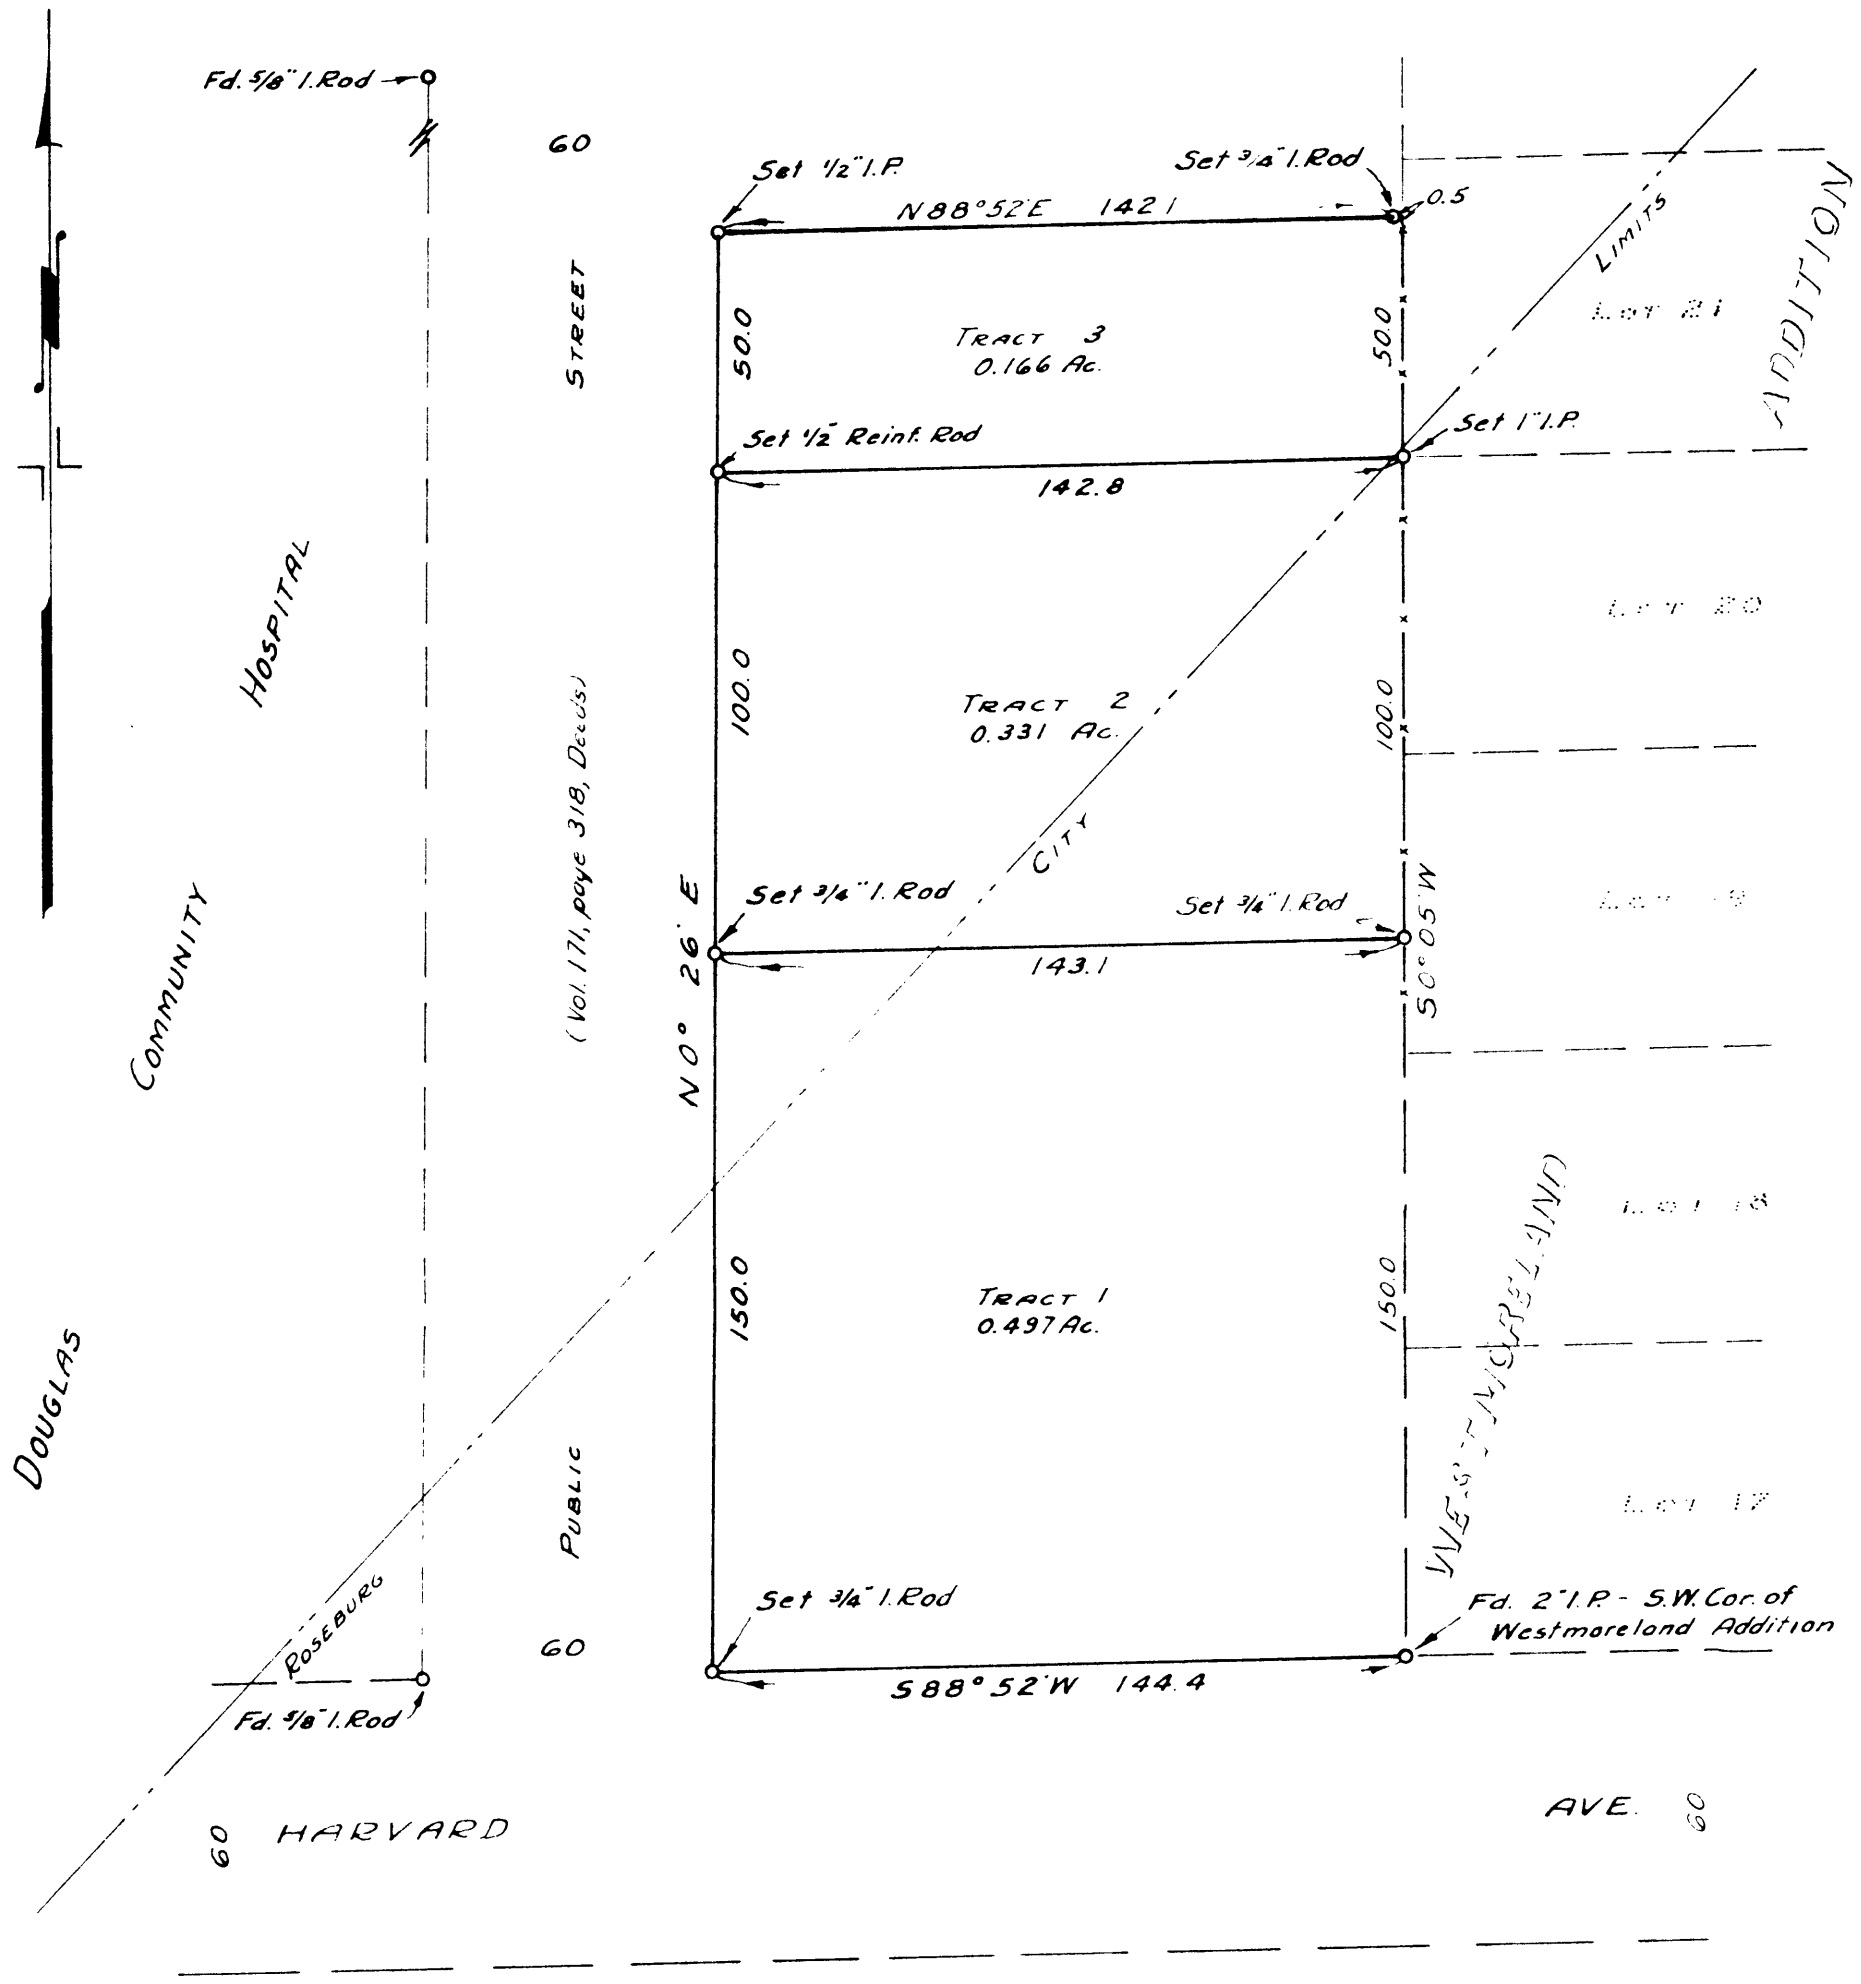

NOTE:-
Bearings shown are based on the bearing of the N'ly R/W line of Harvard Ave. per deed in Vol. 98, page 226 of Deed Records of Douglas County, Oregon.

COUNTY SURVEYOR'S OFFICE
DOUGLAS COUNTY. OREGON

SURVEY FOR DEED DESCRIPTIONS.
SECTION 24. T27S R6W.

BEN. B. IRVING COUNTY SURVEYOR
SURVEYED OCT. 10. 1949 SCALE 1" = 40'

CS 43/176