MAP

SHOWING LOCATION OF RESIDENCE ON & BOUNDARIES OF LOT 6, AMENDED PLAT OF LOTS 12 TO 19 INCLUSIVE, OF WOLLENBERG'S ADDITION TO THE CITY OF ROSEBURG

SURVEYED, JAN. 17-18, 1950 — SCALE 1" = 30'

REGISTERED OREGON LAND SURVEYOR
N E Richardson
JULY 7, 1944
N. E. RICHARDSON
35

I HEREBY CERTIFY THAT I HAVE SURVEYED THE ABOVE DESCRIBED PROPERTY, AND THAT THE BUILDING & IMPROVEMENTS ARE LOCATED AS SHOWN ON THE ANNEXED MAP.

N E Richardson
N. E. RICHARDSON
DEPUTY COUNTY SURVEYOR

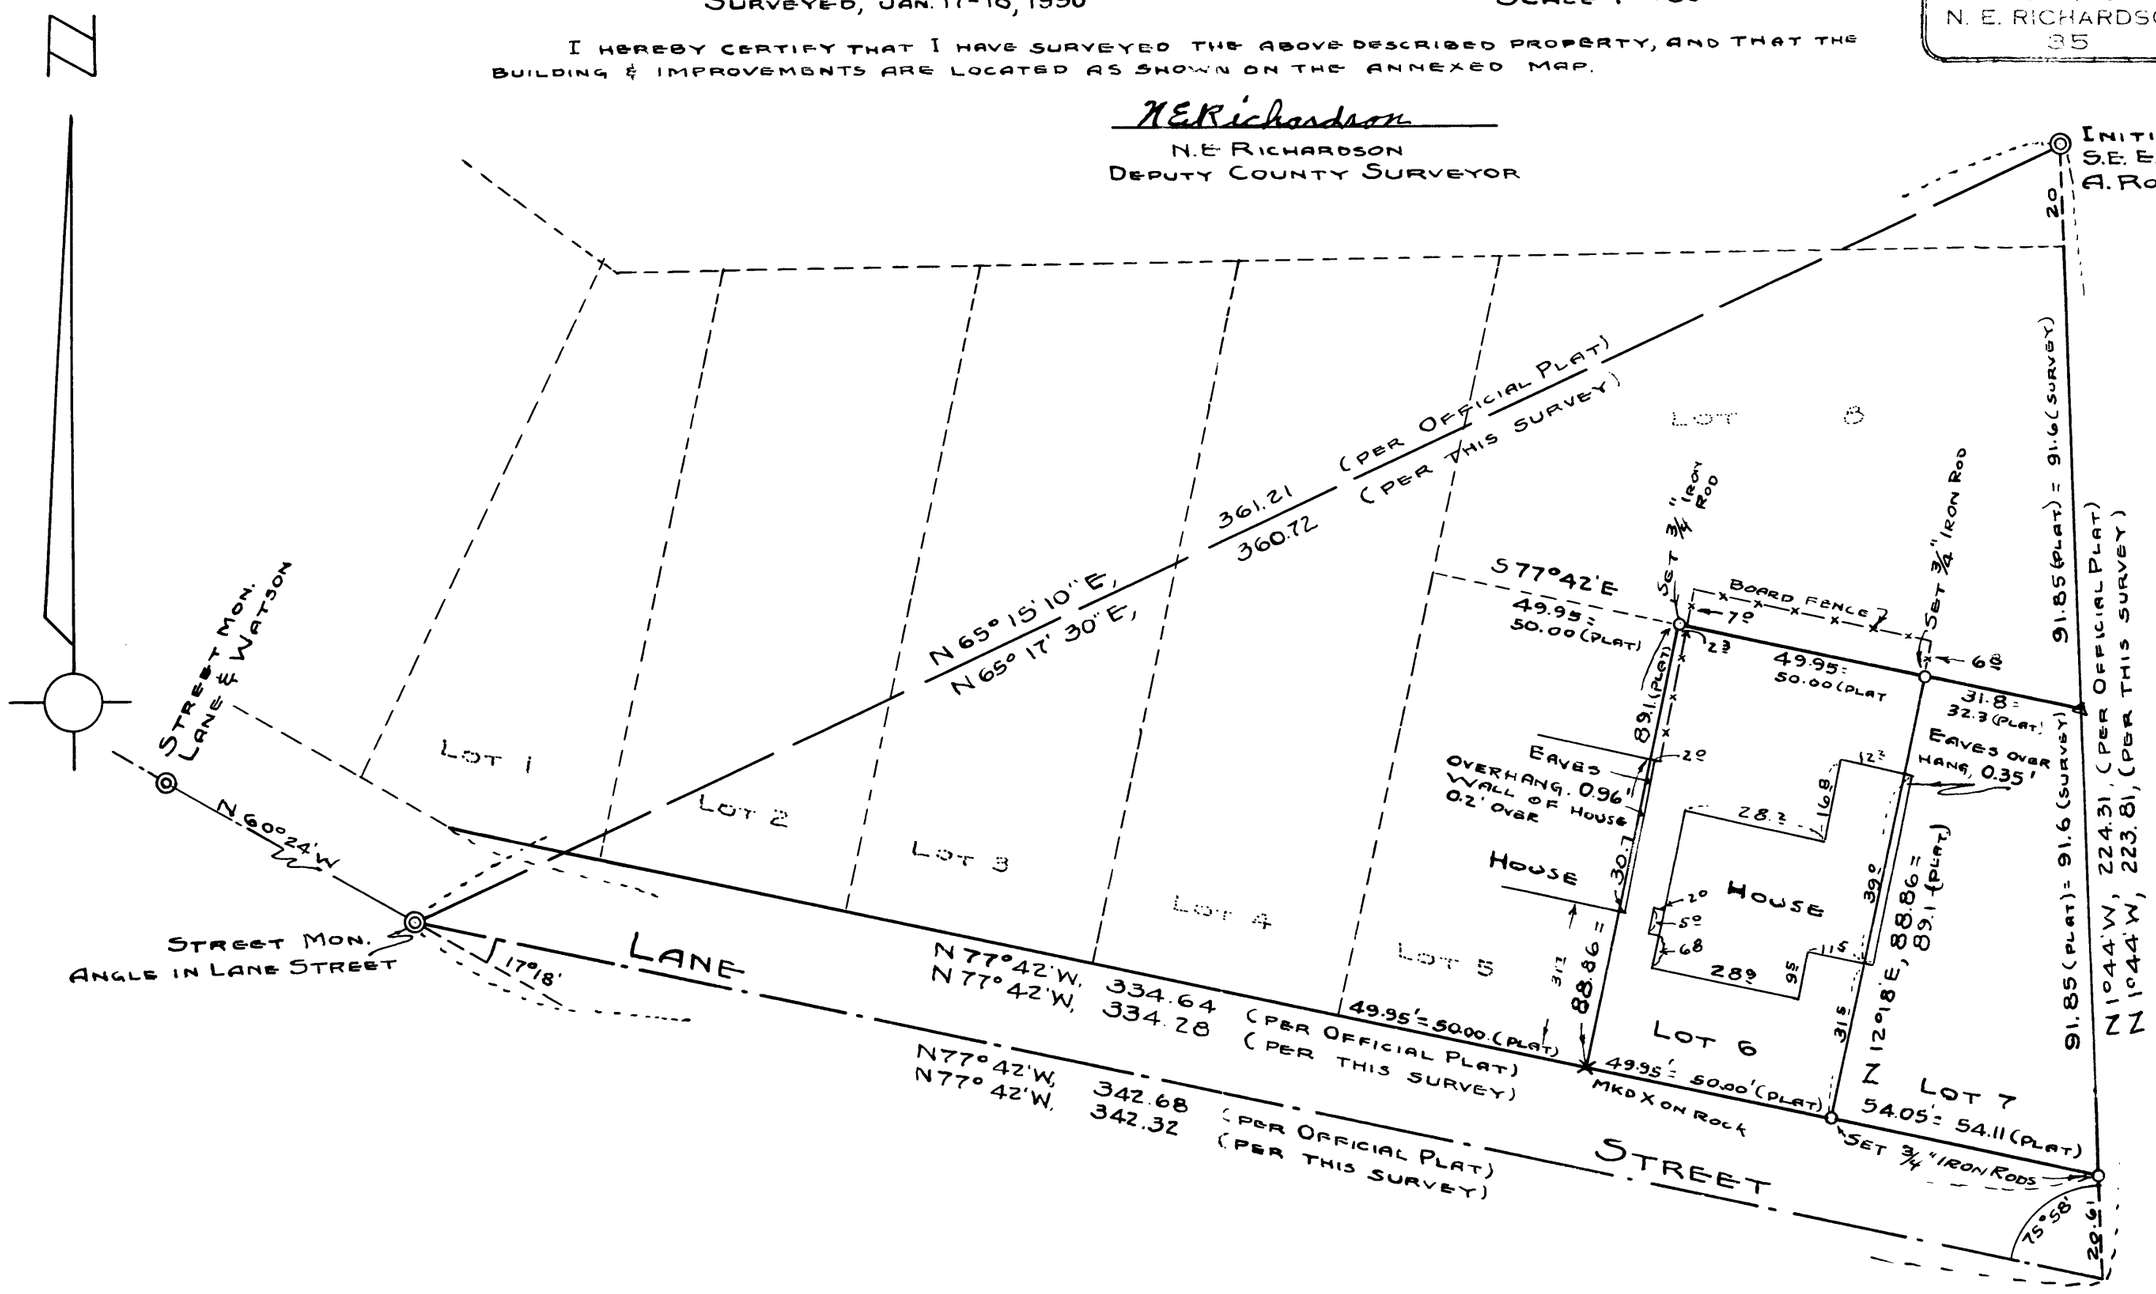

PLATTED 1-21-50 BY A.R. EVANS, DEP. CO. SURVEYOR.

FILE 17 DRAWER 44