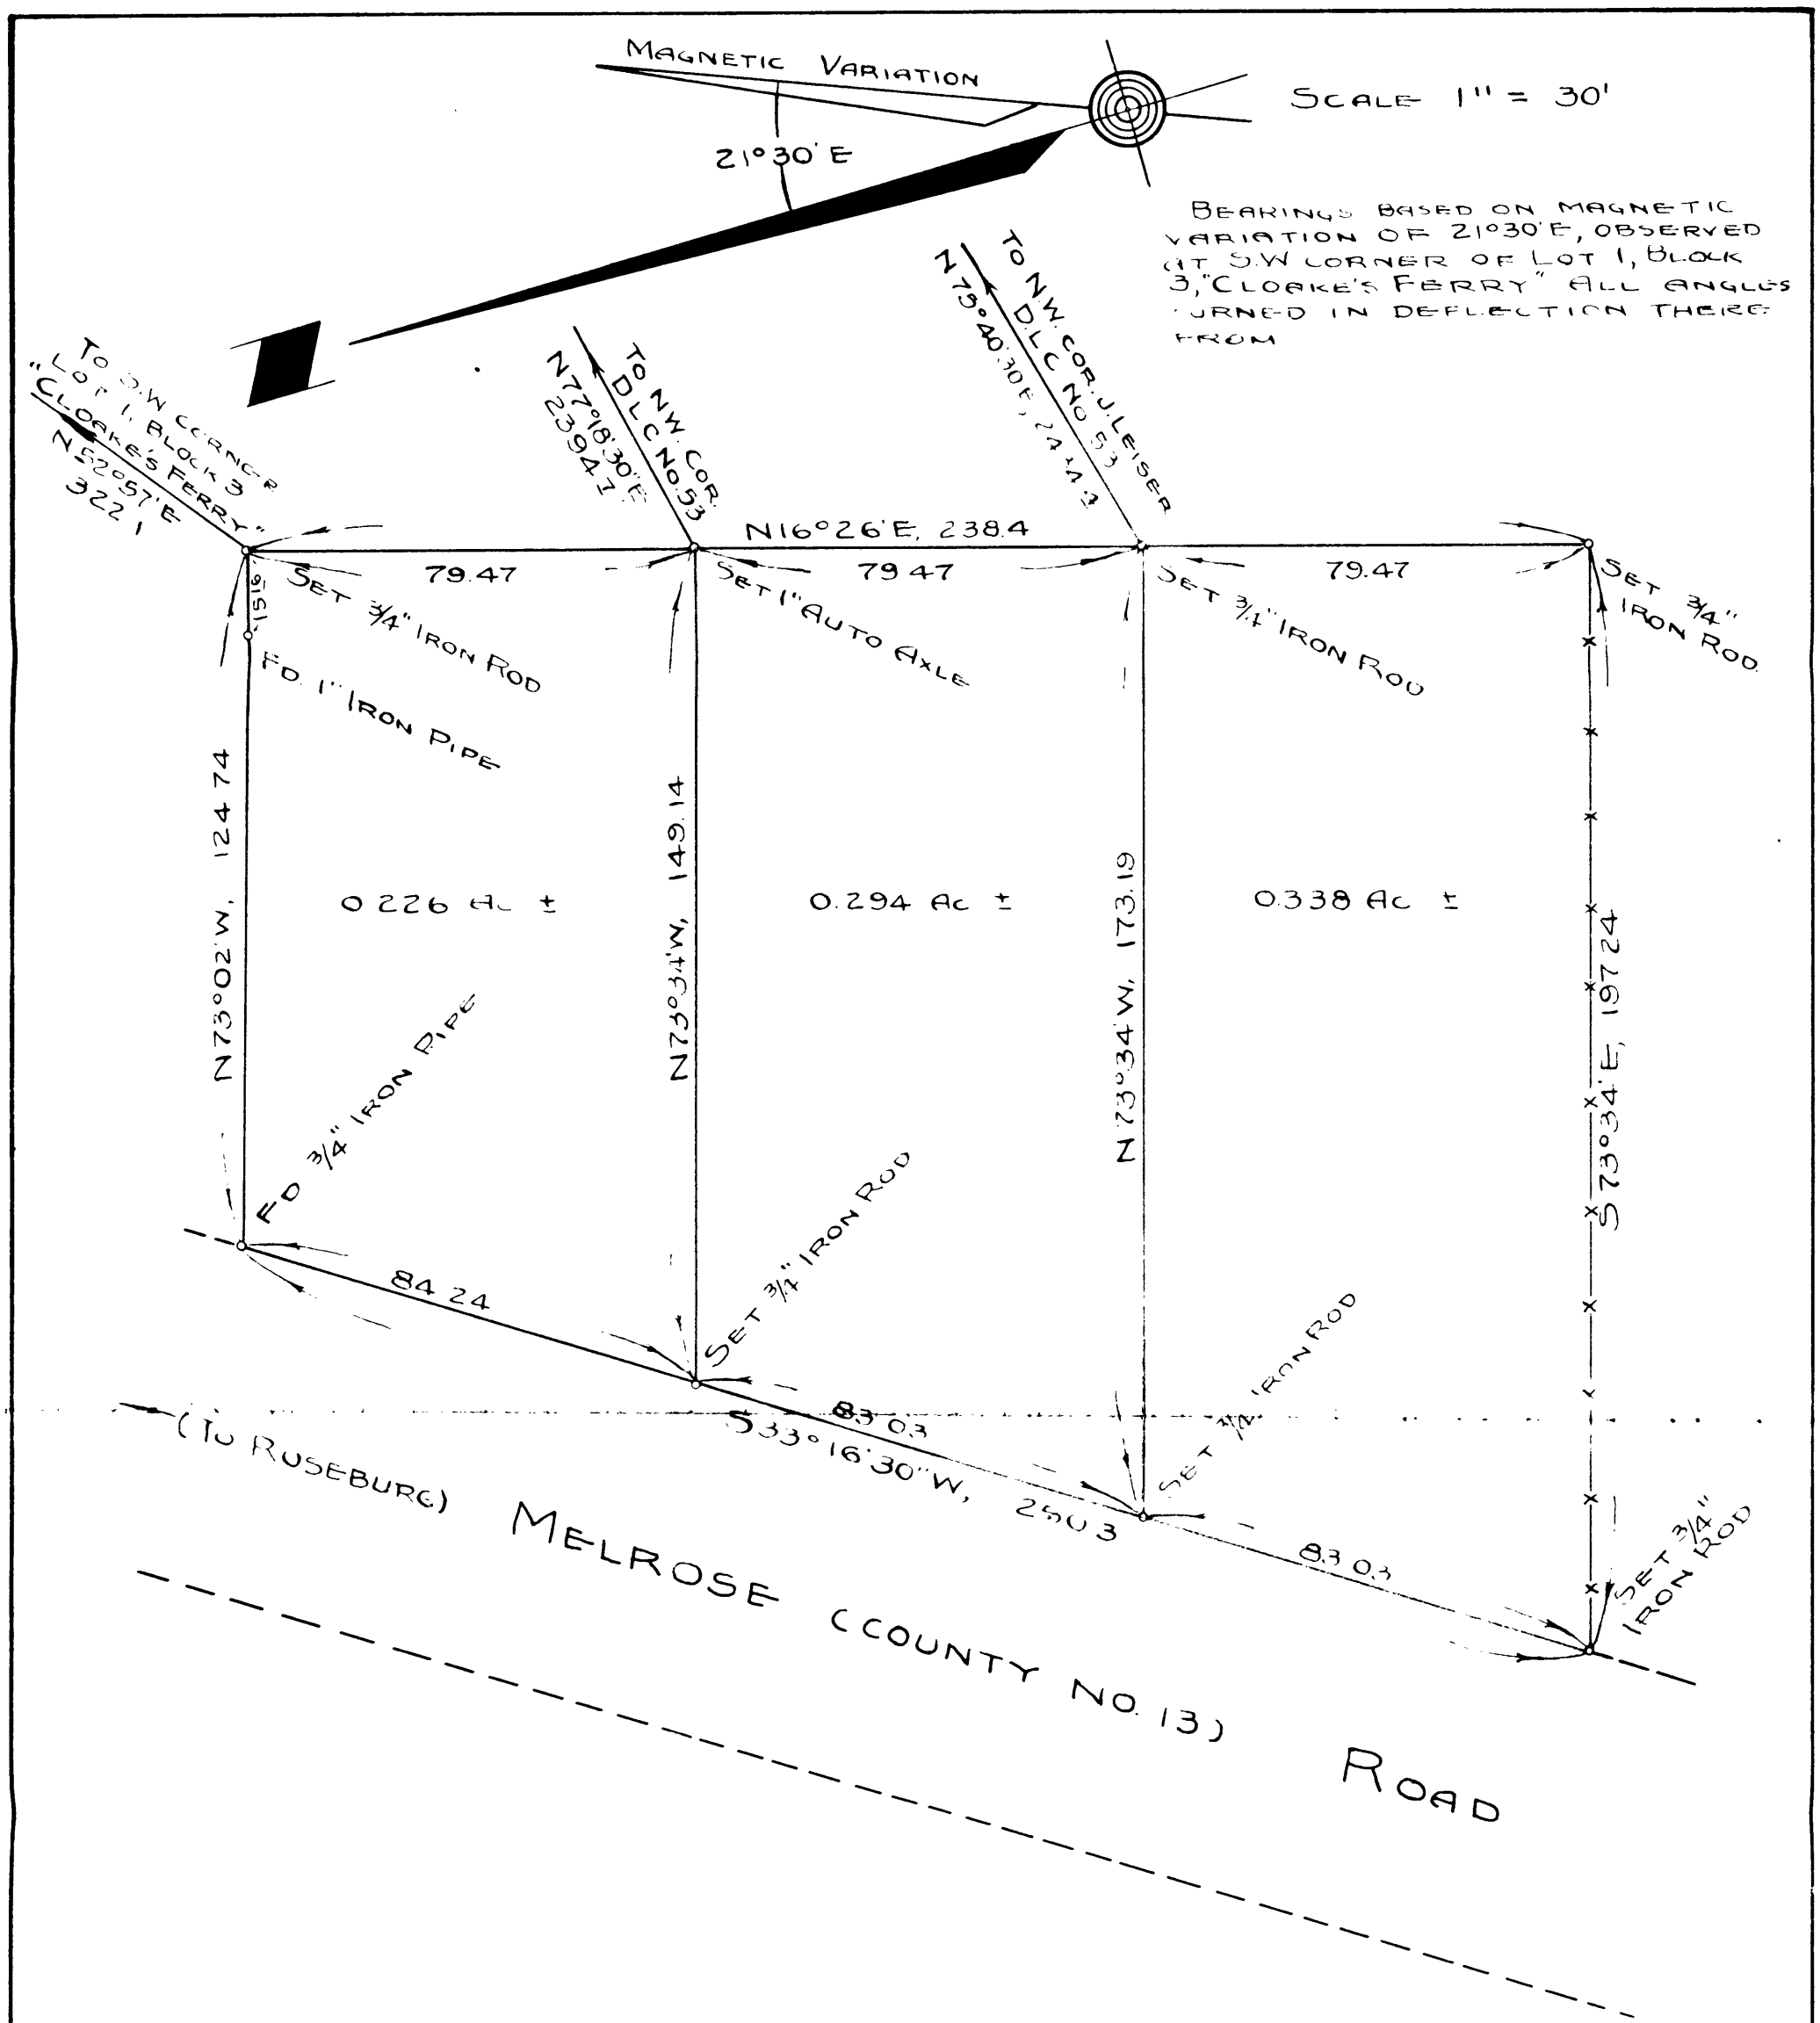

COUNTY SURVEYOR'S OFFICE
DOUGLAS COUNTY OREGON
SURVEY FOR DEED DESCRIPTIONS IN LOTS 7 & 8, "MOUNT NEBO TRACTS" IN SECTION 15, T27S., R6W., W.M.

BEN B. IRVING COUNTY SURVEYOR
SURVEYED & PLATTED, JULY, 1950, BY
A.R. EVANS, DEPUTY COUNTY SURVEYOR

CS44/43-1
M.8-62
FILE 43 DRAWER 44