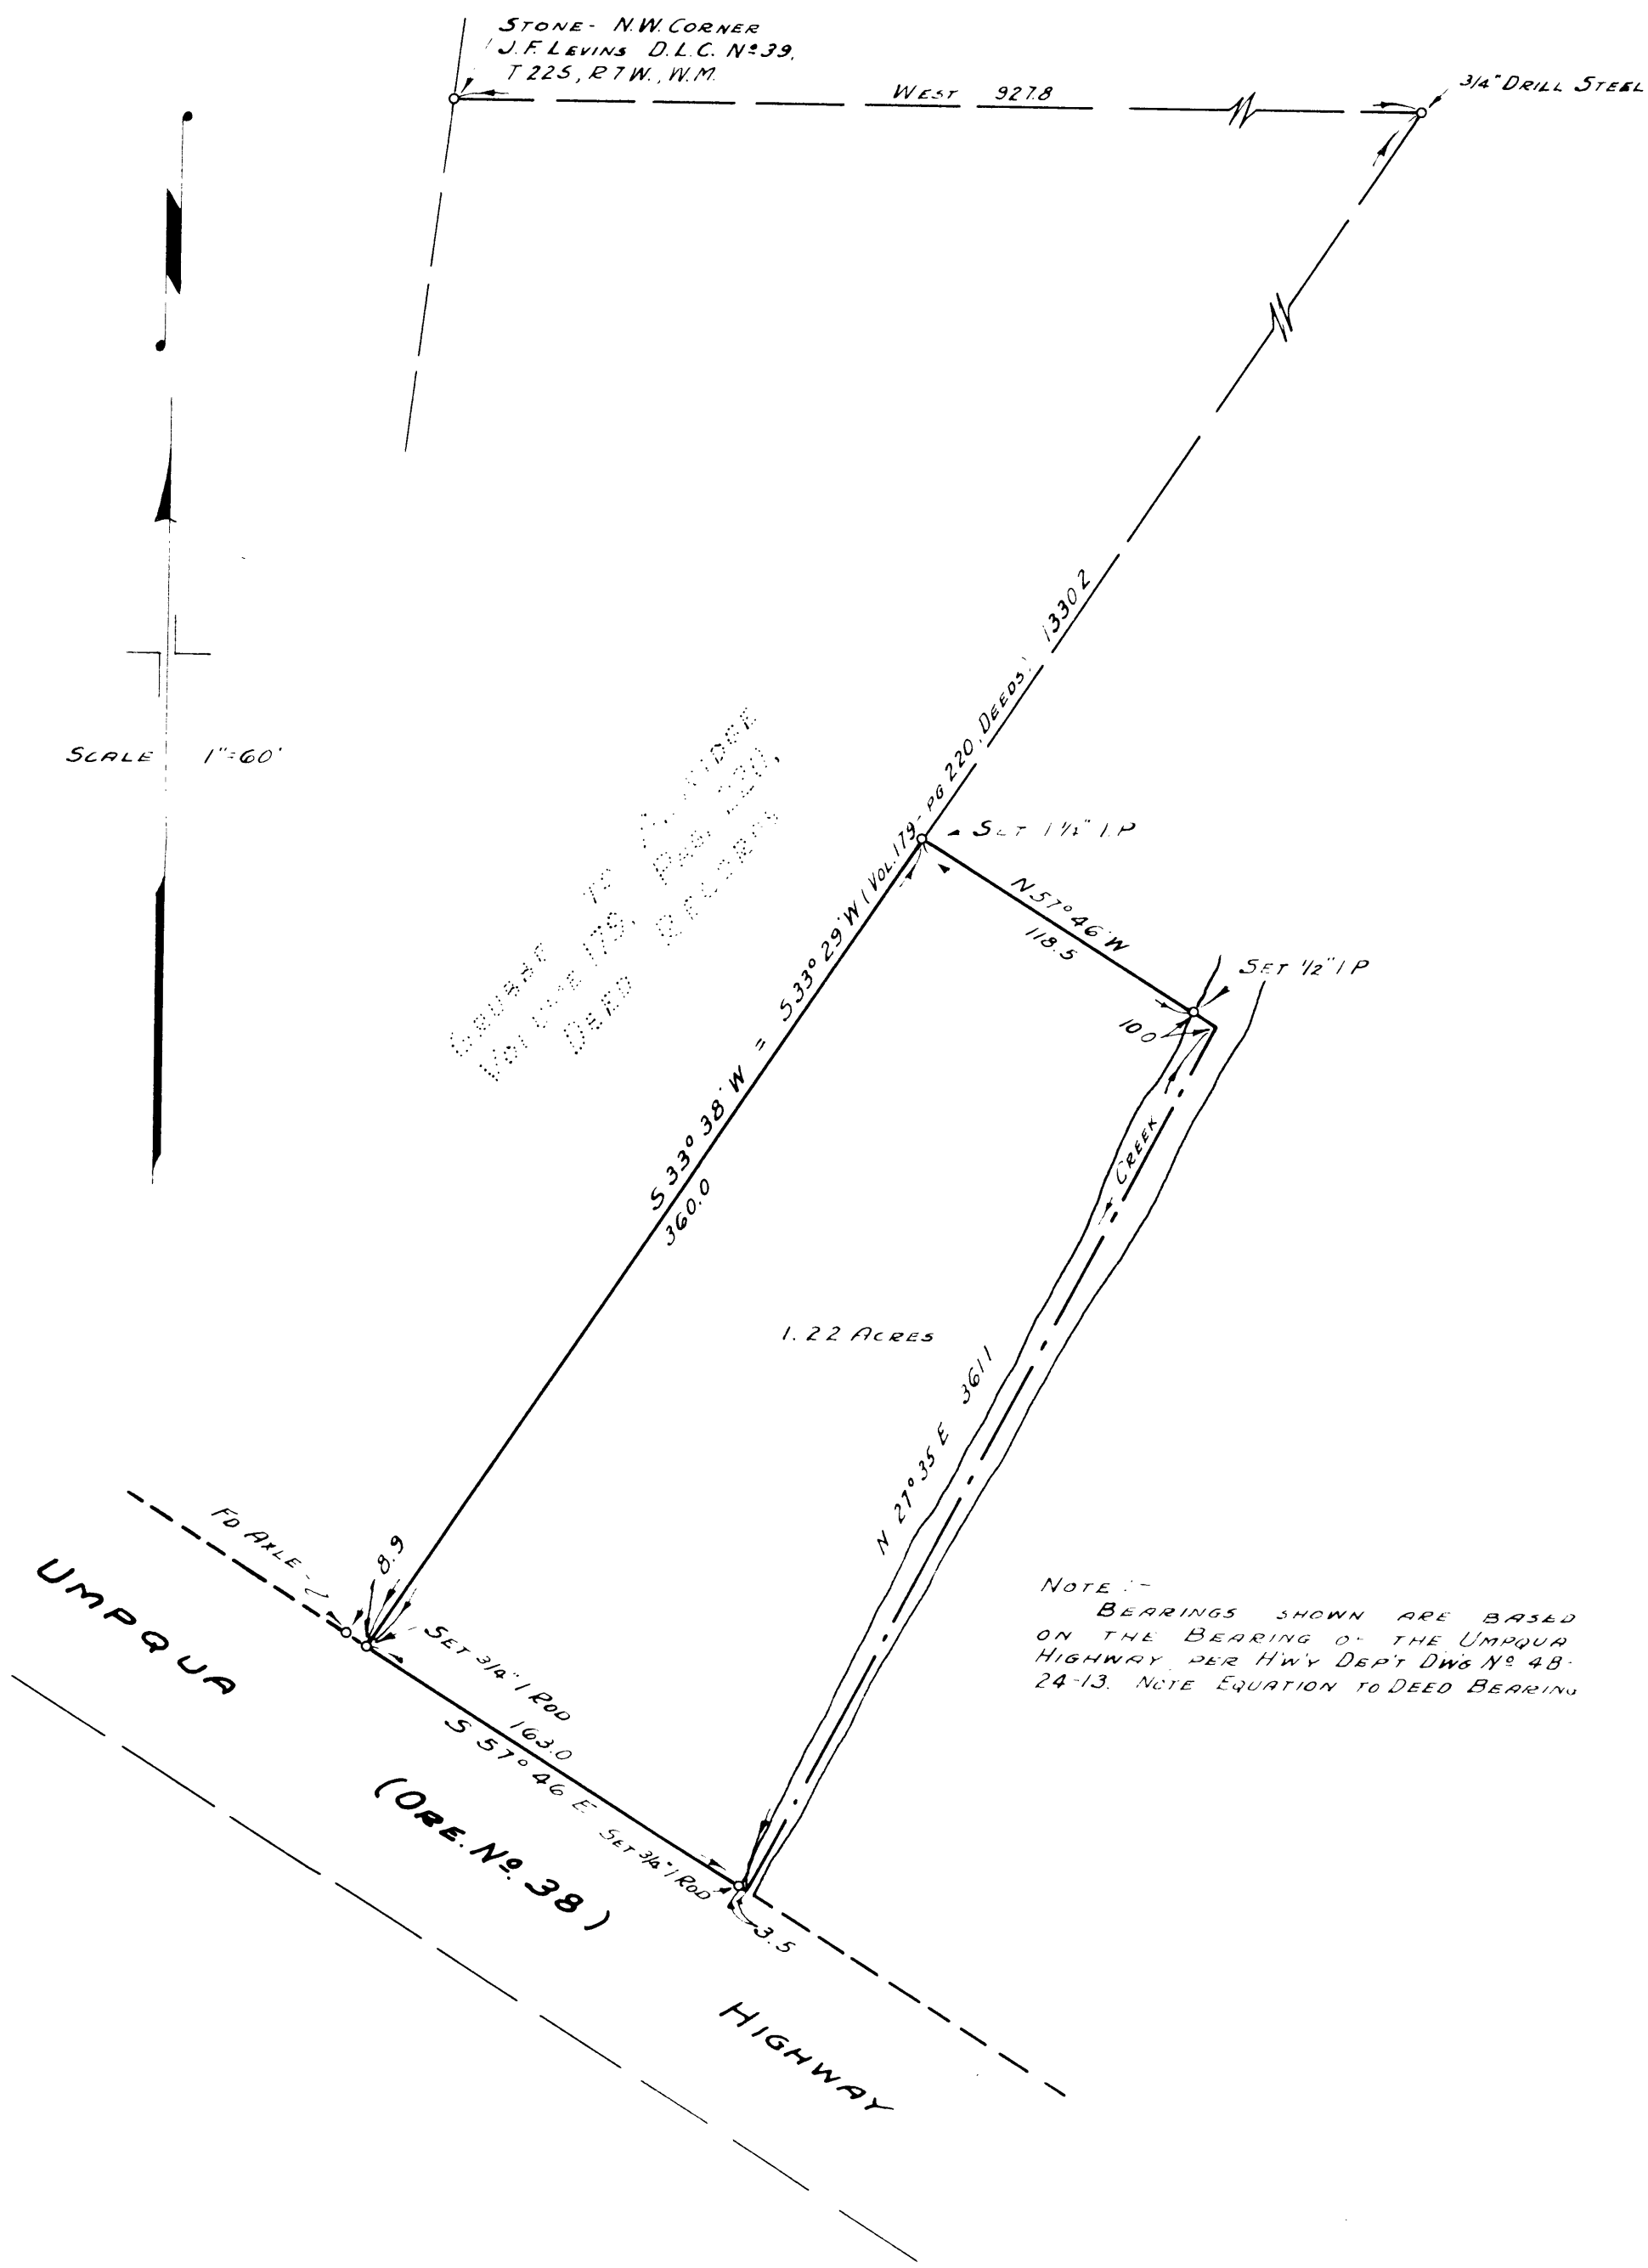

NOTE :-
BEARINGS SHOWN ARE BASED ON THE BEARING OF THE UMPQUA HIGHWAY PER H'W'Y DEP'T DWG Nº 48-24-13. NOTE EQUATION TO DEED BEARING

COUNTY SURVEYOR'S OFFICE
DOUGLAS COUNTY, OREGON.

SURVEY FOR DEED DESCRIPTION,
IN J.F. LEVINS D.L.C. Nº 39, T22S., R7W., W.M.

N.E. Richardson

BEN. B. IRVING COUNTY SURVEYOR
SURVEYED DEC. 20, 1950 BY
N.E. RICHARDSON DEPUTY.

05.44/9C