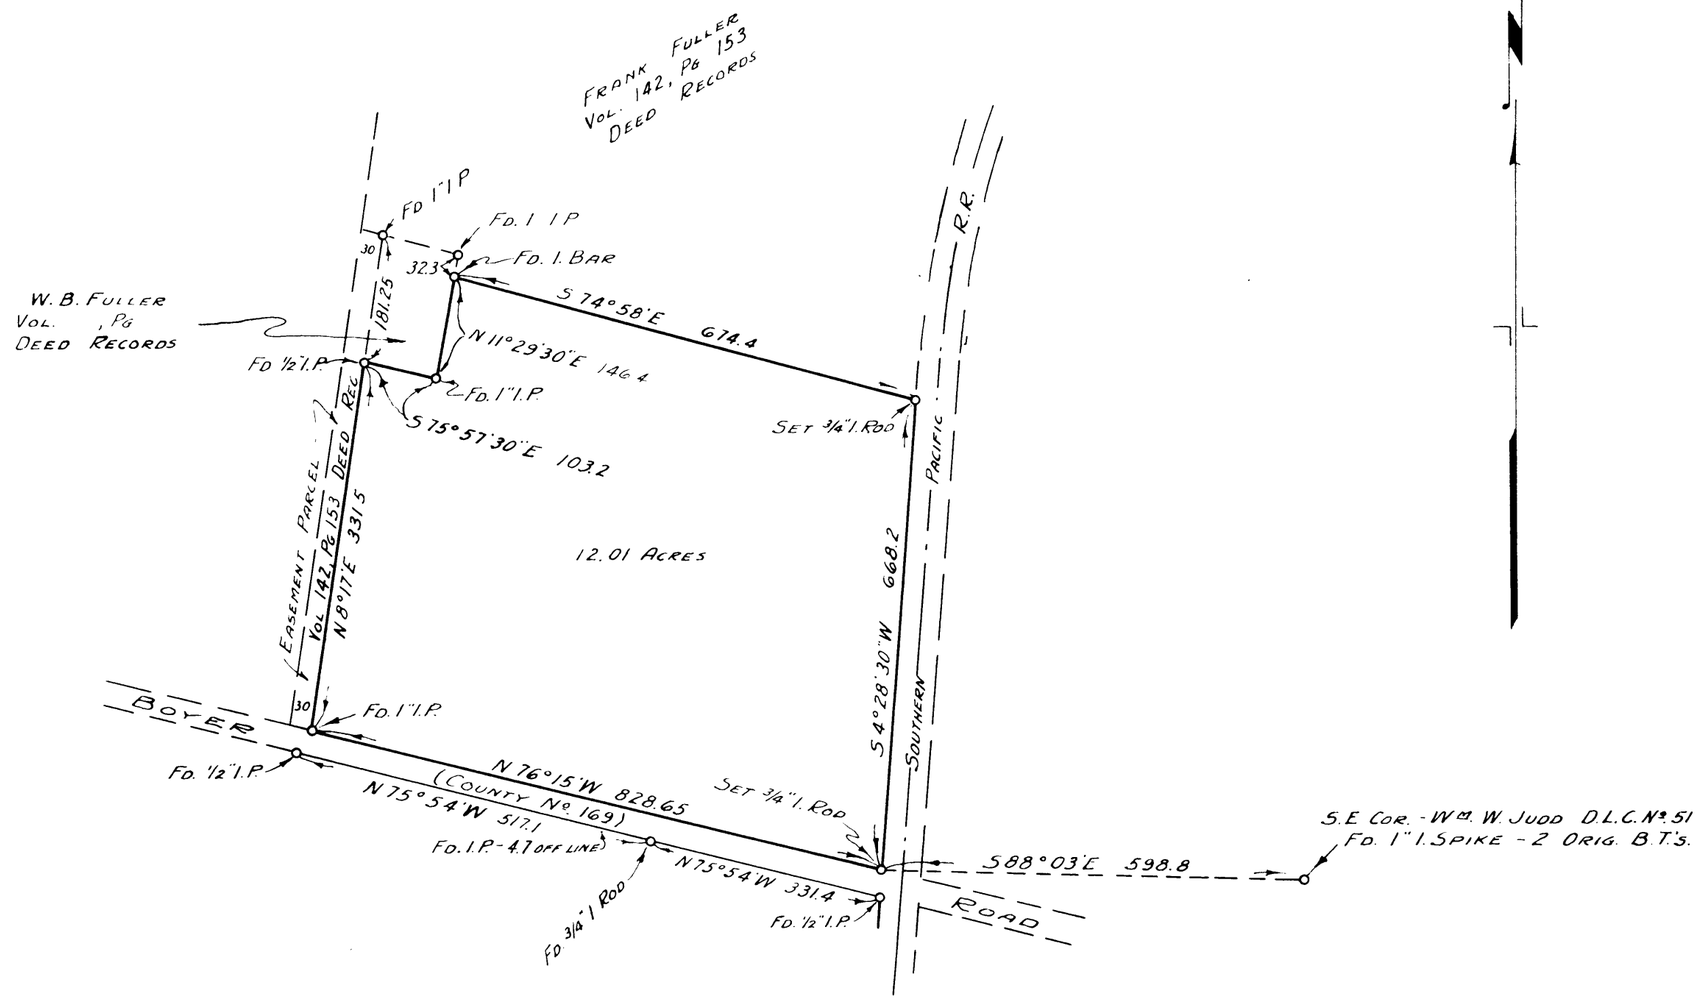

NOTE:-
BEARINGS SHOWN ARE BASED ON THE BEARING OF N 8°17'E AS SHOWN, AND DESCRIBED IN VOL. 189, PAGE 619, 620, 621 OF DEED RECORDS OF DOUGLAS COUNTY, OREGON AS THE BEARING OF THE E'LY. LINE OF THE EASEMENT PARCEL THEREIN.

COUNTY SURVEYOR'S OFFICE
DOUGLAS COUNTY. OREGON

SURVEY FOR DEED DESCRIPTION. IN WM. W. JUDD D.L.C. No. 51. SECTION 13. T30 S.. R6 W.. W.M.

BEN. B. IRVING — COUNTY SURVEYOR
SURVEYED OCT. 26. 1951 — SCALE 1" = 200'

44-97-1

M12-79