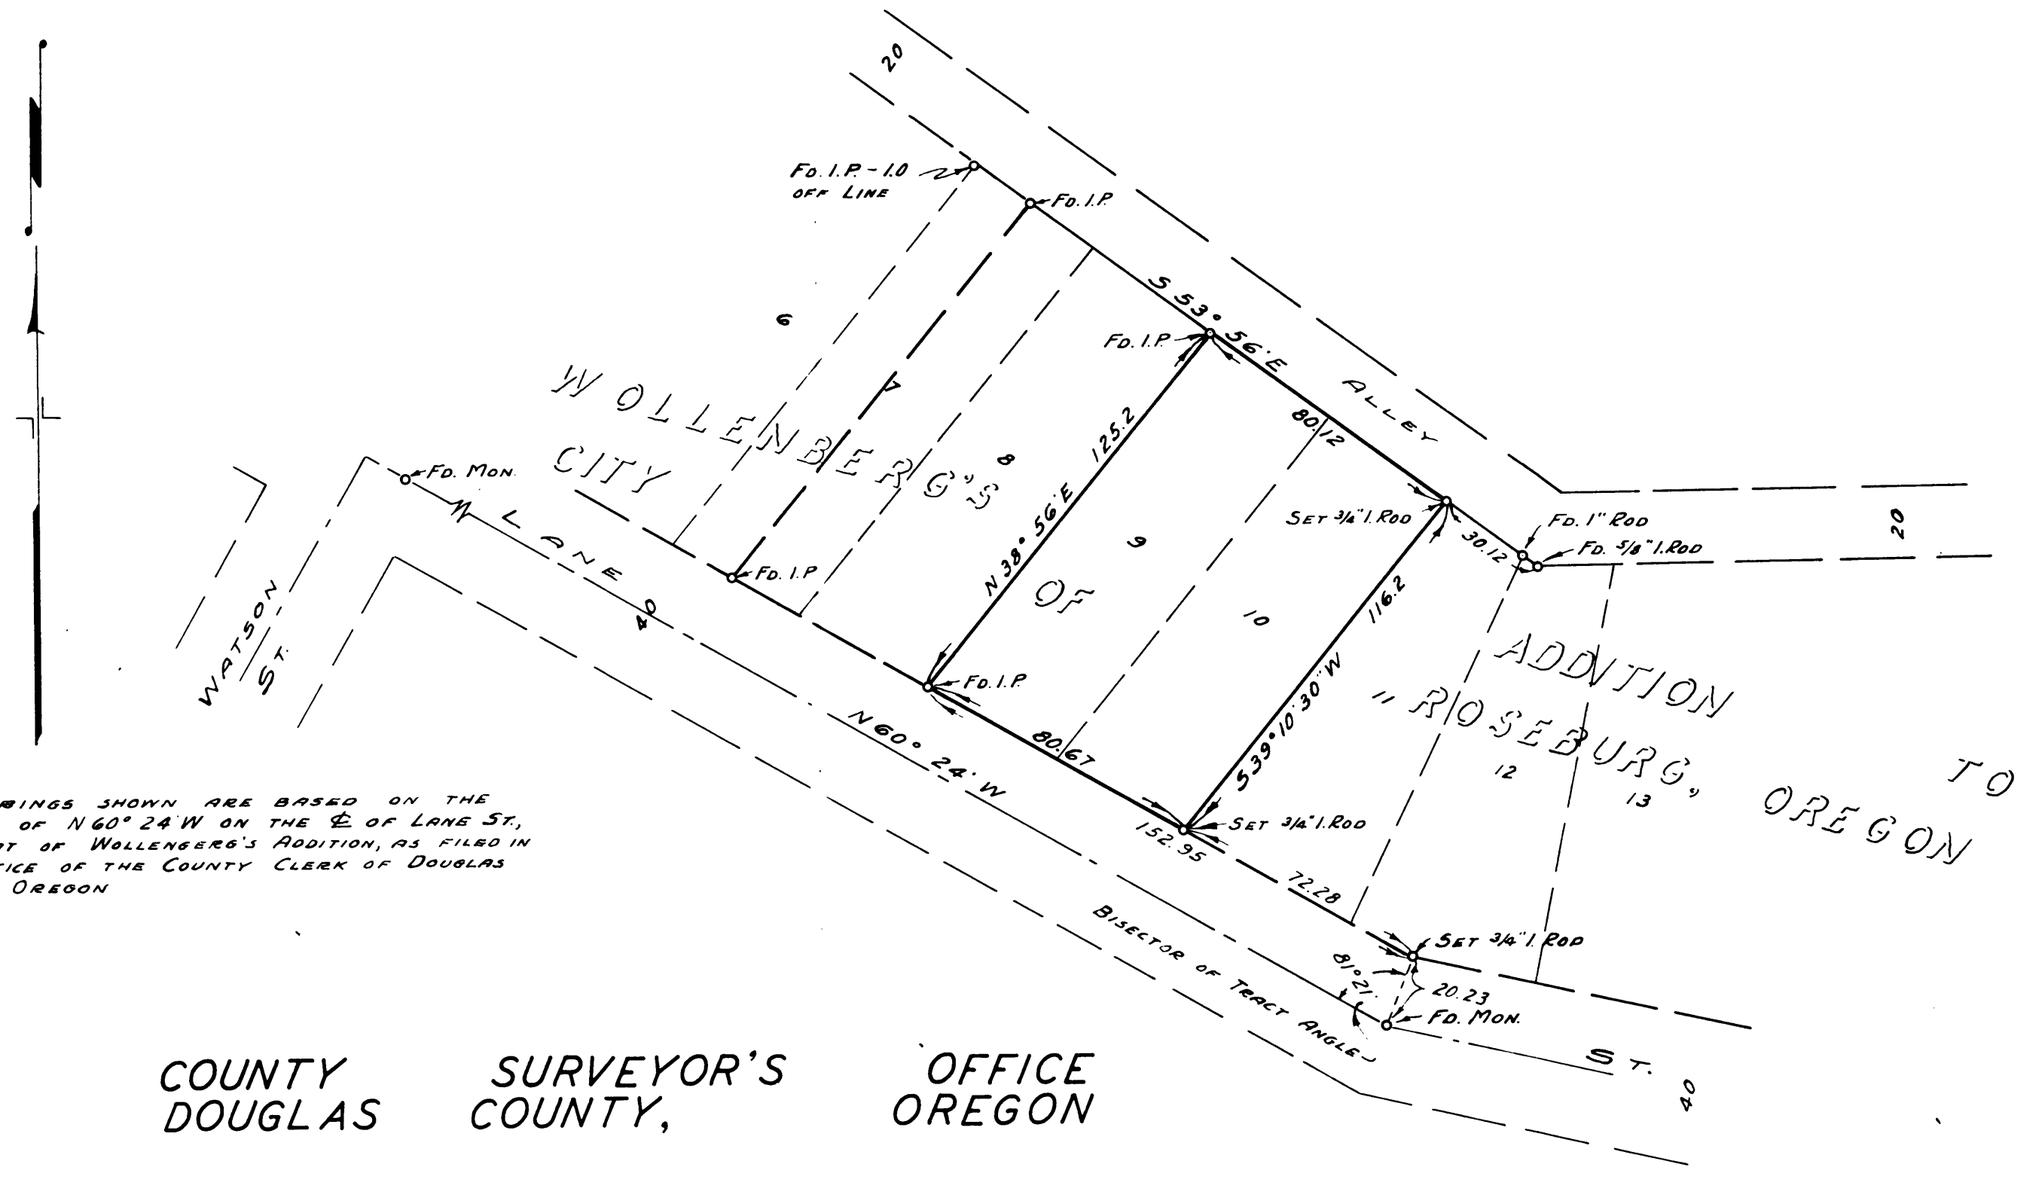

NOTE:-
BEARINGS SHOWN ARE BASED ON THE BEARING OF N 60° 24' W ON THE ℄ OF LANE ST., PER PLAT OF WOLLENBERG'S ADDITION, AS FILED IN THE OFFICE OF THE COUNTY CLERK OF DOUGLAS COUNTY, OREGON

COUNTY SURVEYOR'S OFFICE
DOUGLAS COUNTY, OREGON

SURVEY TO ESTABLISH LOT CORNERS

BEN. B. IRVING COUNTY SURVEYOR
SURVEYED MARCH 9, 1951 BY
N. E. RICHARDSON DEPUTY
SCALE 1" = 40'

N E Richardson

G. S. File No. 44/102

M 23-31