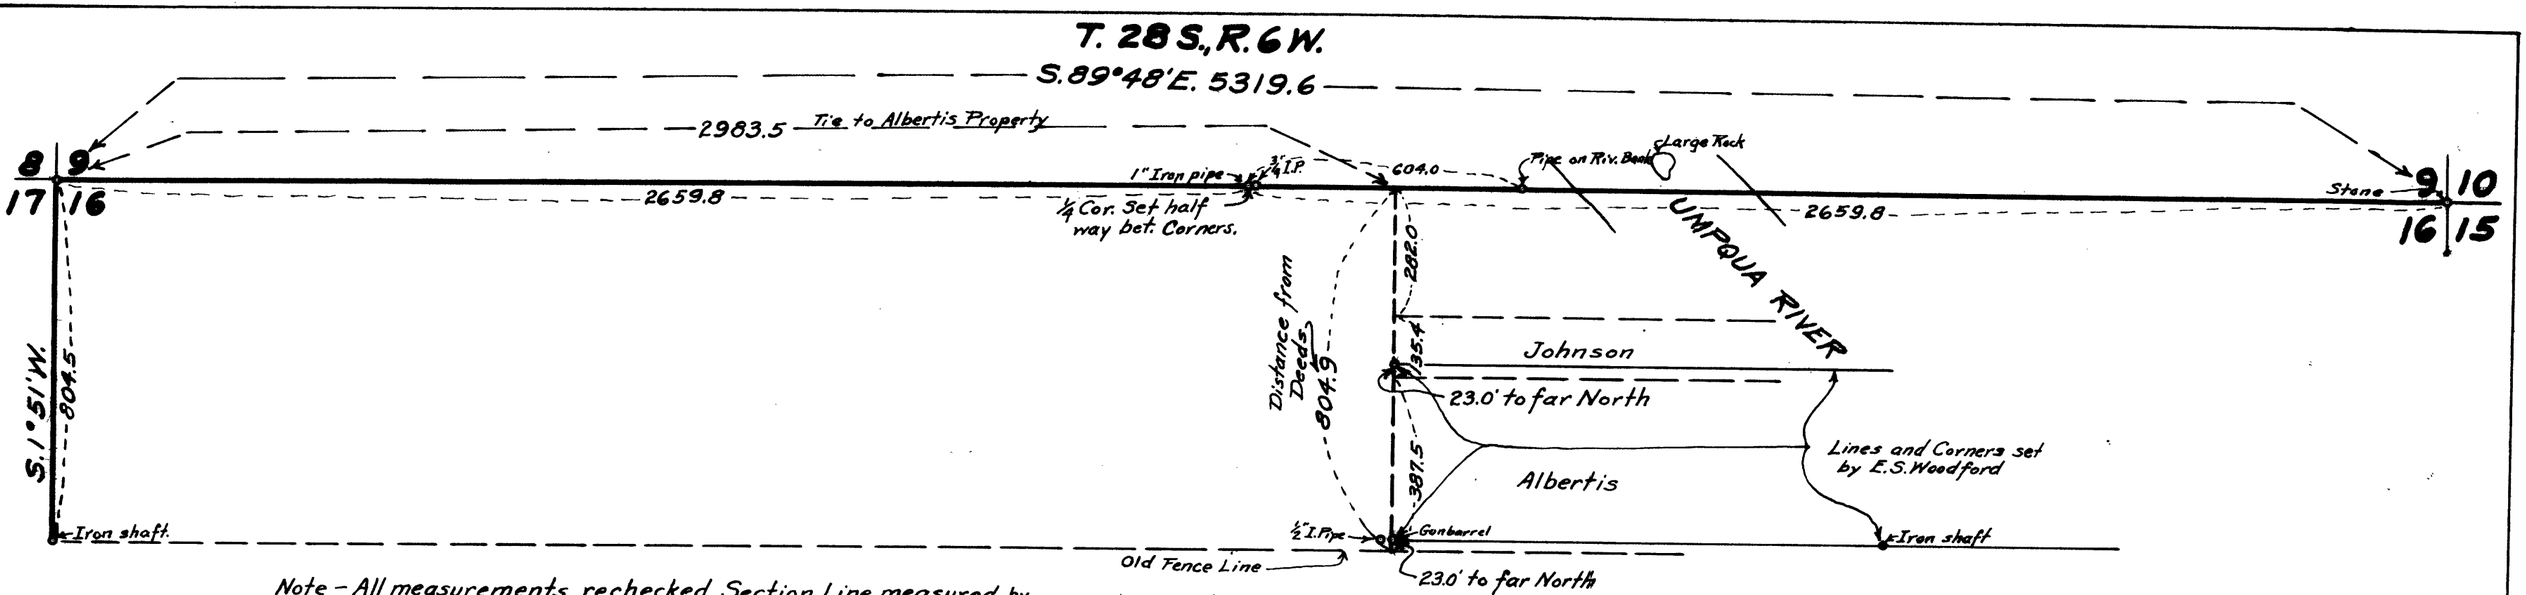

Note – All measurements rechecked, Section Line measured by offset at River using Rock as station.

REGISTERED
OREGON
LAND SURVEYOR

Geo. J. Wenderoth

MARCH 10, 1944
George J. Wenderoth
5

COUNTY SURVEYORS FILE DATA
DO NOT REMOVE FROM OFFICE

COUNTY SURVEYOR'S OFFICE
DOUGLAS COUNTY, OREGON.

Survey for
Robert Johnson
showing shortage in property by previous survey and distances from land deeds.
Geo. J. Wenderoth, Deputy County Surveyor.
May, 1951 Scale 1" = 300ft.

File No. 44/120-1