


MAP

SHOWING LOCATION OF
 RESIDENCE ON & BOUNDARIES OF
 LOT 5, BLOCK 2, NORTONAIRE ADDITION
 TO THE TOWN OF MYRTLE CREEK
 IN THE
 COUNTY OF DOUGLAS
 AND
 STATE OF OREGON
 SURVEYED 6-28-51 SCALE 1" = 30'

COUNTY SURVEYORS FILE DATA
 DO NOT REMOVE FROM OFFICE

I HEREBY CERTIFY THAT I HAVE SURVEYED THE ABOVE DESCRIBED PROPERTY AND THAT THE IMPROVEMENTS SHOWN AND DESCRIBED HEREON ARE WITHIN THE PROPERTY LINES

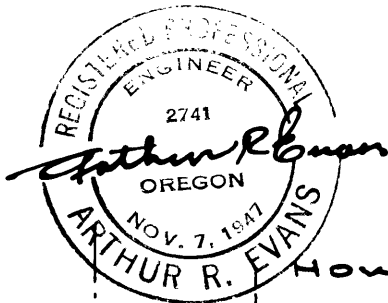

Arthur R. Evans

ARTHUR R. EVANS
 DEPUTY COUNTY SURVEYOR

