COUNTY SURVEYORS FILE DATA
DO NOT REMOVE FROM OFFICE

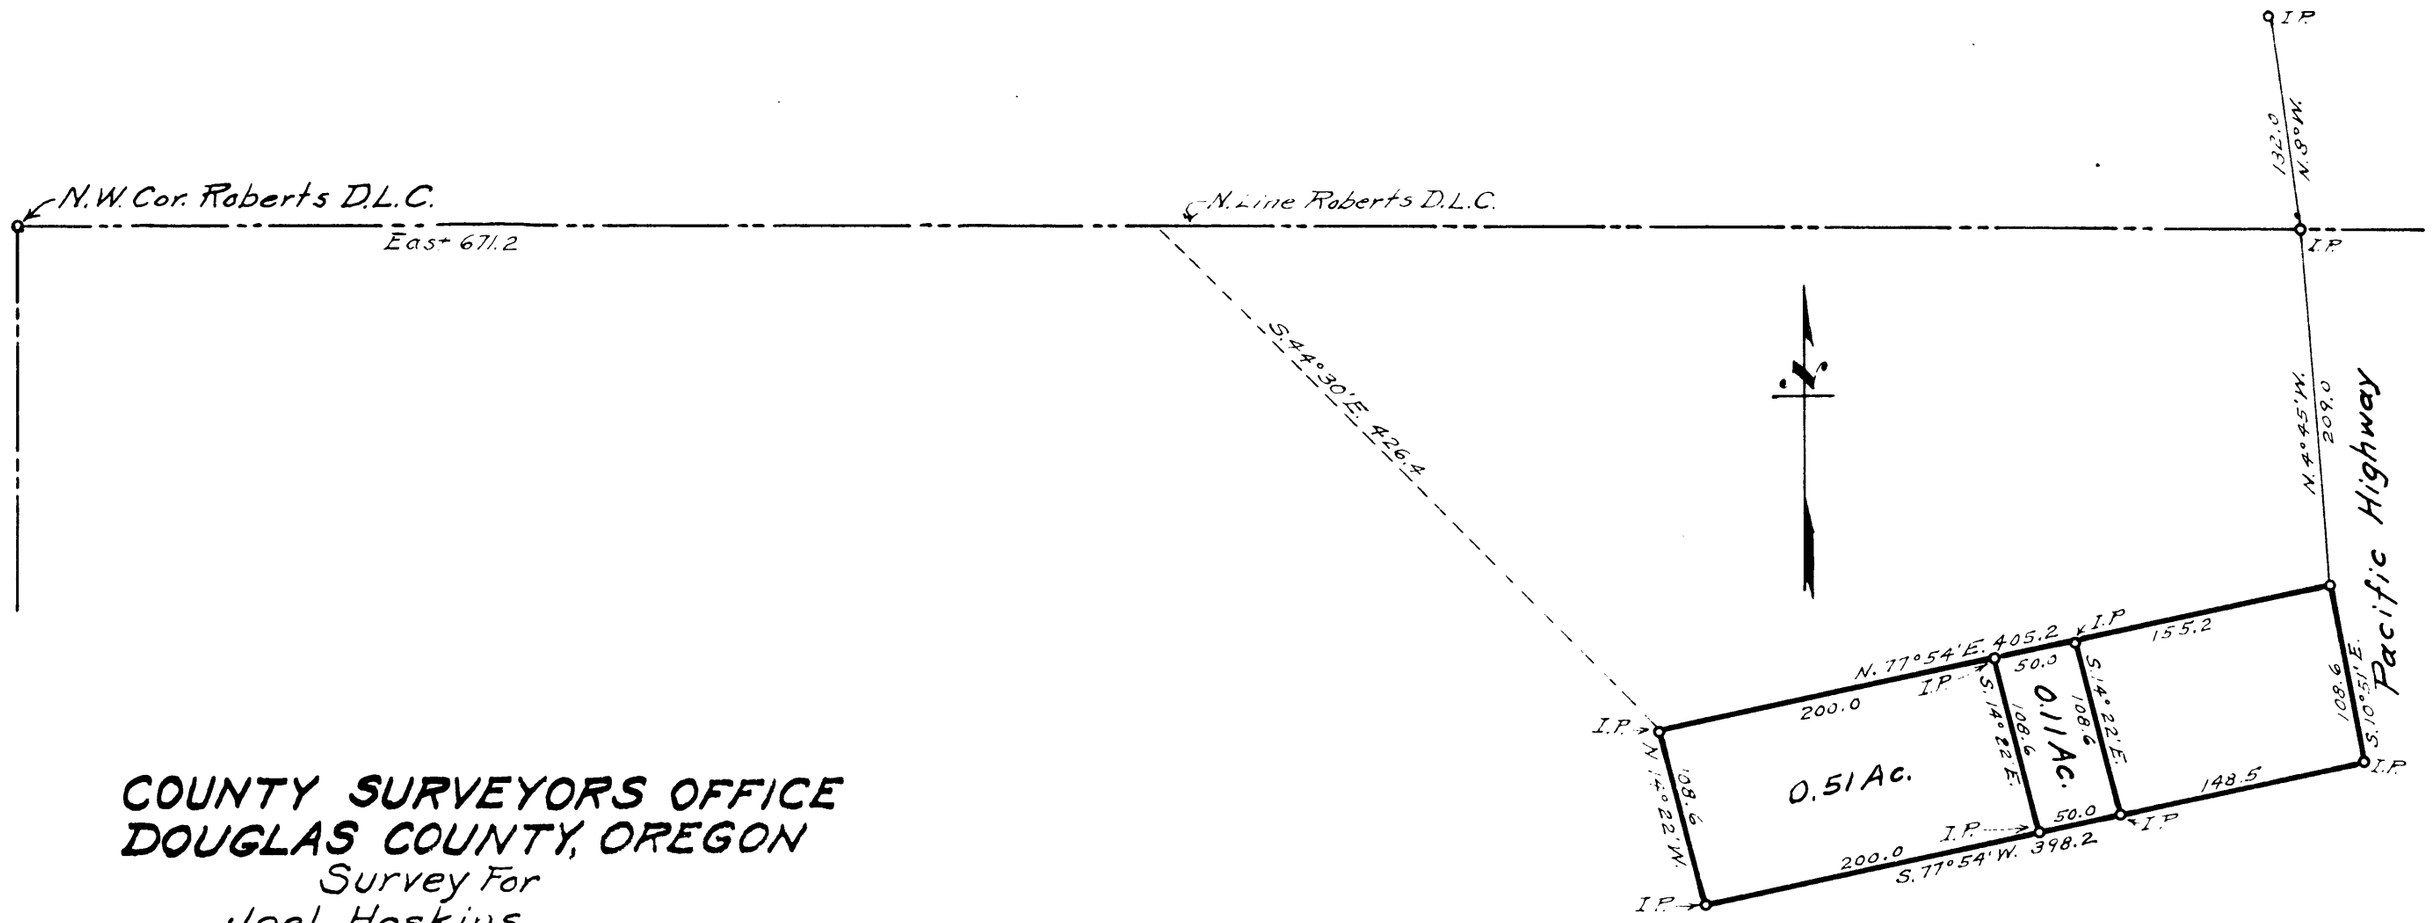

COUNTY SURVEYORS OFFICE
DOUGLAS COUNTY, OREGON

Survey For
Joel Hoskins
in City of Canyonville.
Section 27, T. 30 S., R. 5 W. W.M.
Geo. J. Wenderoth, Deputy
August, 1951 Scale 1" = 100 ft.

Geo. J. Wenderoth

P

447/150