COUNTY SURVEYOR'S OFFICE
DOUGLAS COUNTY, OREGON

Survey for
J. R. Anderson
Section 20, T. 32 S., R. 5 W., W.M.
Geo. J. Wenderoth, Deputy Surveyor
June 1952 Scale 1" = 400 ft.

Geo. J. Wenderoth

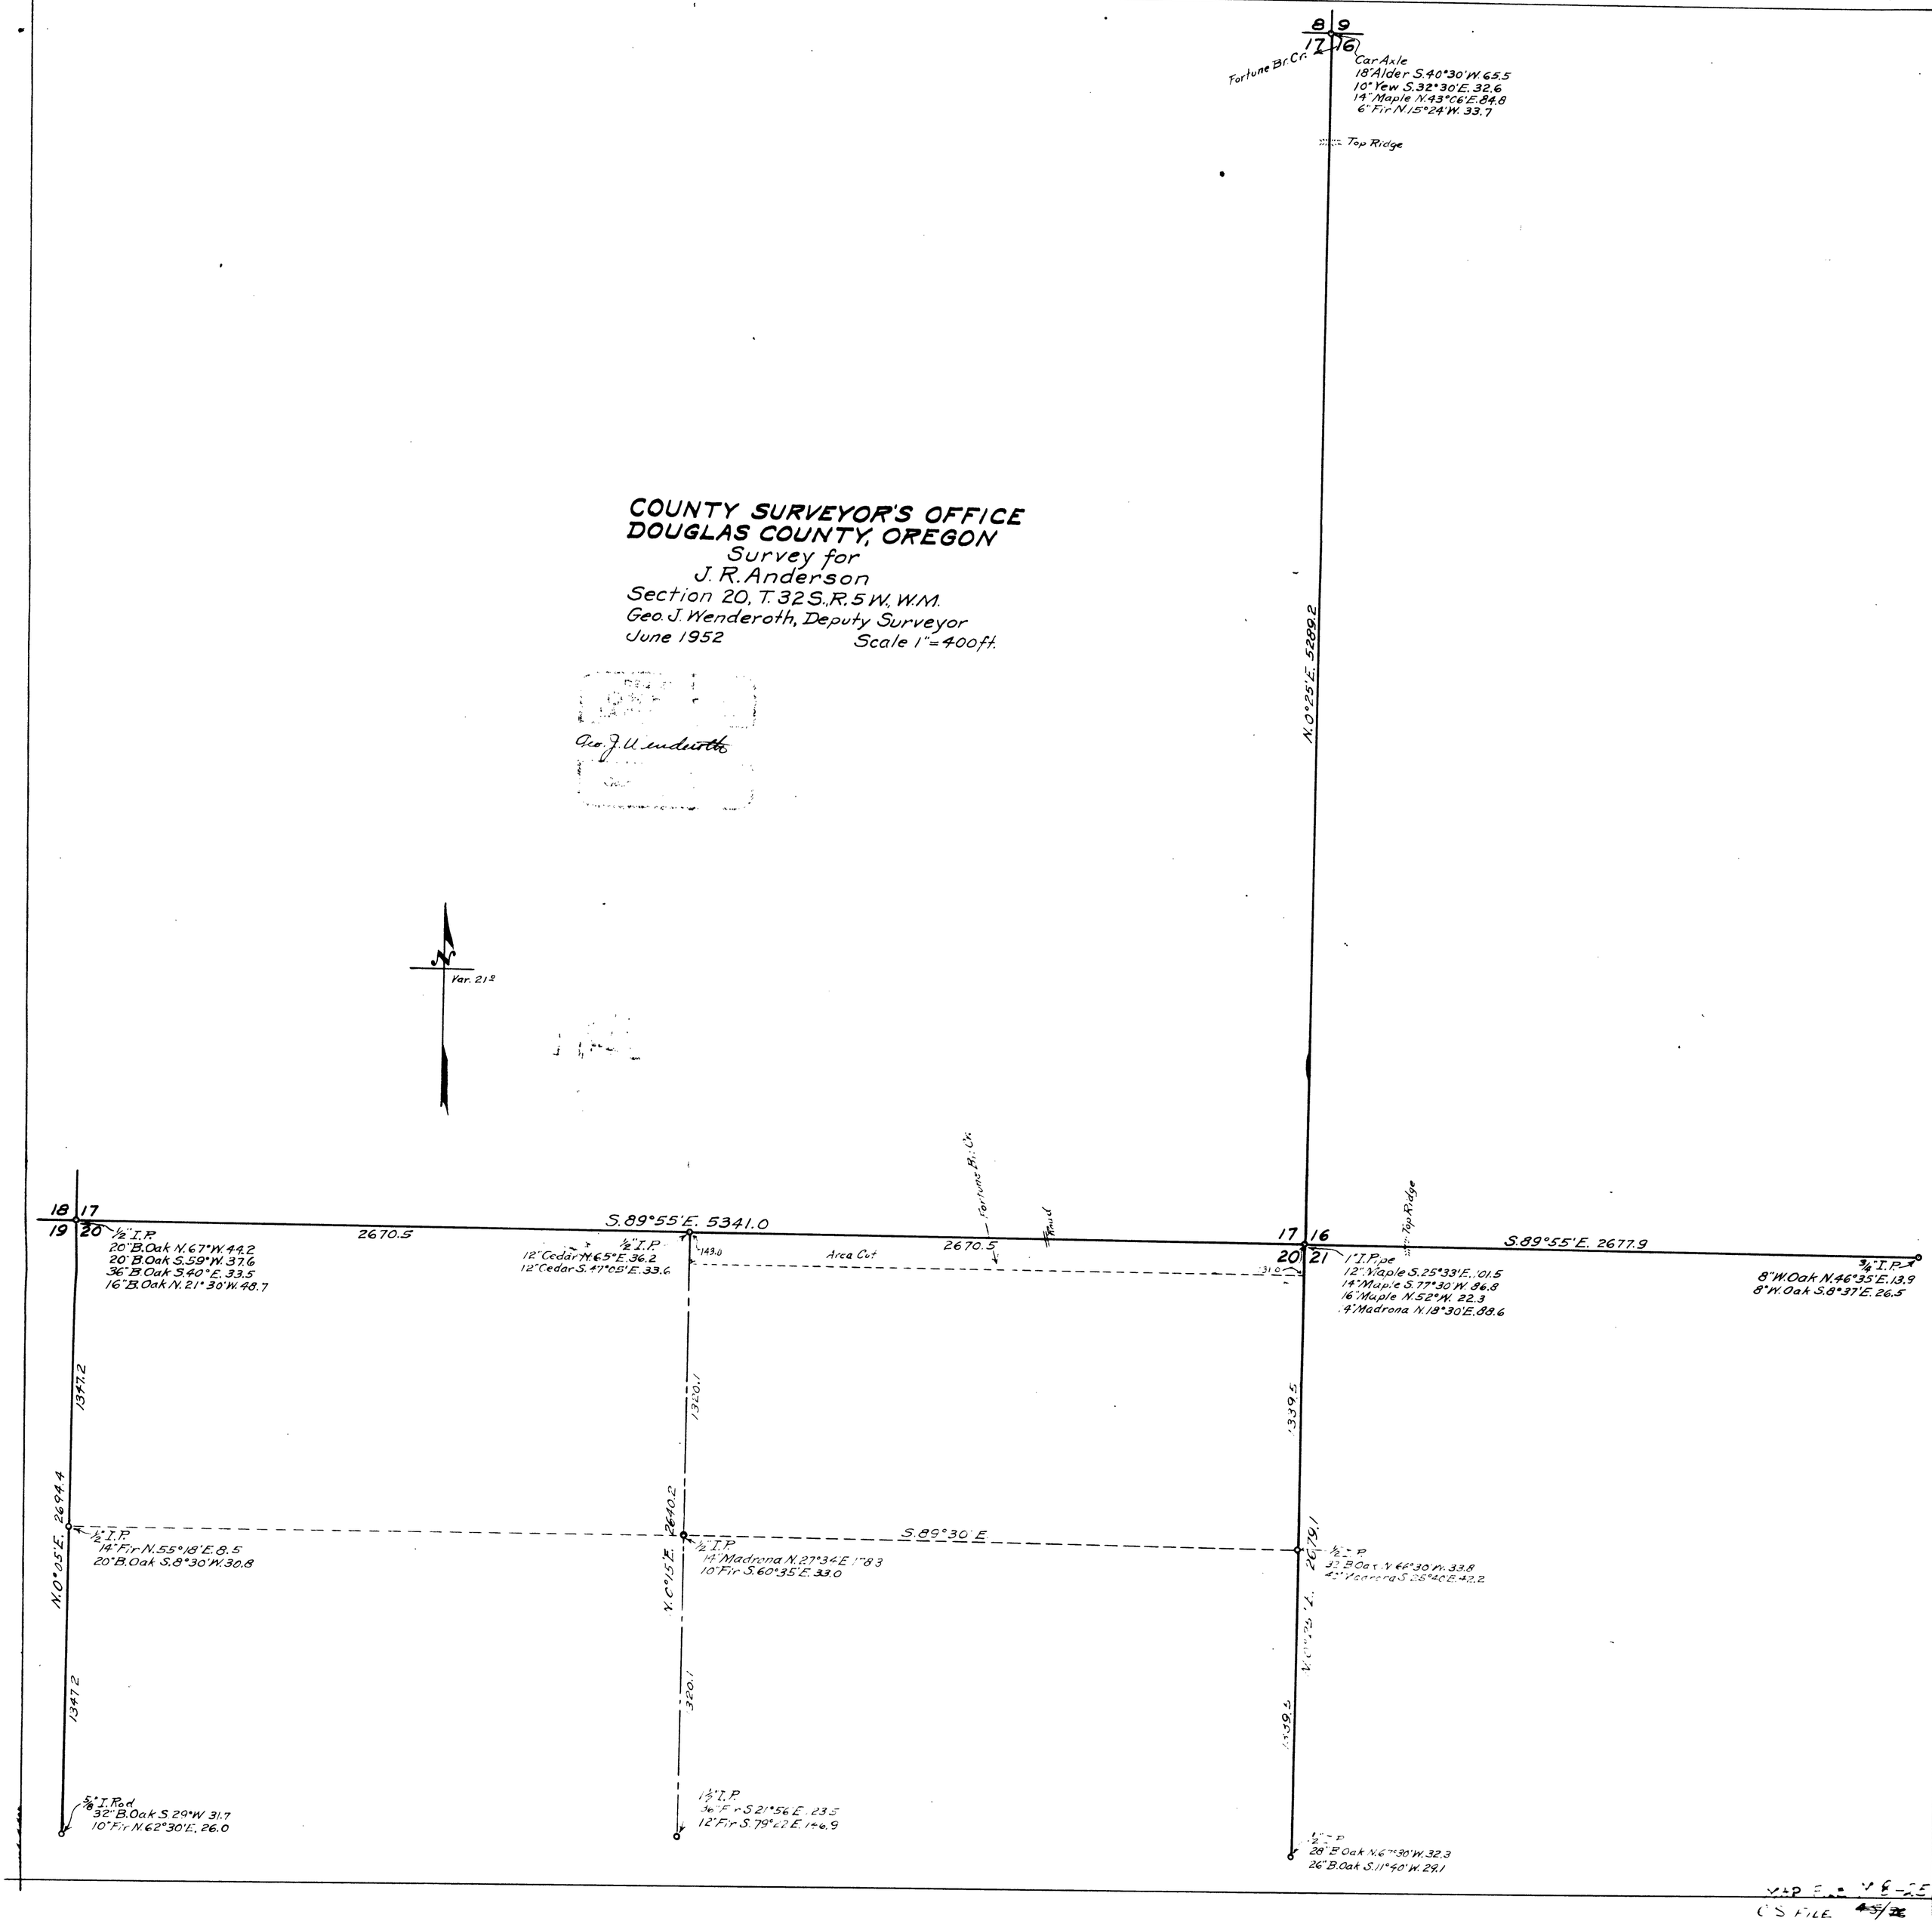

MAP E. 8-25
C.S. FILE 45/25
