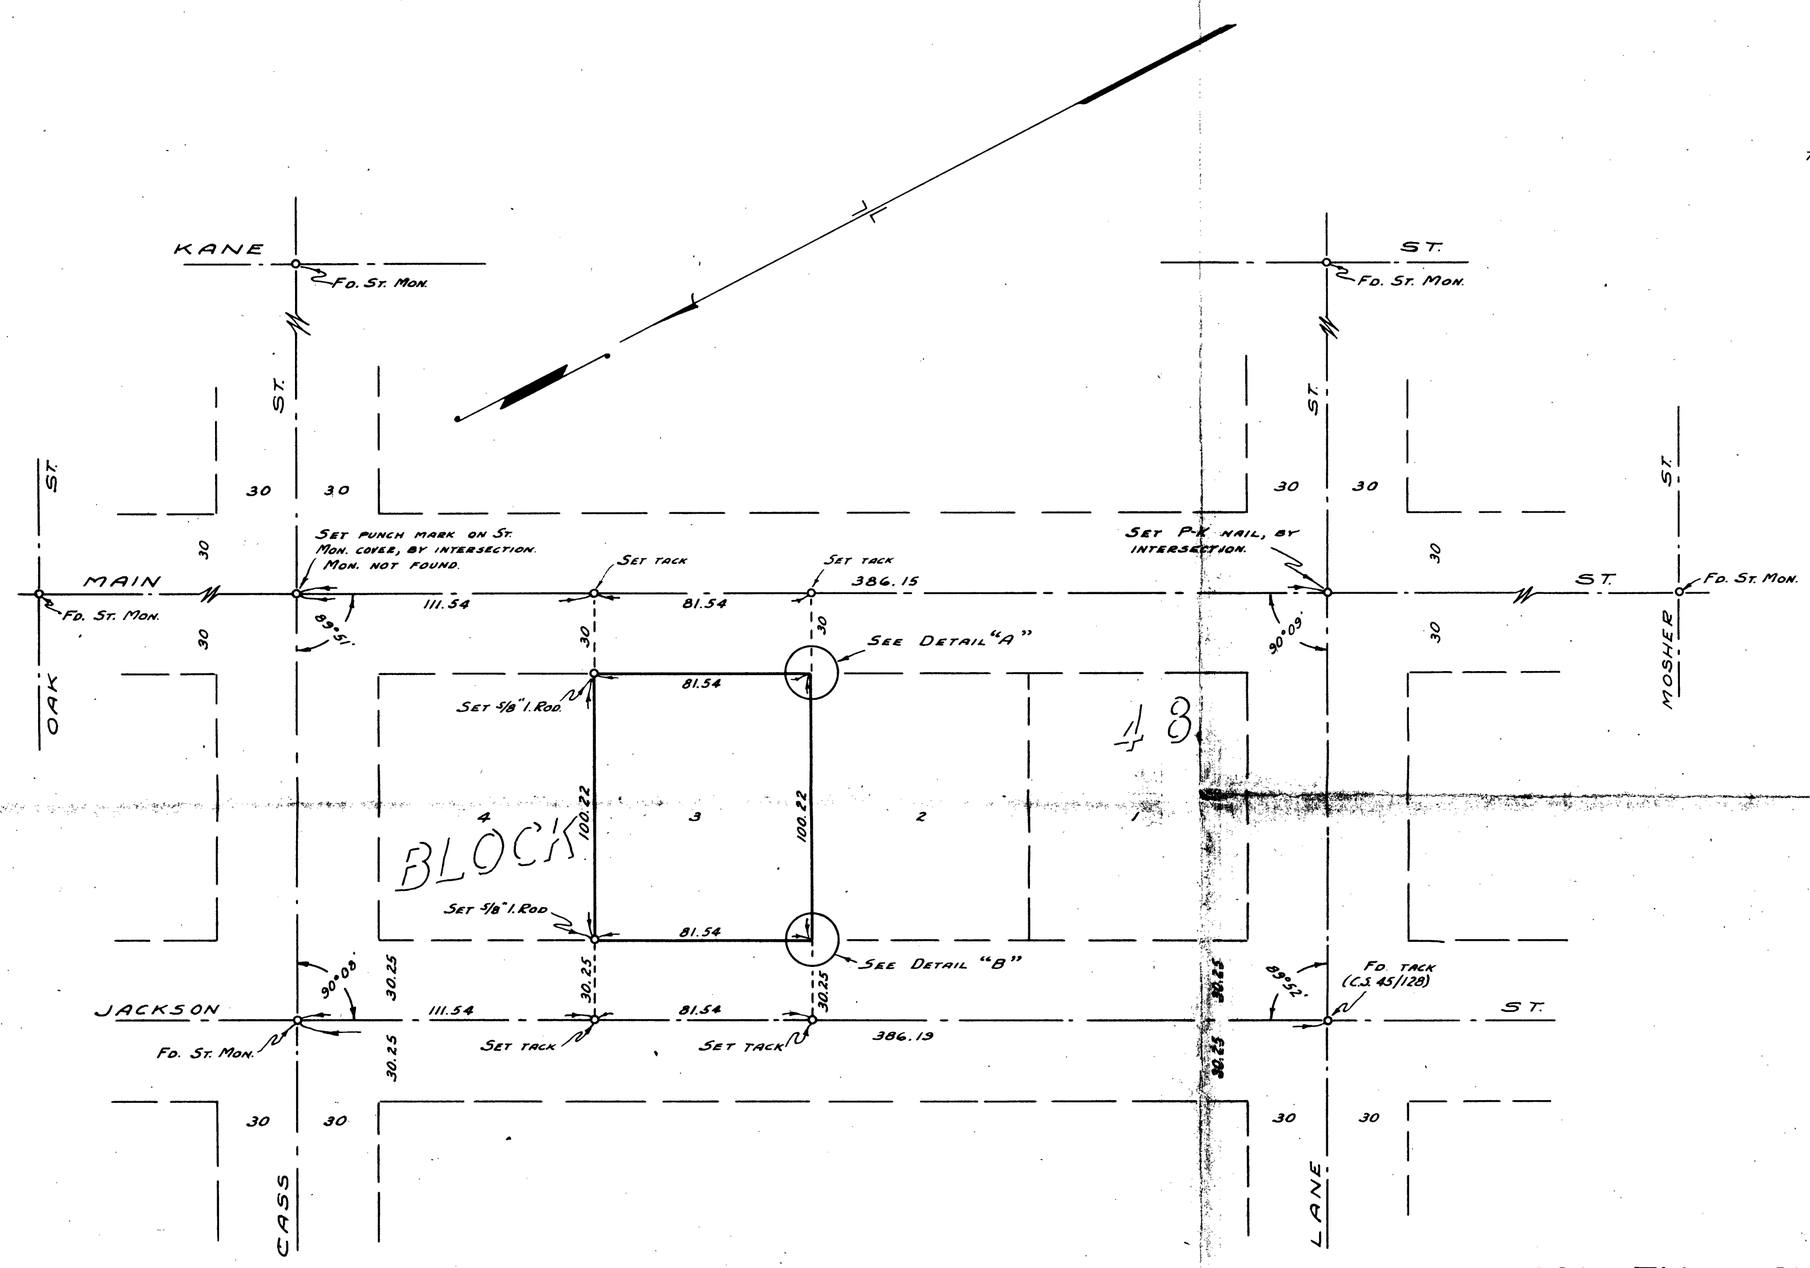

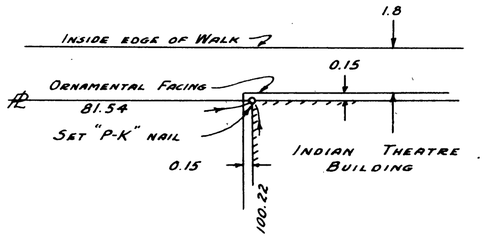

DETAIL "A"
(NOT TO SCALE)

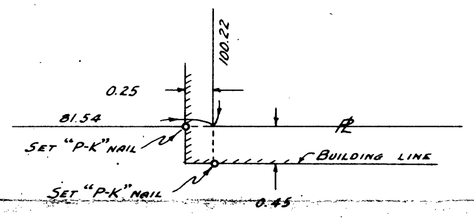

DETAIL "B"
(NOT TO SCALE)

COUNTY SURVEYOR'S OFFICE
DOUGLAS COUNTY, OREGON

SURVEY TO ESTABLISH LOT CORNERS, BLOCK 48, ROSEBURG OREGON.

BEN B. IRVING COUNTY SURVEYOR
SURVEYED MAY 12, 1953 SCALE 1" = 40'
SURVEYED FOR A. S. COEN C.S. FILE 45/86-1