RESET FROM ORIG. BT
12" FIR S58°E 50 LKS.
AND 18" FIR (DOWN)
N 83° W 153 LKS.
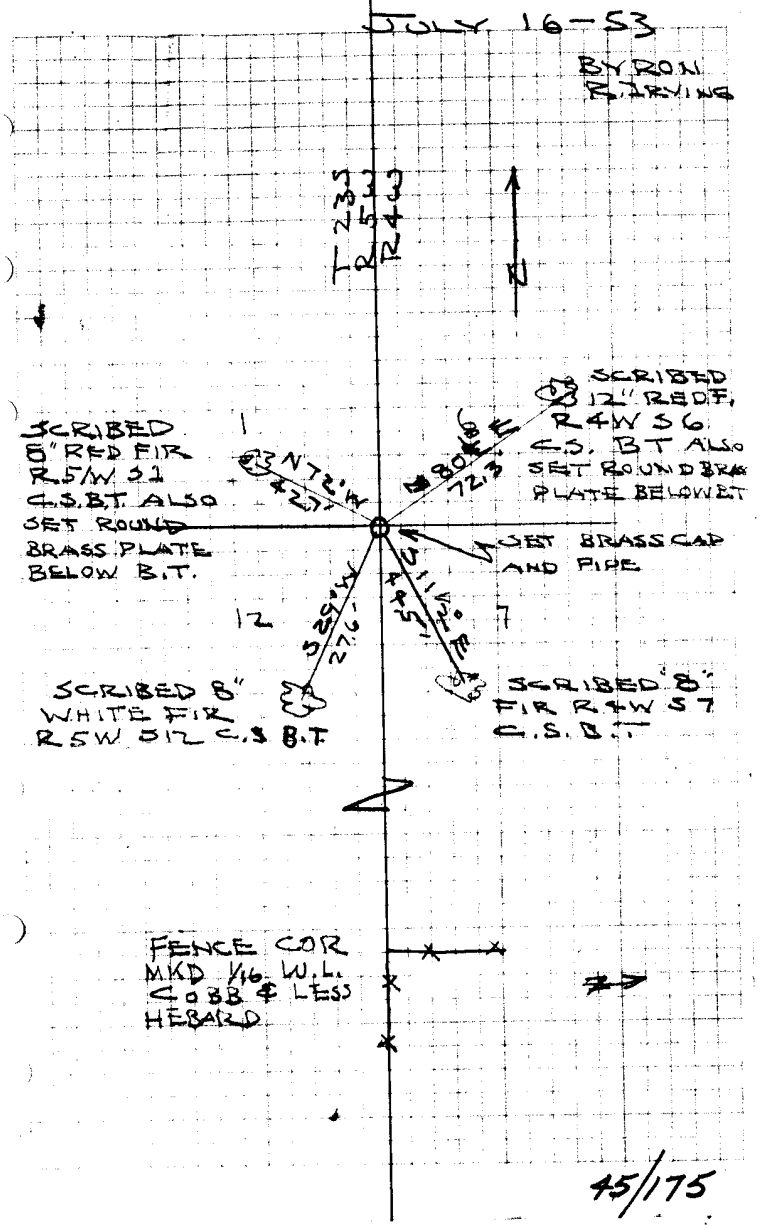
JULY 16-53
BYRON
R. IRVING