

MAP

SHOWING LOCATION OF
RESIDENCE ON & BOUNDARIES OF
NORTH 1/2, LOT 12, "FAIRMOUNT,"


IN THE
COUNTY OF DOUGLAS,
AND
STATE OF OREGON

SURVEYED 8-15-1953

SCALE 1" = 40'

I HEREBY CERTIFY THAT I HAVE SURVEYED THE ABOVE DESCRIBED PROPERTY,
AND THAT THE IMPROVEMENTS SHOWN AND DESCRIBED HEREON ARE WITHIN
THE PROPERTY LINES.

Ben B. Irving
BEN B. IRVING
COUNTY SURVEYOR

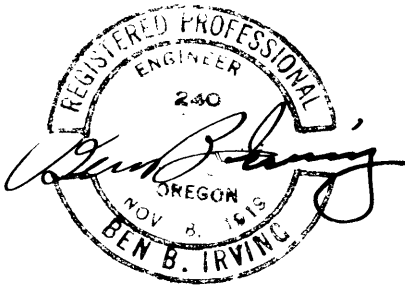

COUNTY SURVEYORS FILE DATA
DO NOT REMOVE FROM OFFICE

