# REFRENCE DATA for STONE MONUMENT on BROAD STREET

LOT 57 EDENBOWER ORCHARD TRACTS

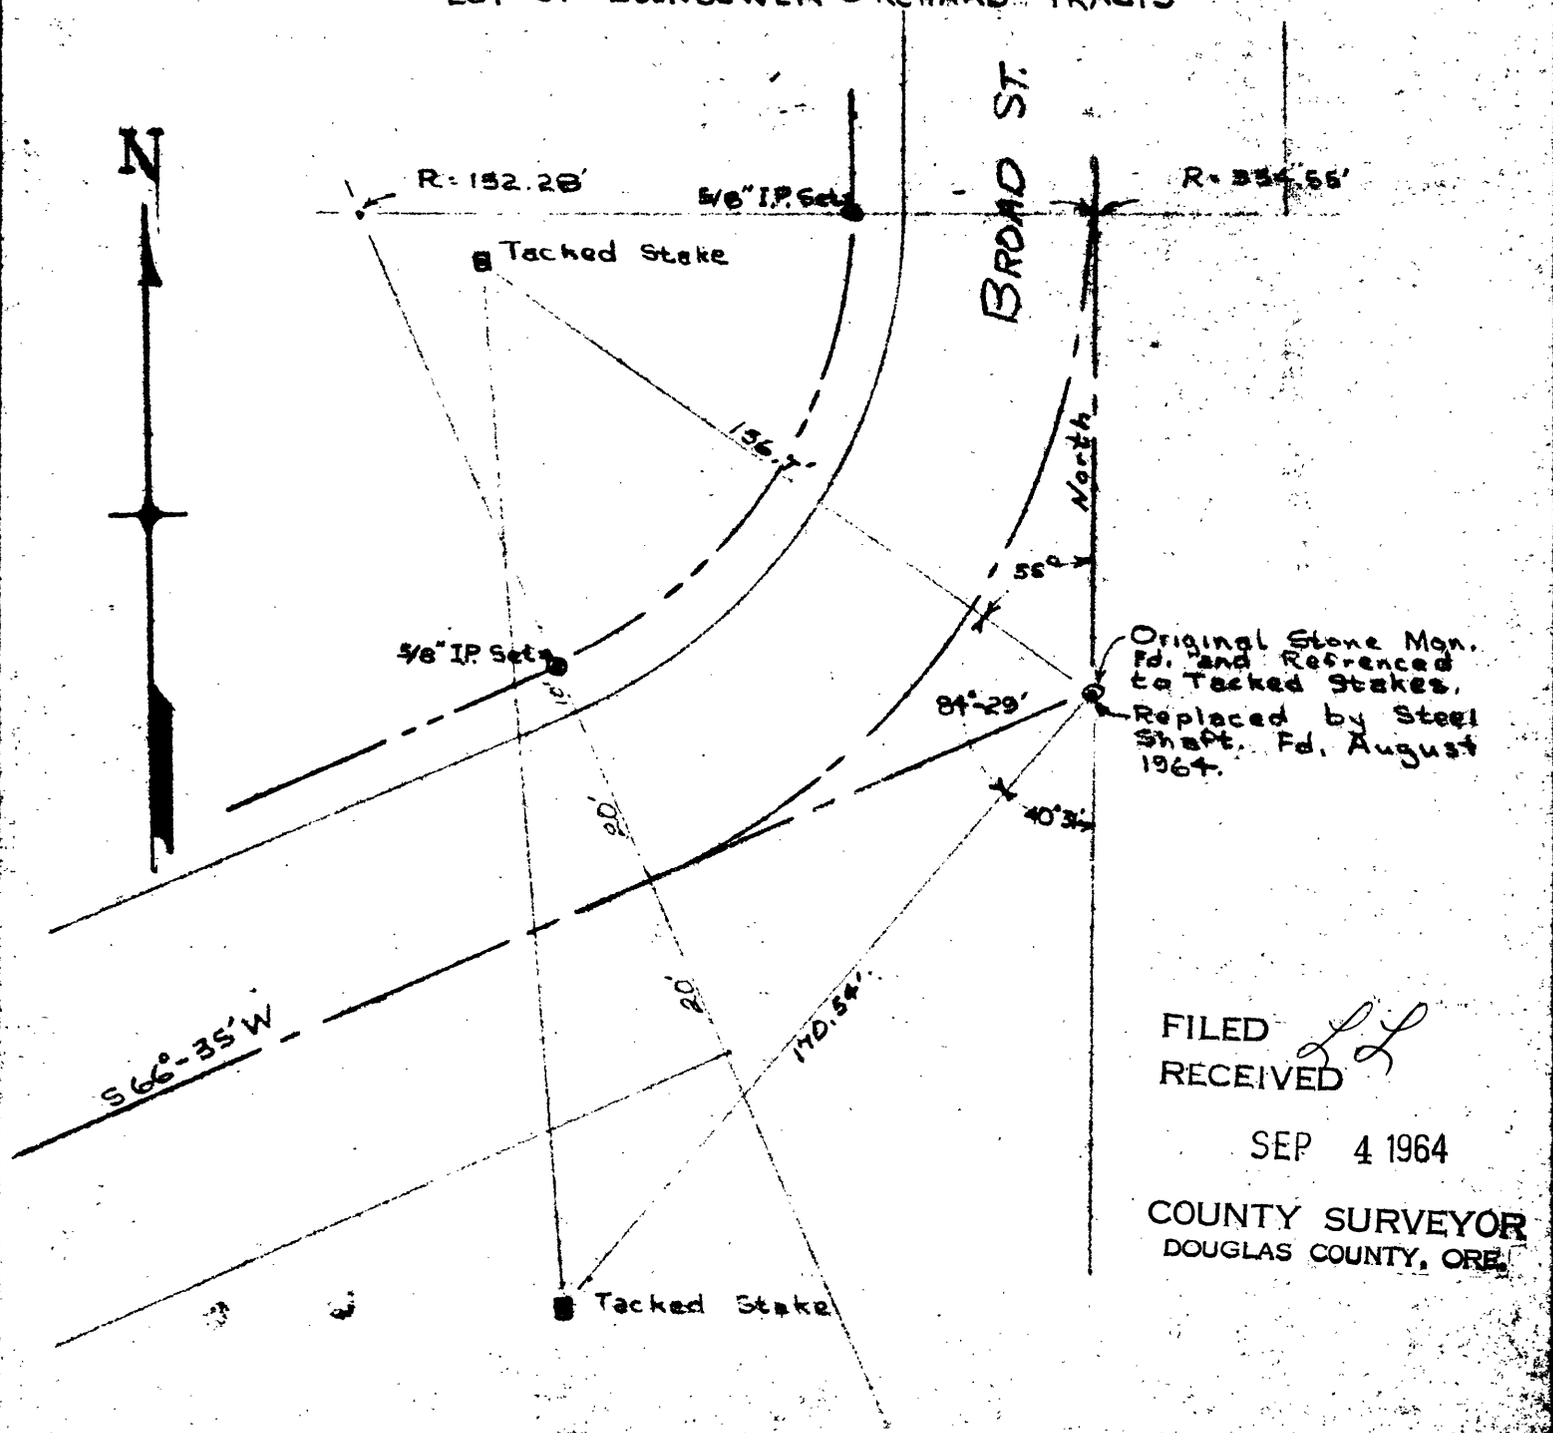


FILED
RECEIVED
SEP 4 1964
COUNTY SURVEYOR
DOUGLAS COUNTY, ORE.

NOTE: STATE HIGHWAY REFRENCE DATA USED TO TACKED STAKES SEE SURVEY OF LOTS 51 AND 57 EDENBOWER ORCHARD TRACTS AUGUST 8, 1964.

SCALE: 1" = 40'

August 8, 1964

C.S File 51/298

Map File M28 F 56

JAMES R. DAUGHERTY
CIVIL-SANITARY ENGINEER
WINSTON, OREGON

DO NOT REMOVE FROM FILE