Aug. 1951

COUNTY SURVEYOR'S OFFICE
DOUGLAS COUNTY, OREGON.
Surveys in
SECTION 12, T. 32 S., R. 5 W., W.M.

Geo J. Wendroth

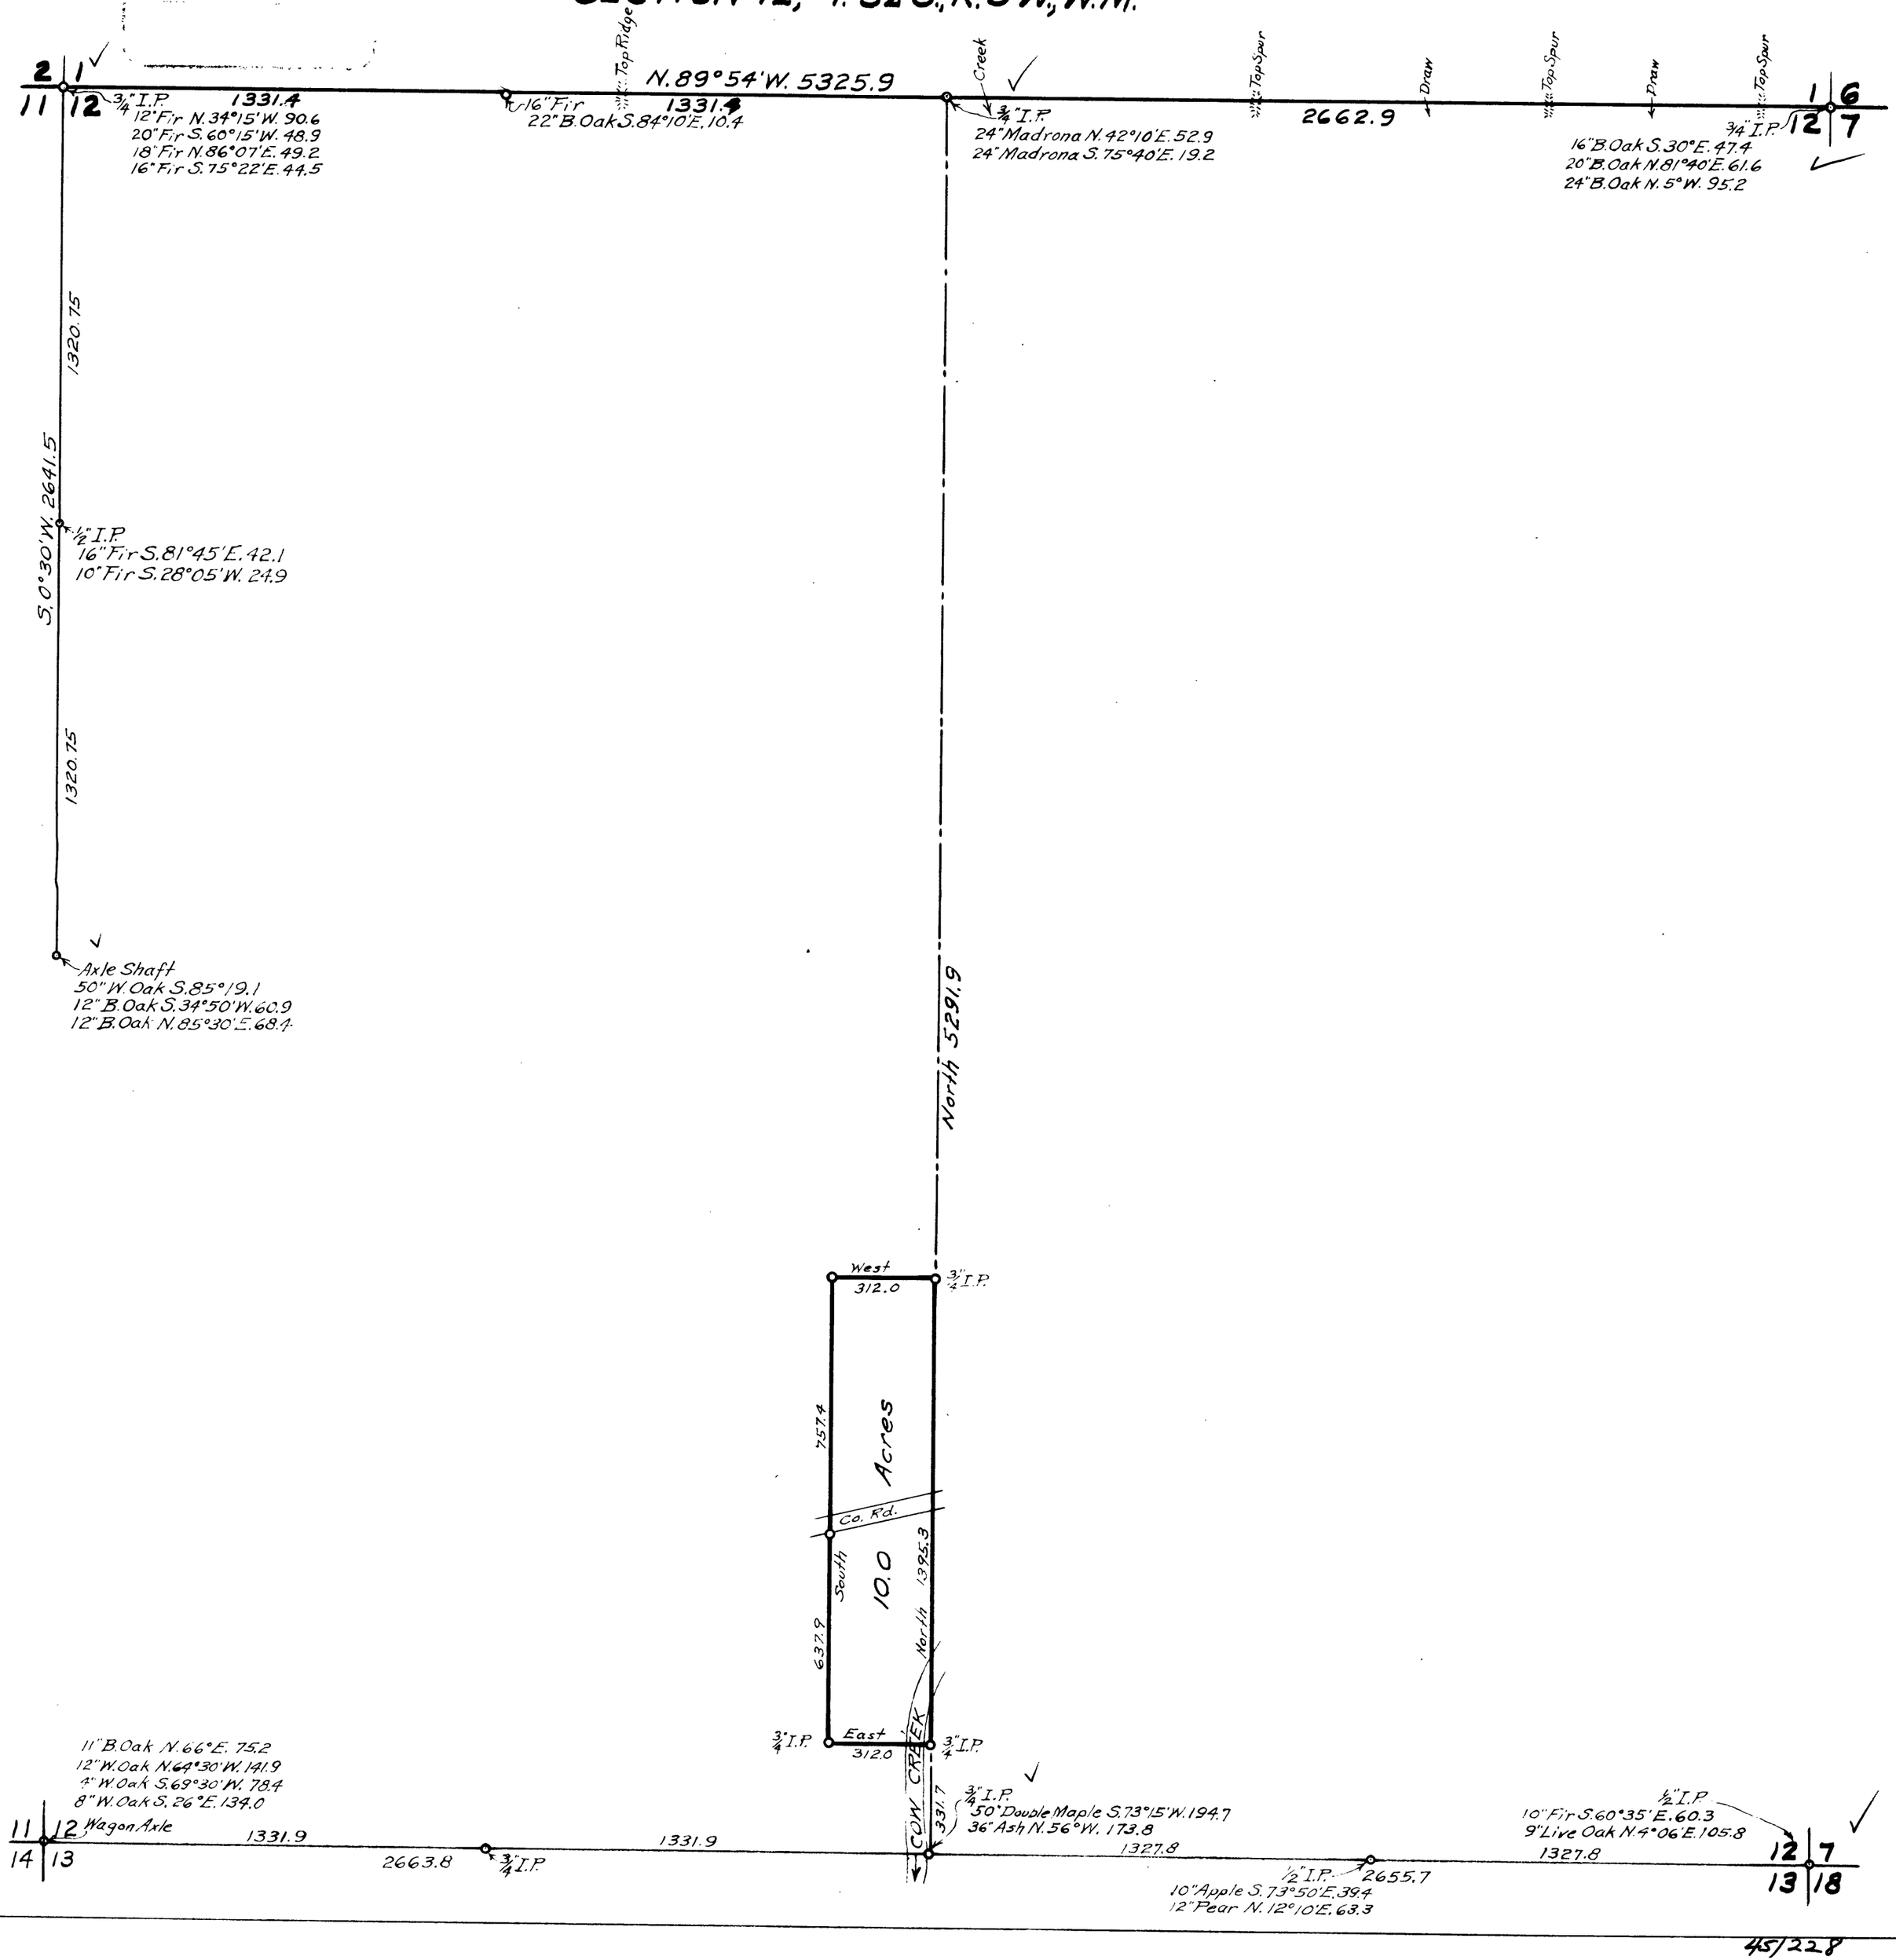

45/228