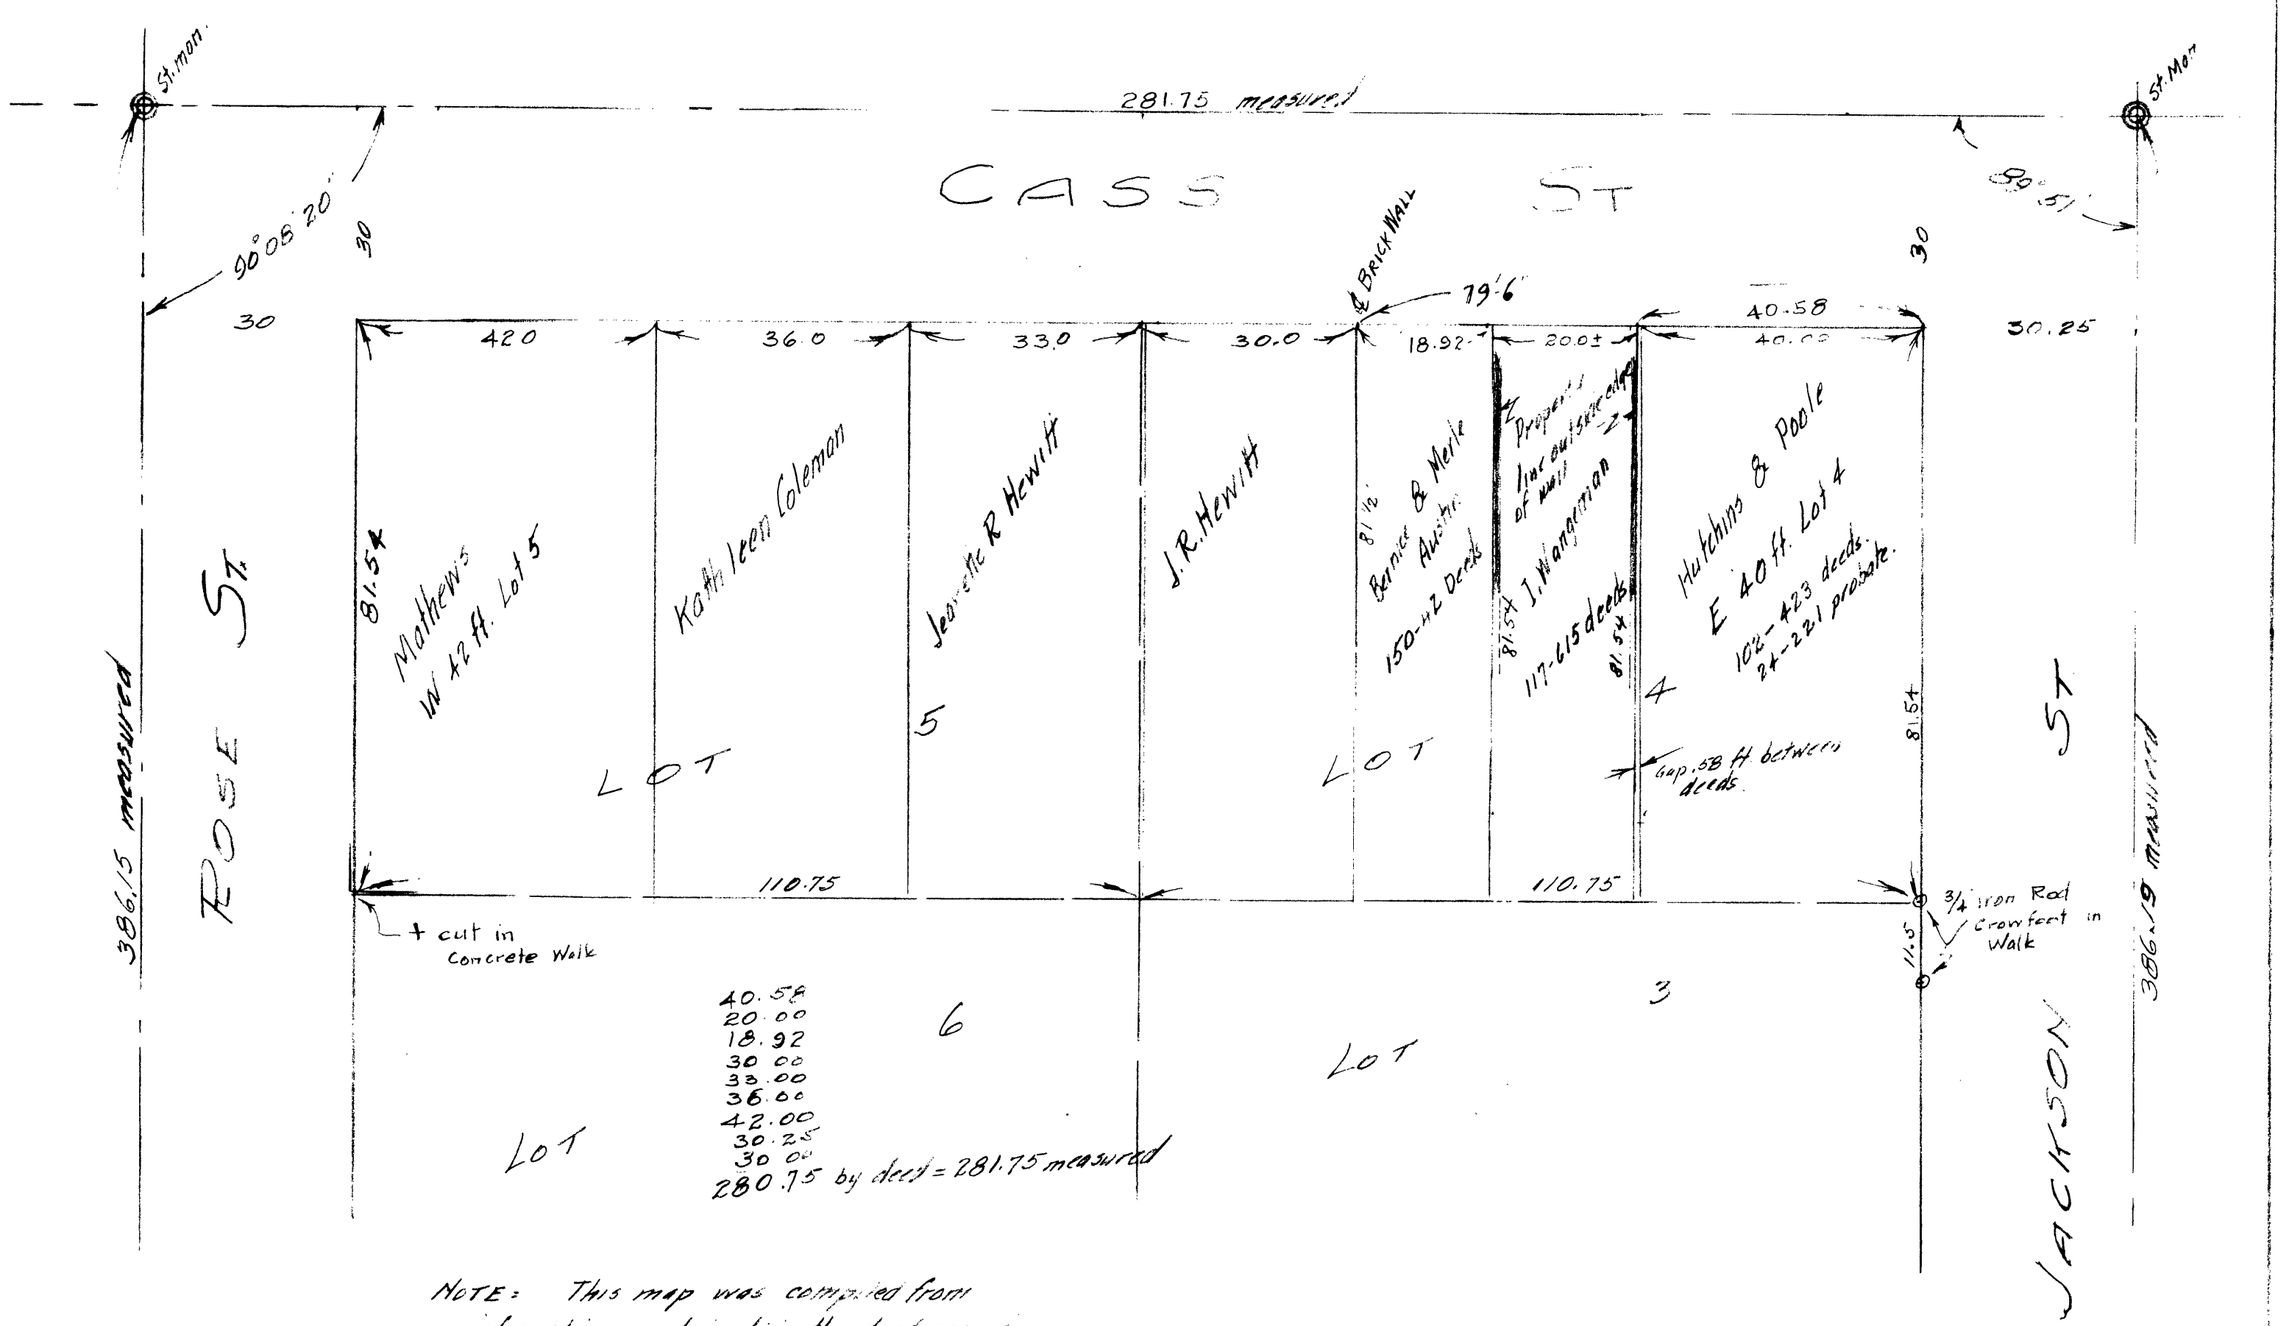

NOTE: This map was compiled from information contained in the deed records and data from a survey of Lots 3 & 5 block 49 by this office.

PART OF BLOCK 49
ROSEBURG ORE
showing relationship of deeds
FACING CASS STREET

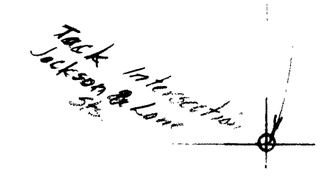

COUNTY SURVEYORS FILE DATA
DO NOT REMOVE FROM OFFICE

Compiled by
BEN B. IRVING. County Surveyor
April 9, 1954

C.S. FILE No. 45/264