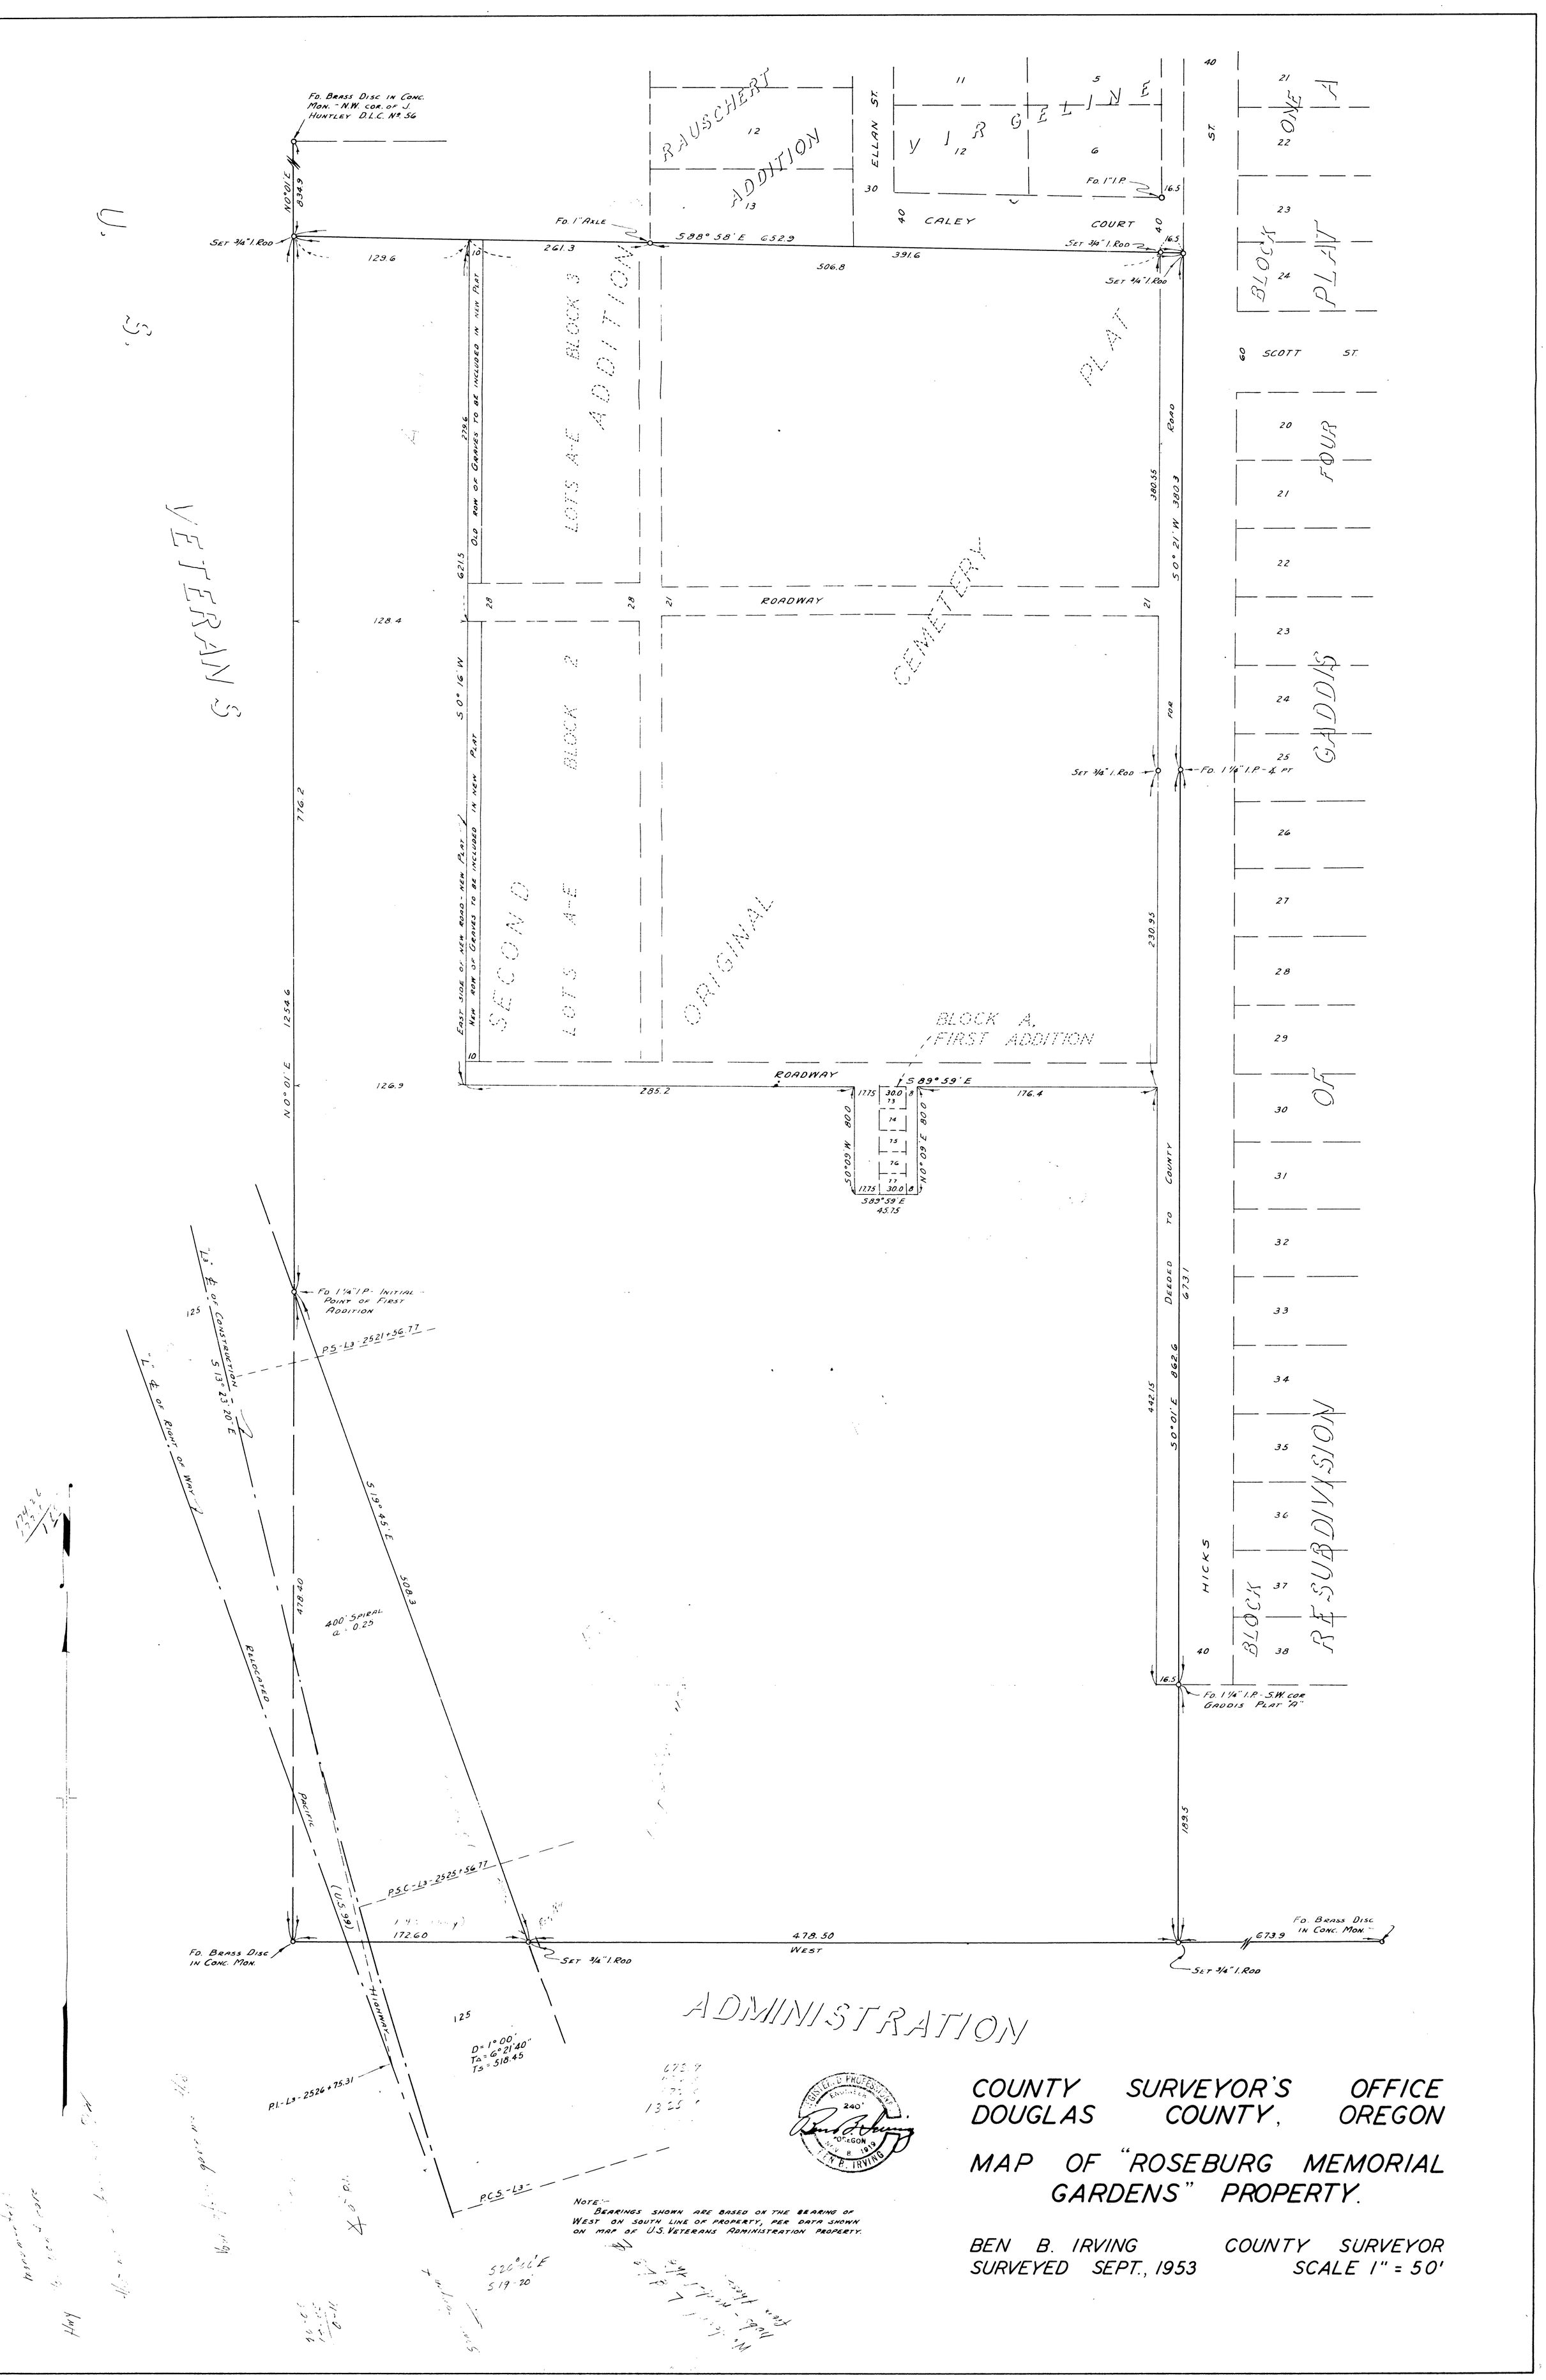

COUNTY SURVEYOR'S OFFICE
DOUGLAS COUNTY, OREGON

MAP OF "ROSEBURG MEMORIAL GARDENS" PROPERTY.

BEN B. IRVING — COUNTY SURVEYOR
SURVEYED SEPT., 1953 — SCALE 1" = 50'

CS 46/57

C.S. FILE 46/57