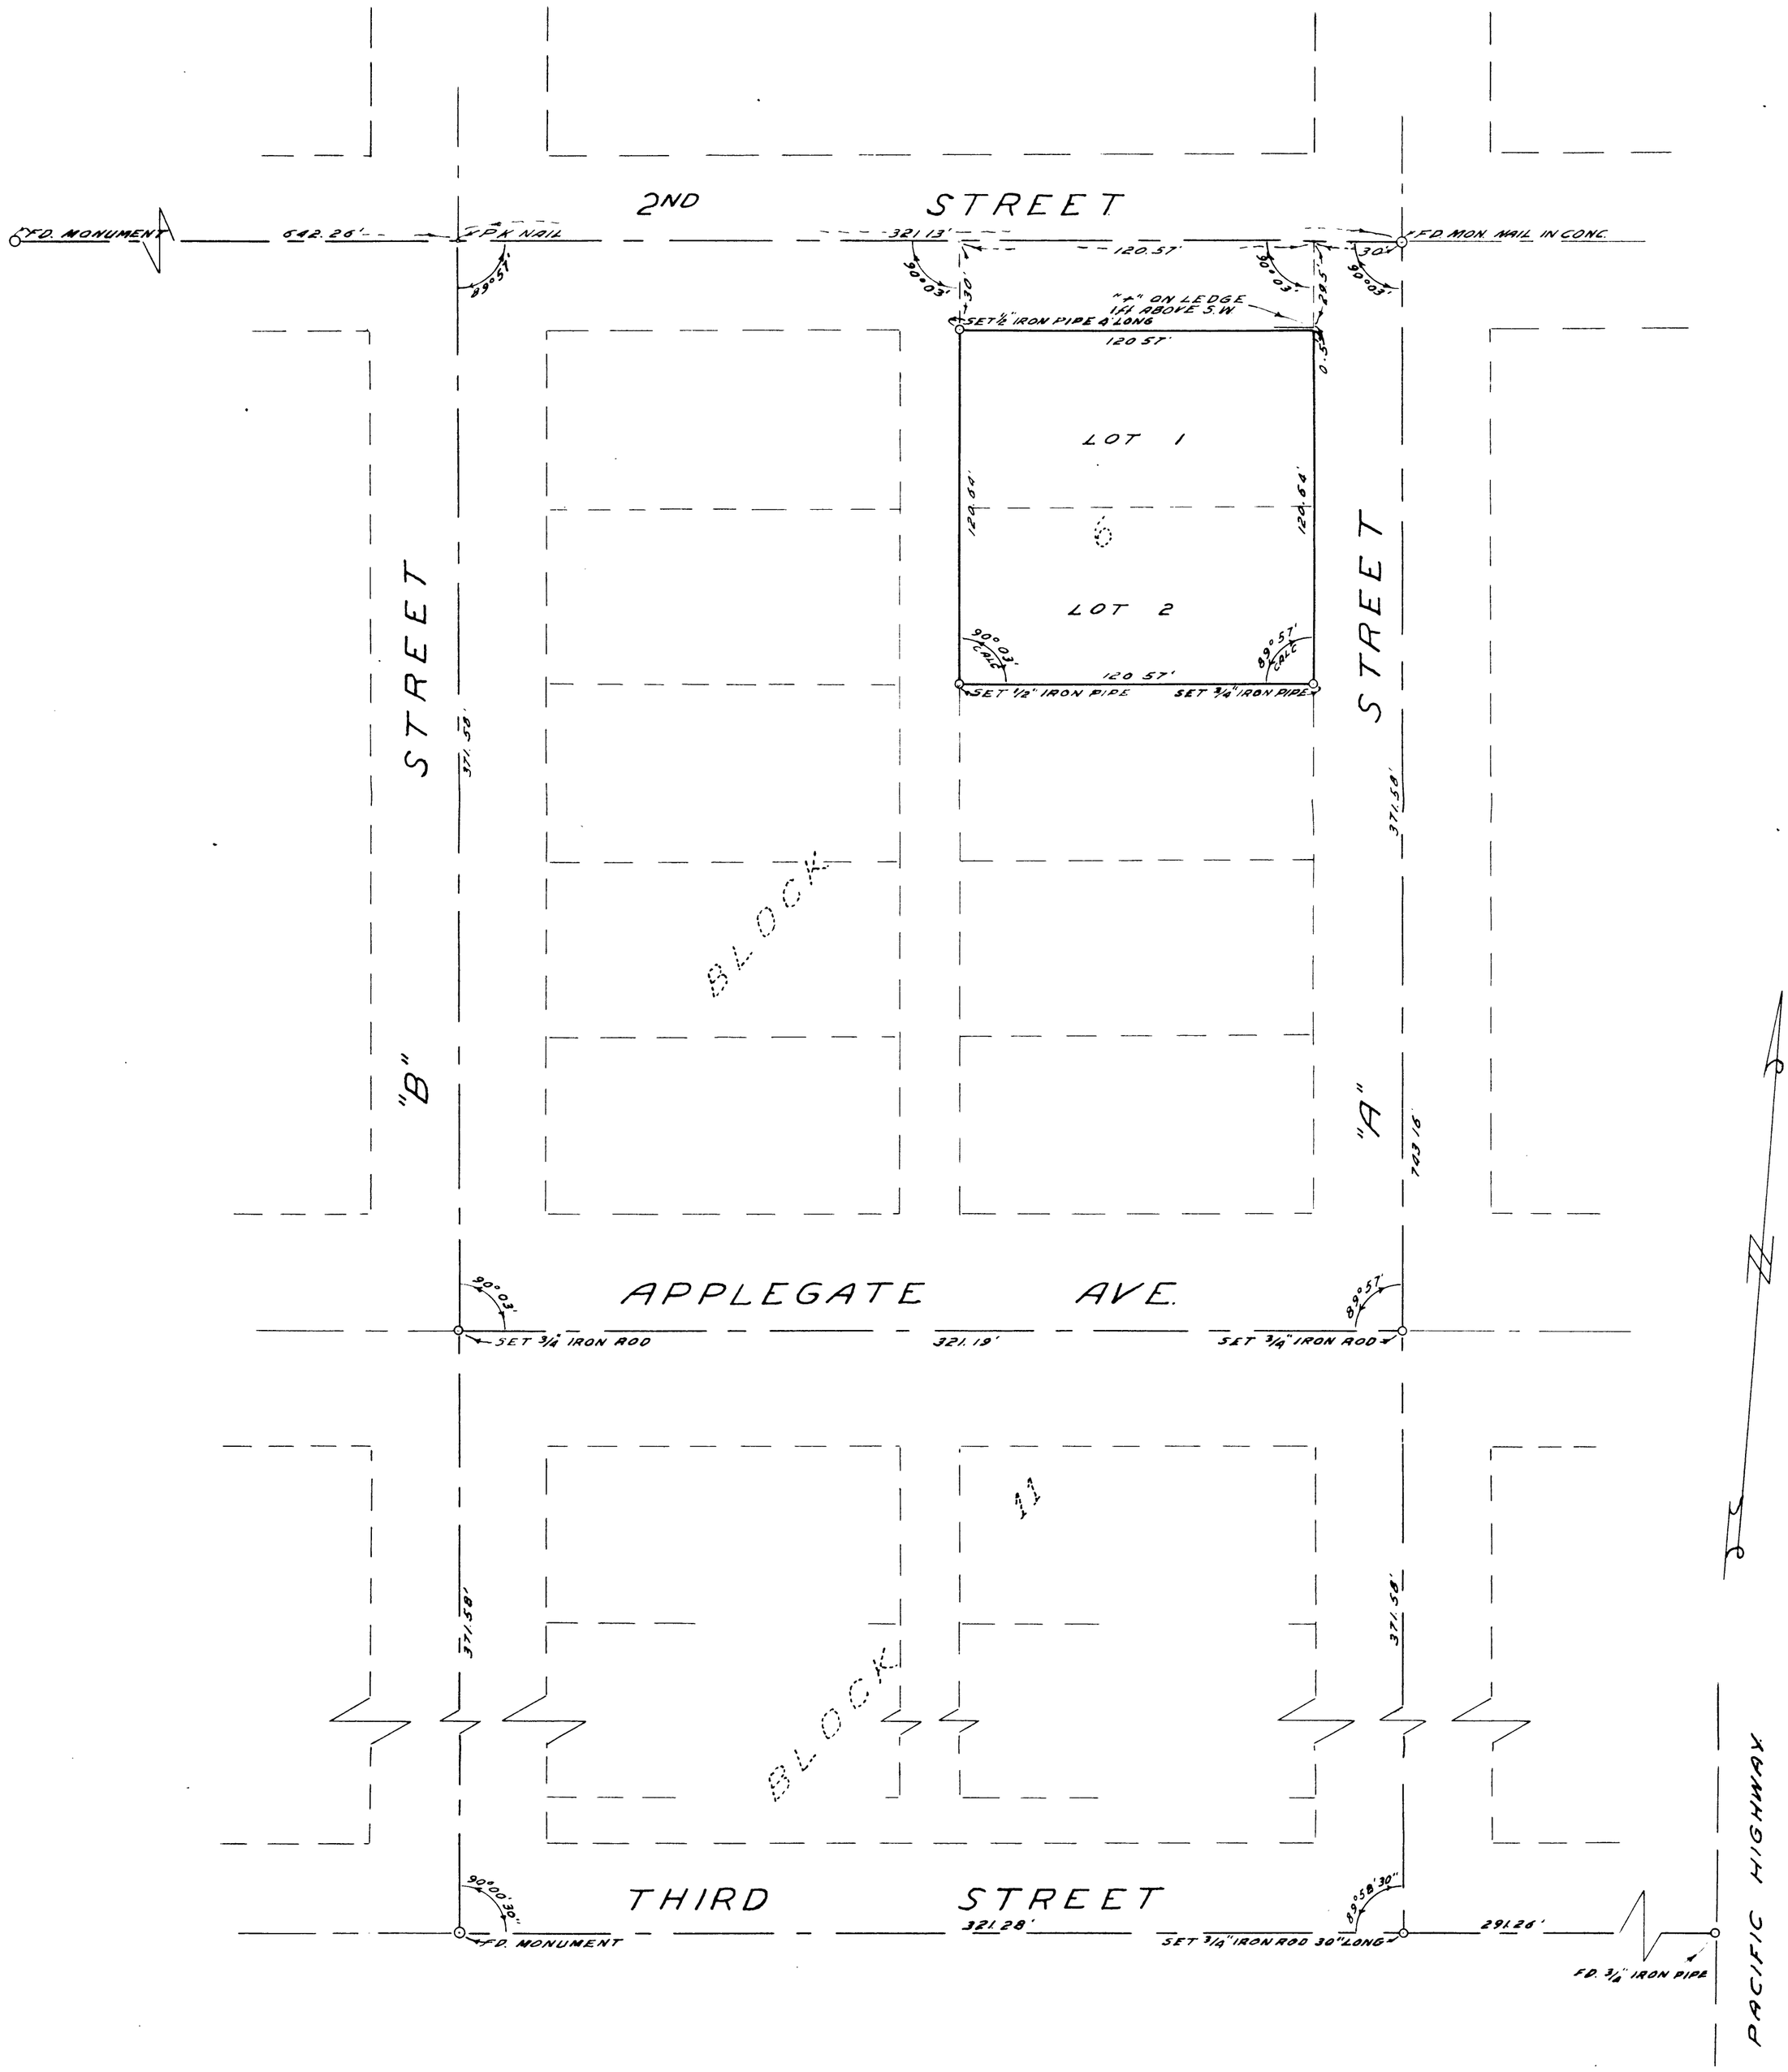

COUNTY SURVEYOR'S OFFICE
DOUGLAS COUNTY, OREGON

SURVEY OF LOTS 1 & 2 BLOCK 6
YONCALLA

REGISTERED OREGON LAND SURVEYOR
James W. Byron
JAMES W. BYRON
303

BEN B. IRVING — COUNTY SURVEYOR
SURVEYED DEC. 15, 1954 — BY
JAMES W. BYRON - DEPUTY — SCALE 1" = 40'
SURVEYED FOR — RUSSELL

C. S. File No. 46/81-2