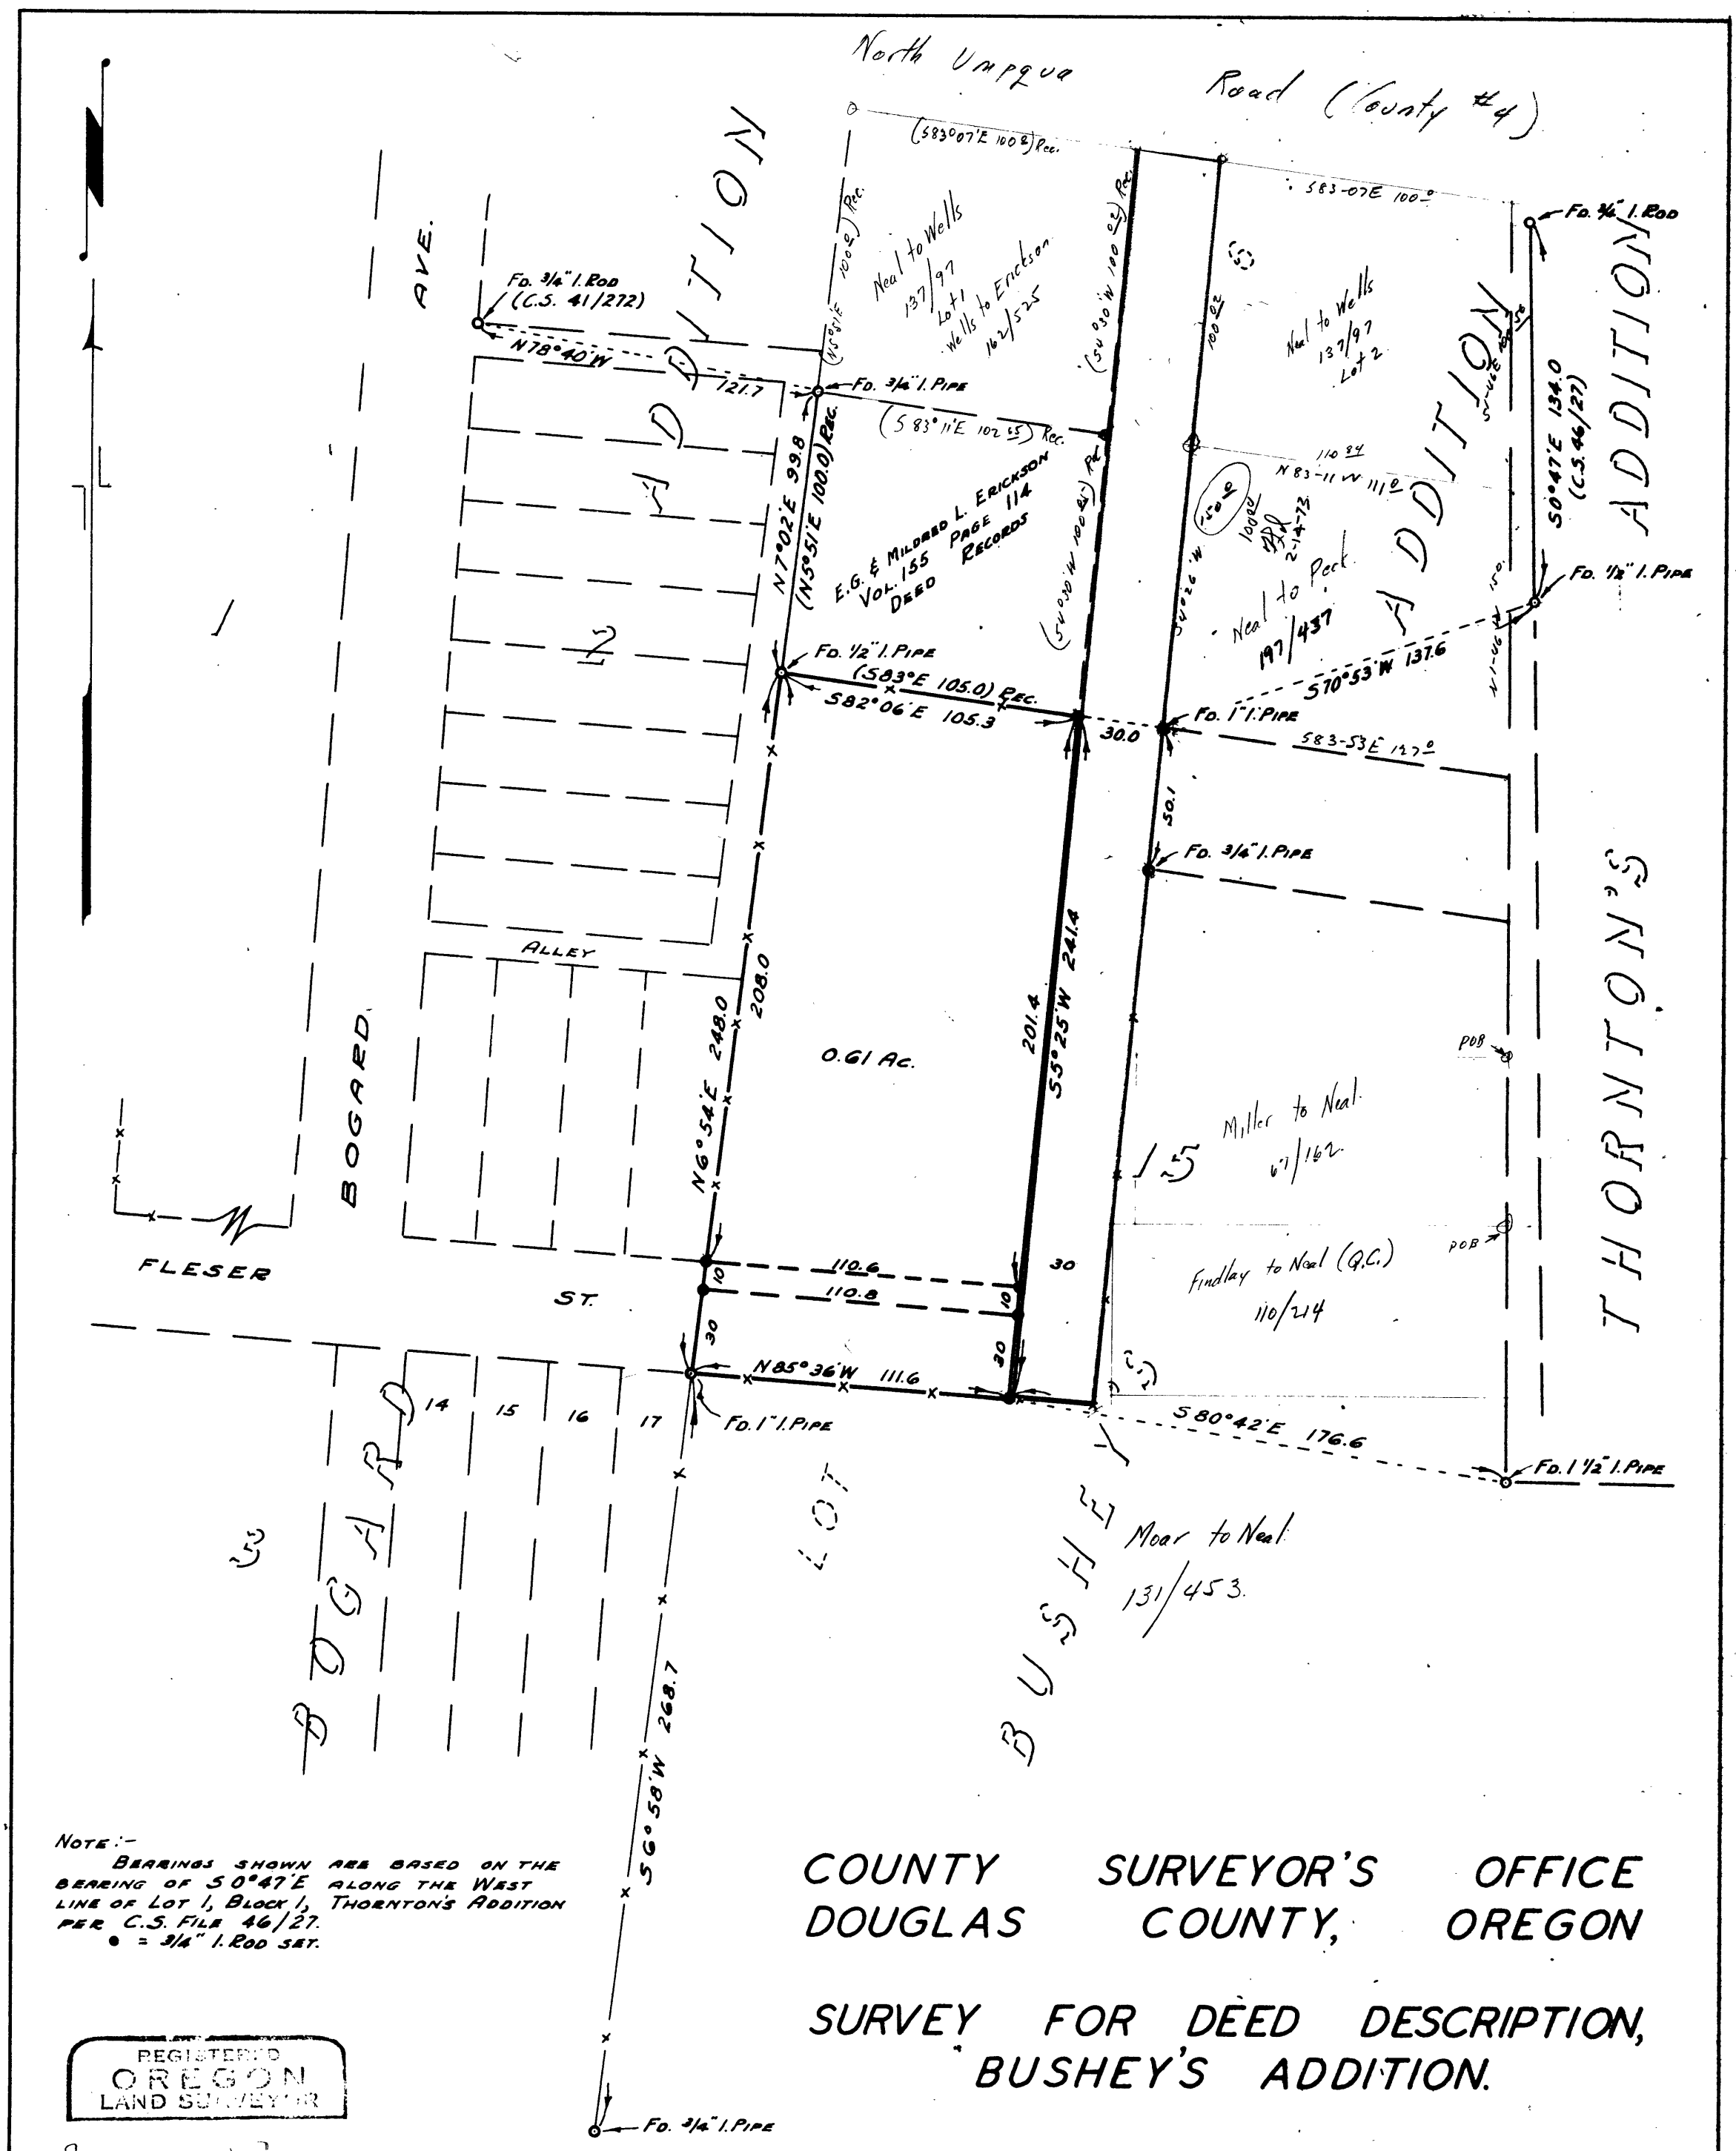

NOTE:-
BEARINGS SHOWN ARE BASED ON THE BEARING OF S 0°47'E ALONG THE WEST LINE OF LOT 1, BLOCK 1, THORNTON'S ADDITION PER C.S. FILE 46/27.
● = 3/4" I. ROD SET.

REGISTERED OREGON LAND SURVEYOR

James W. Byron

NOV. 6, 1953
JAMES W. BYRON
303

COUNTY SURVEYOR'S OFFICE
DOUGLAS COUNTY, OREGON

SURVEY FOR DEED DESCRIPTION, BUSHEY'S ADDITION.

BEN B. IRVING — COUNTY SURVEYOR
SURVEYED MARCH, 1955 — BY
JAMES W. BYRON - DEPUTY — SCALE 1" = 50'
SURVEYED FOR A. M. NEALE

~~C.S. File 46/127~~

C. S. File No. 46/129