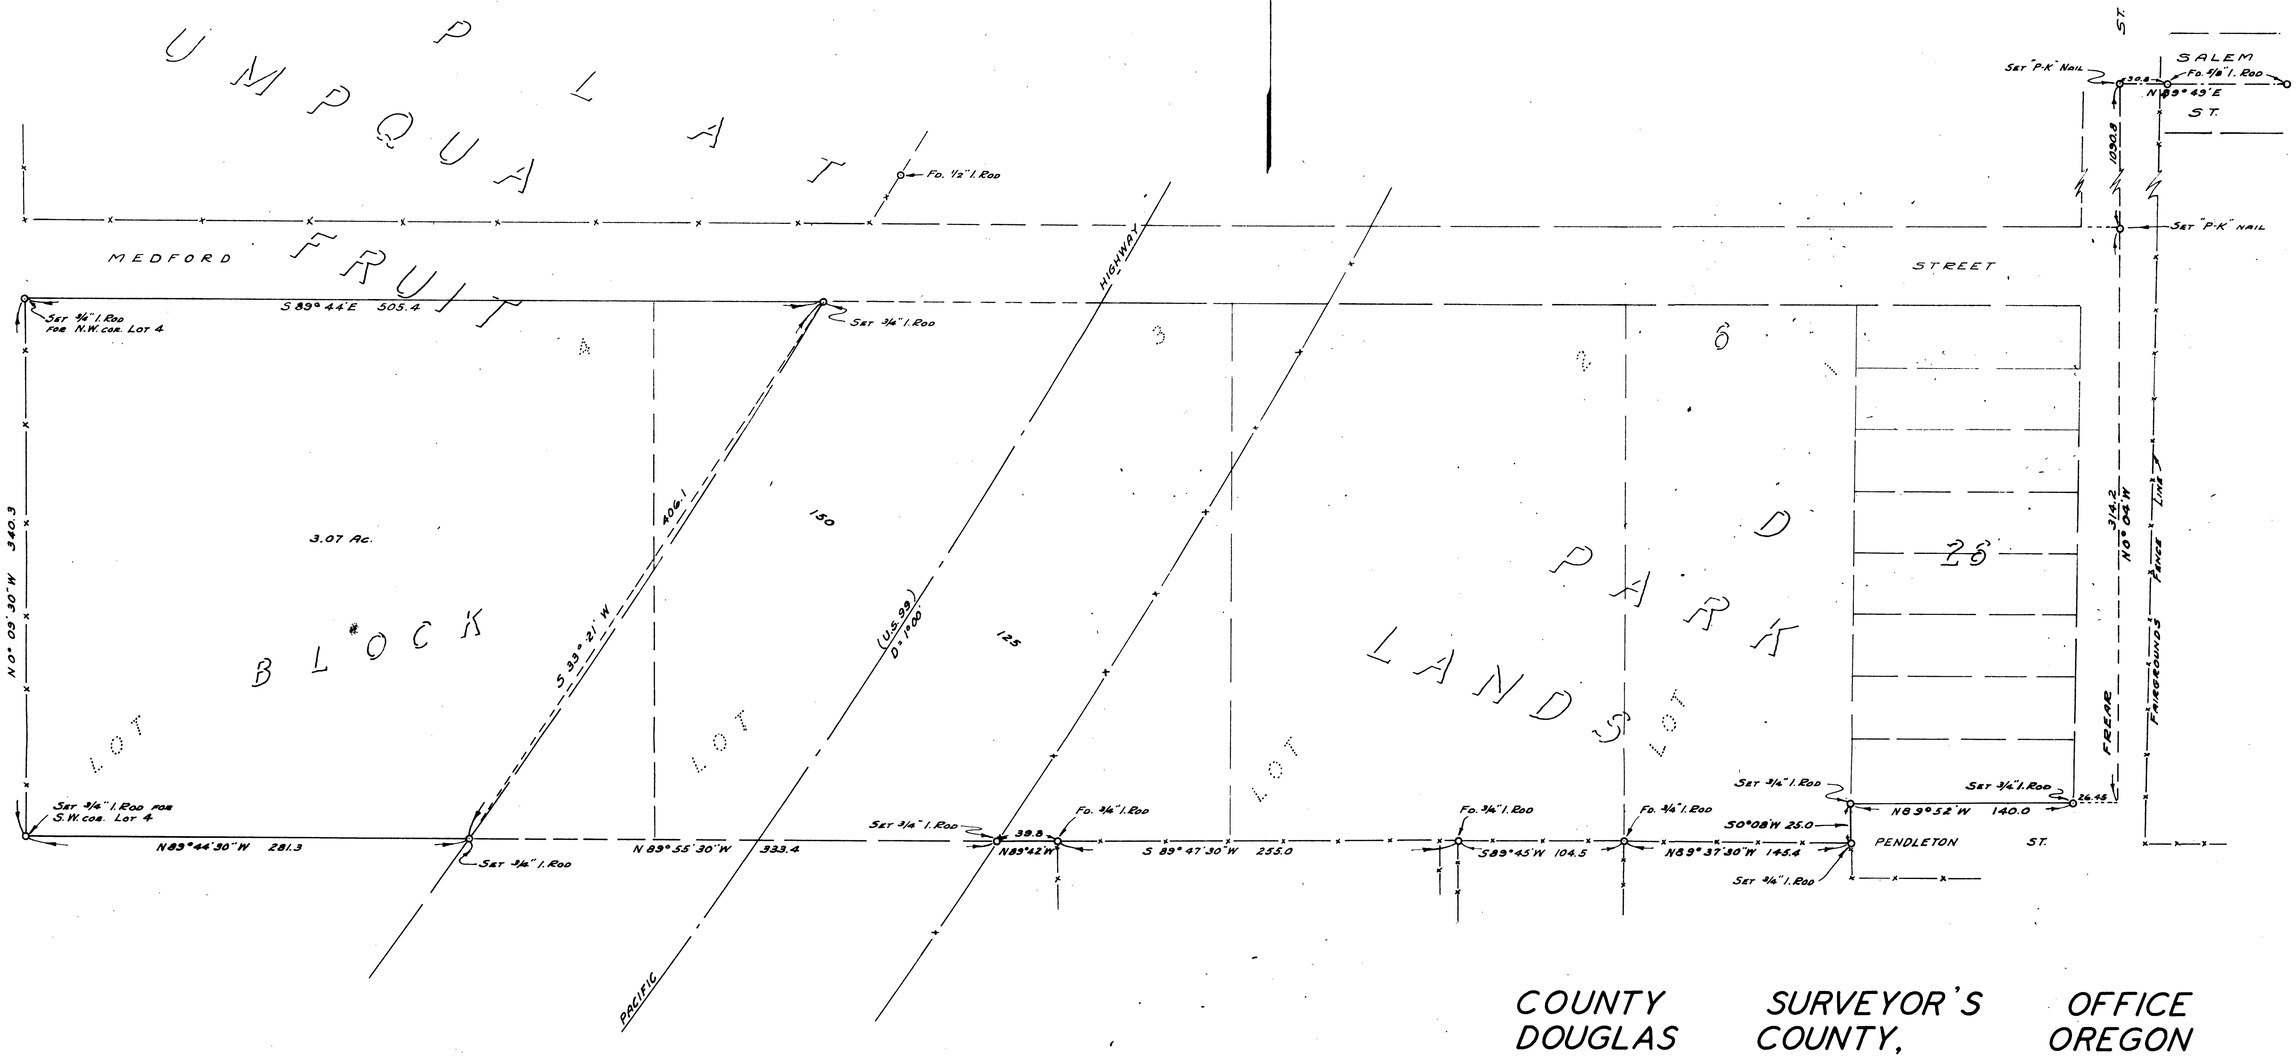

REGISTERED OREGON LAND SURVEYOR
James W. Byron
NOV. 6, 1973
JAMES W. BYRON
303

COUNTY SURVEYOR'S OFFICE
DOUGLAS COUNTY, OREGON

SURVEY TO ESTABLISH PROPERTY CORNERS.

BEN B. IRVING — COUNTY SURVEYOR
SURVEYED APRIL, 1955 — BY
JAMES W. BYRON — DEPUTY — SCALE 1" = 50'
SURVEYED FOR DOUGLAS COUNTY FAIRBOARD

C. S. File No. 46/135-2