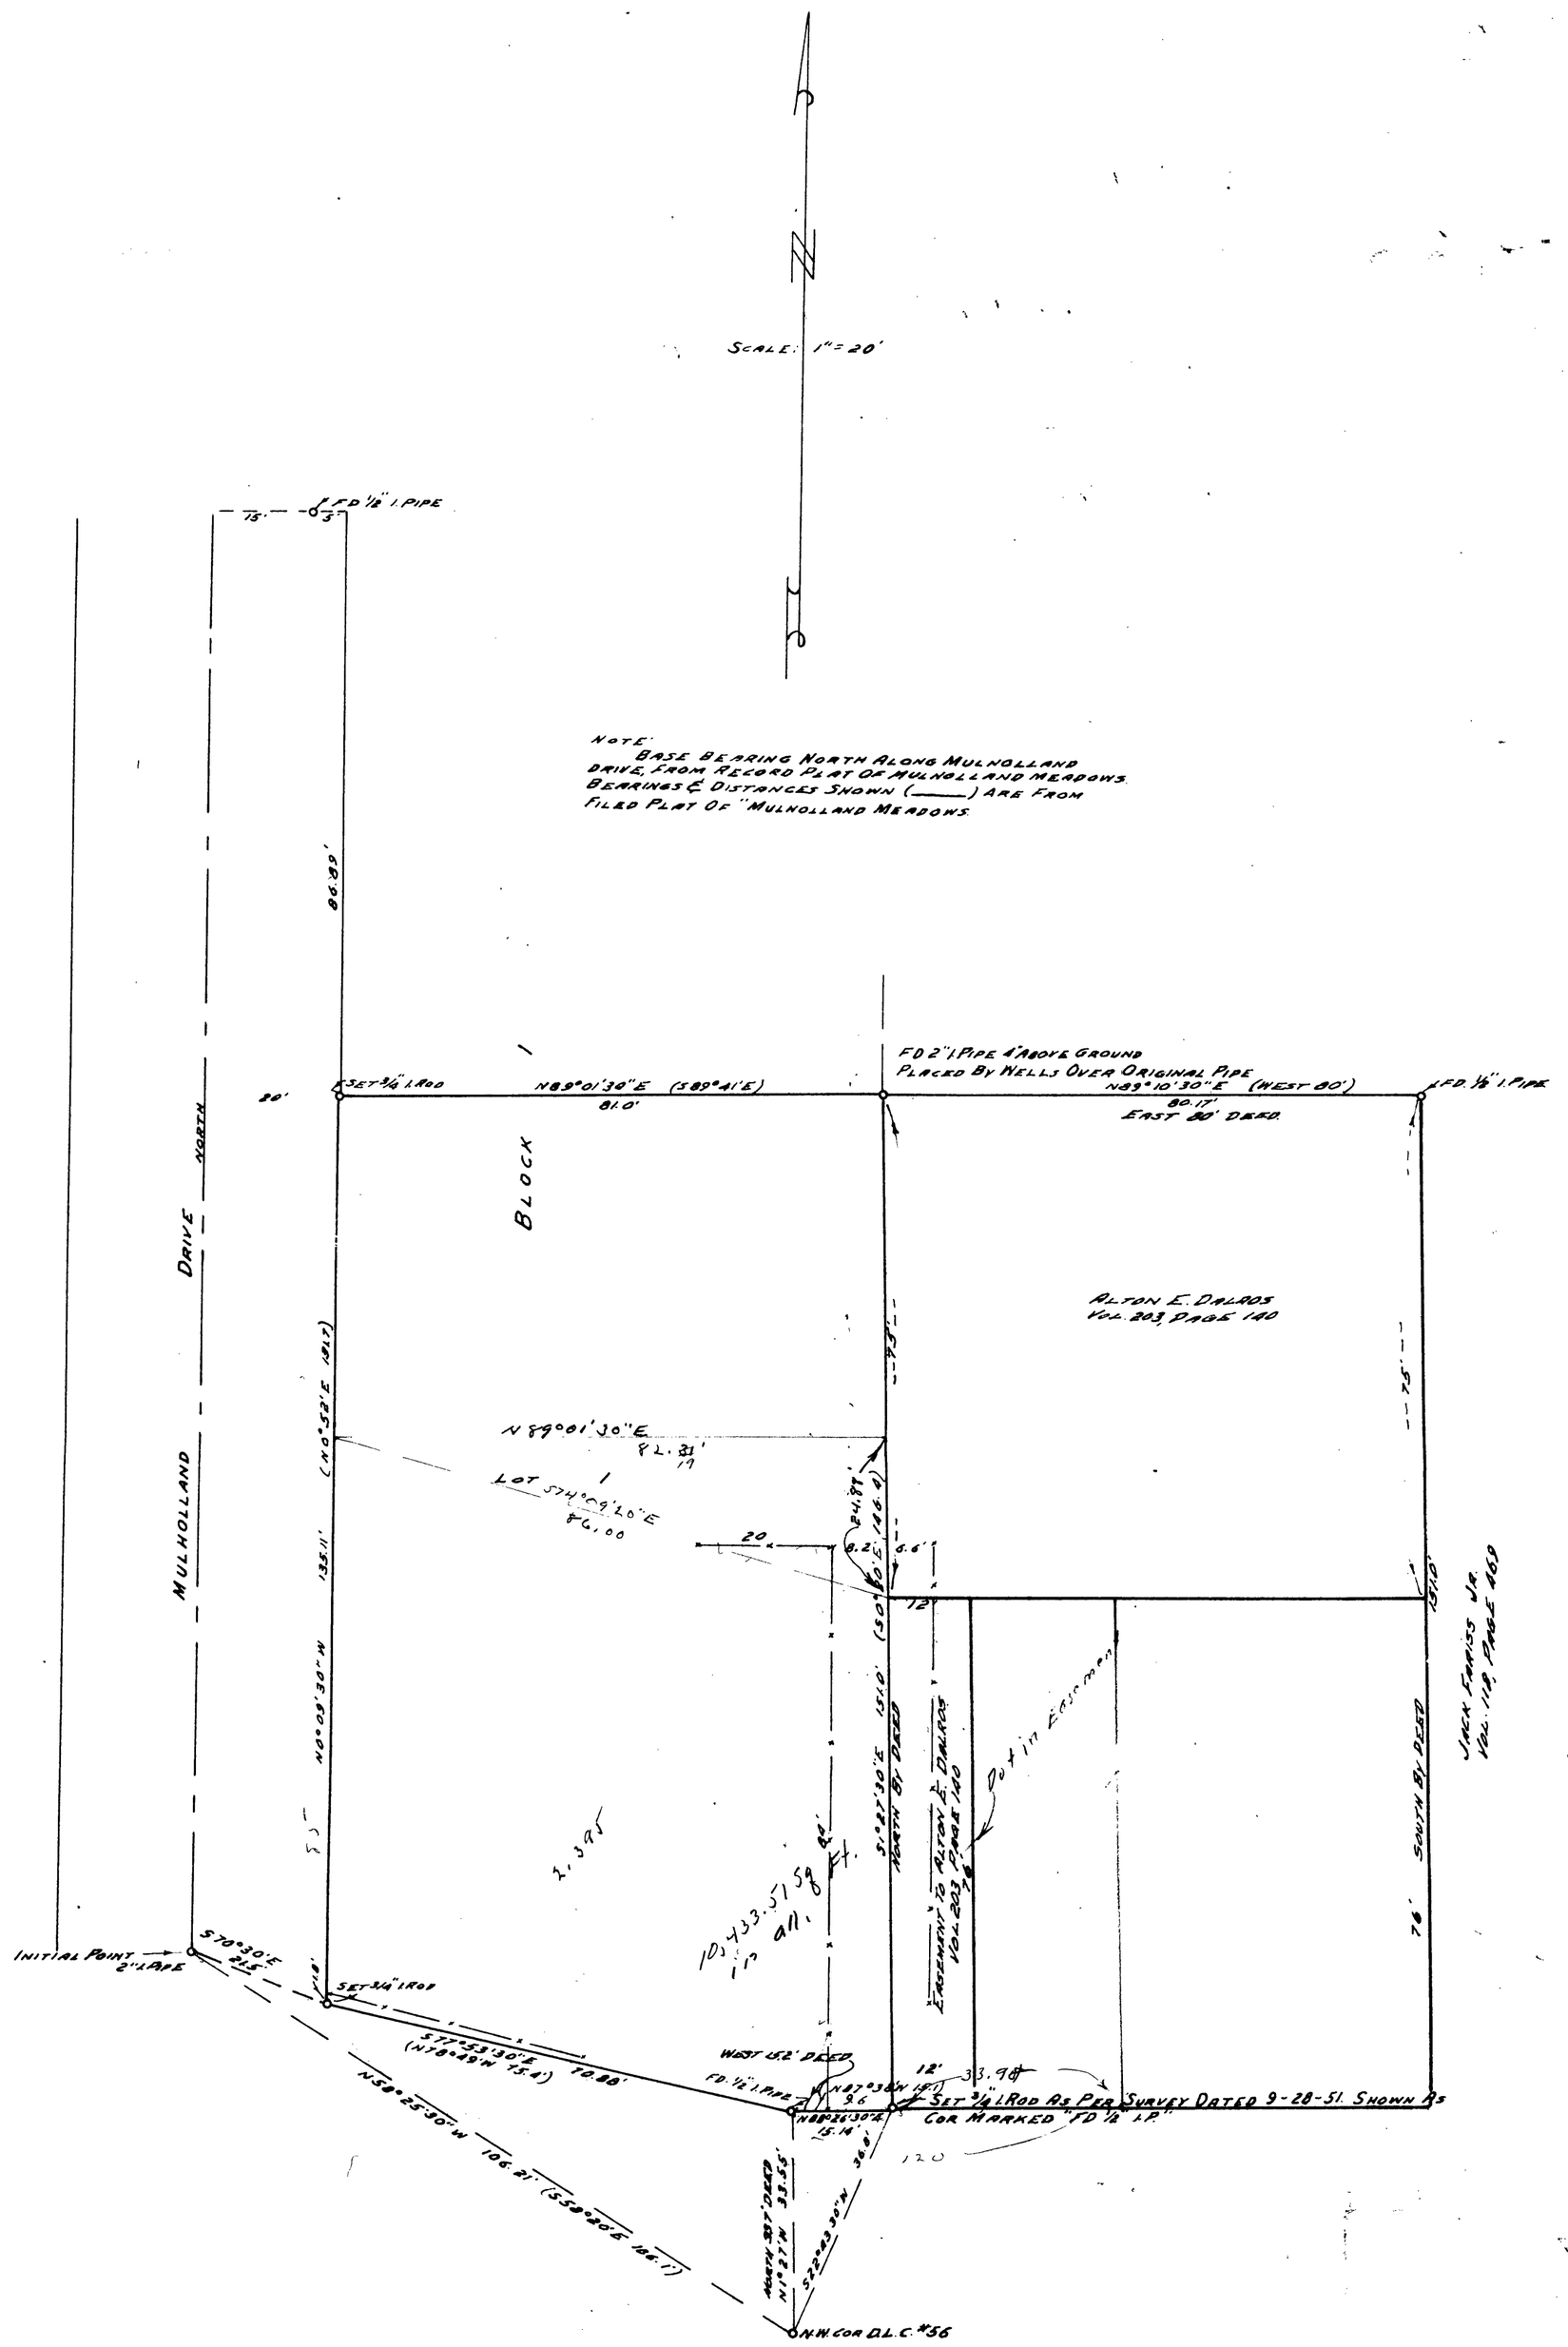

COUNTY SURVEYOR'S OFFICE
DOUGLAS COUNTY OREGON

PLAT OF SURVEY & DEEDS, SEC. 13 T. 27 S., R. 6 W
SEE SURVEYOR'S FILE 45-32 FOR SURVEY

BEN B. IRVING COUNTY SURVEYOR
DRAWN JUNE 23, 1955

C. S. File No. 46/145-1

2