1952
1954
1955

COUNTY SURVEYOR'S OFFICE
DOUGLAS COUNTY, OREGON.
SURVEYS IN
SECTION 21, T. 32 S. R. 5 W. W.M.
GEO. J. WENDEROTH, DEPUTY.

Geo. J. Wenderoth

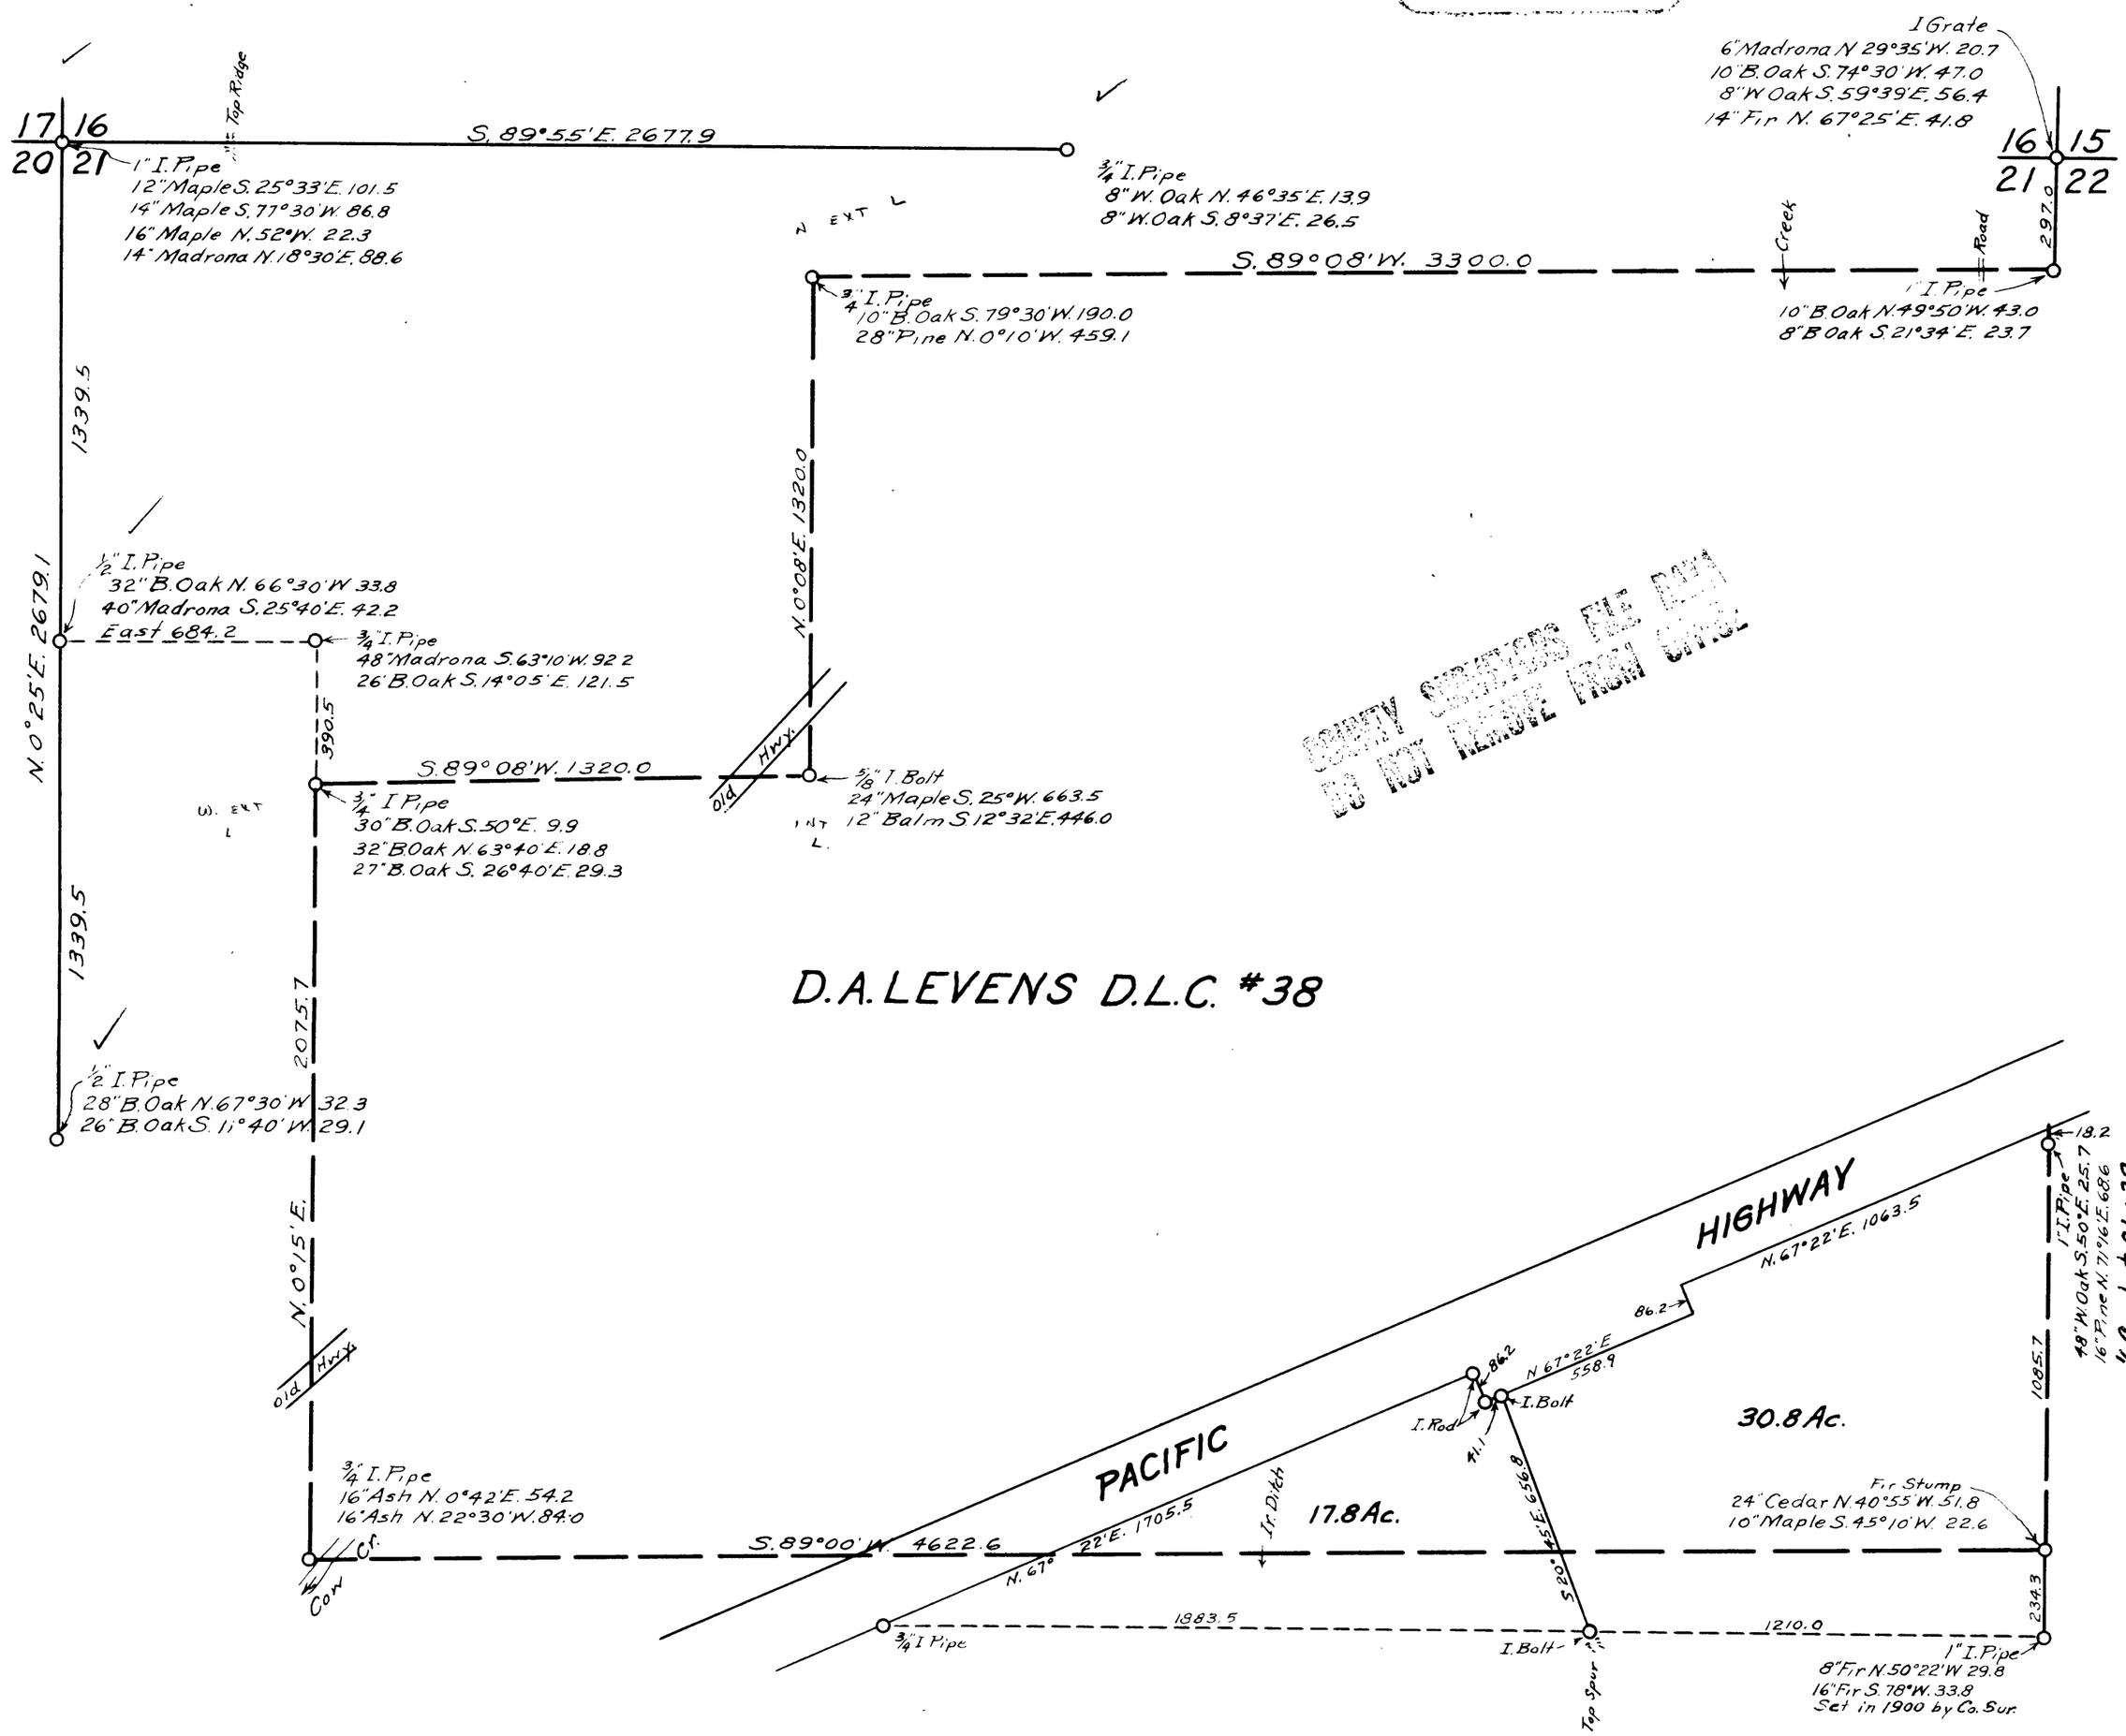

D.A. LEVENS D.L.C. #38

COUNTY SURVEYORS FILE DATA
DO NOT REMOVE FROM OFFICE

COUNTY SURVEYORS FILE DATA
DO NOT REMOVE FROM OFFICE

(See also C.S. File No. 45/83)

C.S. File No. 46/48