FILED
RECEIVED
AUG 25 1955
COUNTY SURVEYOR
DOUGLAS COUNTY, OREGON

COUNTY SURVEYORS FILE DATA
DO NOT REMOVE FROM OFFICE

COUNTY SURVEYOR'S OFFICE
DOUGLAS COUNTY, OREGON.

SURVEY FOR
C. R. BURCHFIELD
SECTION 32, T. 32 S., R. 6 W., W. M.
Geo. J. Wenderoth, Deputy. Aug. 12, 1955
Scale 1" = 100 ft.

REGISTERED
OREGON
LAND SURVEYOR
Geo. J. Wenderoth
MARCH 10, 1944
George J. Wenderoth
5

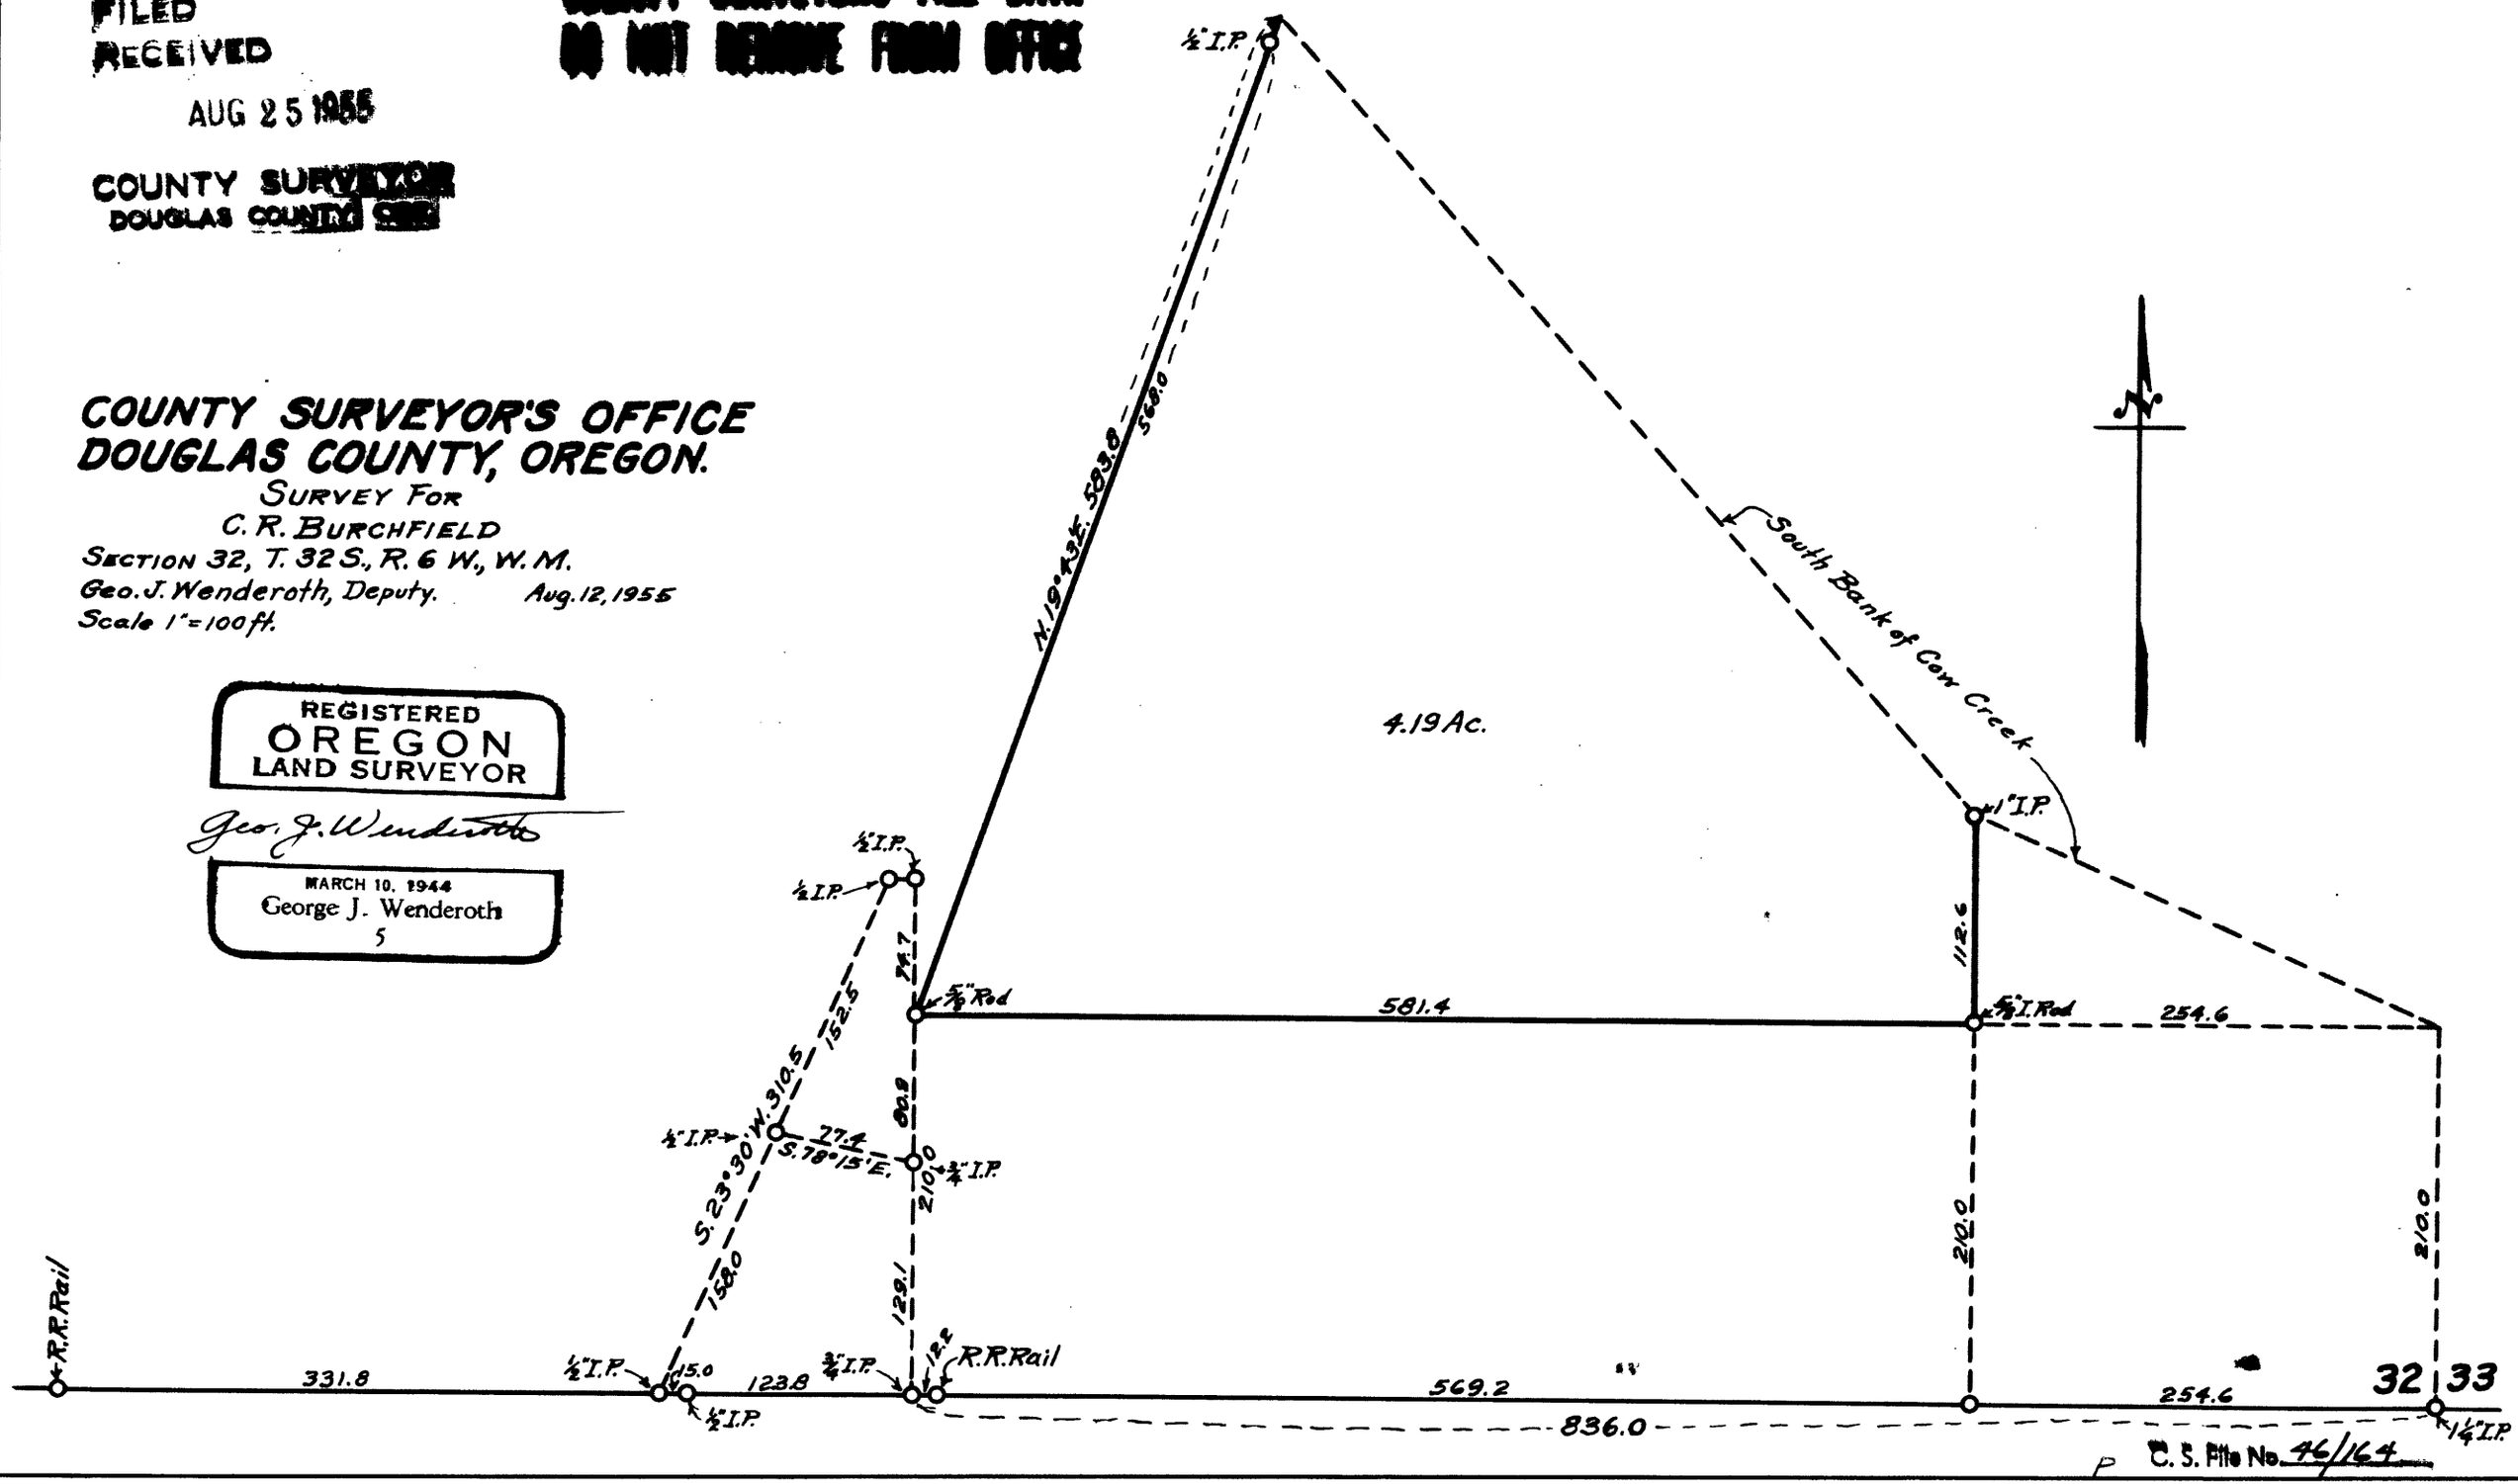

C. S. File No. 46/164