

LOT 12

LOT 13

LOT 14

LOT

15

NOTE: Base Bearing N67°09'E Along The North Line Of The County Road No. 15 Map Of GLENGARRY Fruit Lands.



10 ACRES

*20 3/4 Ac Parcel Added.*

SET 3/4 INCH IRON ROD


589.13' IN

SET 3/4 INCH IRON ROD

1.01 ACRES

351.5' PRORATED (56.98' PART)

SET 3/4 INCH IRON ROD

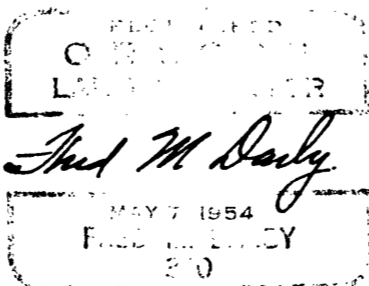

427.37' PRORATED N67°09'E COUNTY ROAD NO. 15

COUNTY SURVEYOR'S OFFICE  
DOUGLAS COUNTY, OREGON  
SURVEY FOR DEED DESCRIPTION  
PORTION OF LOTS 13 AND 14  
GLENGARRY TO FRUIT LANDS

BEN B. IRVING COUNTY SURVEYOR  
SURVEYED JULY 22, 1955 BY  
JAMES W. BYRON - DEPUTY SCALE 1" = 100'  
SURVEYED FOR C. B. MC. GHEHEY