PARCELS IN LOTS 5&6 · FISK FRUIT FARMS

DOUGLAS COUNTY · OREGON

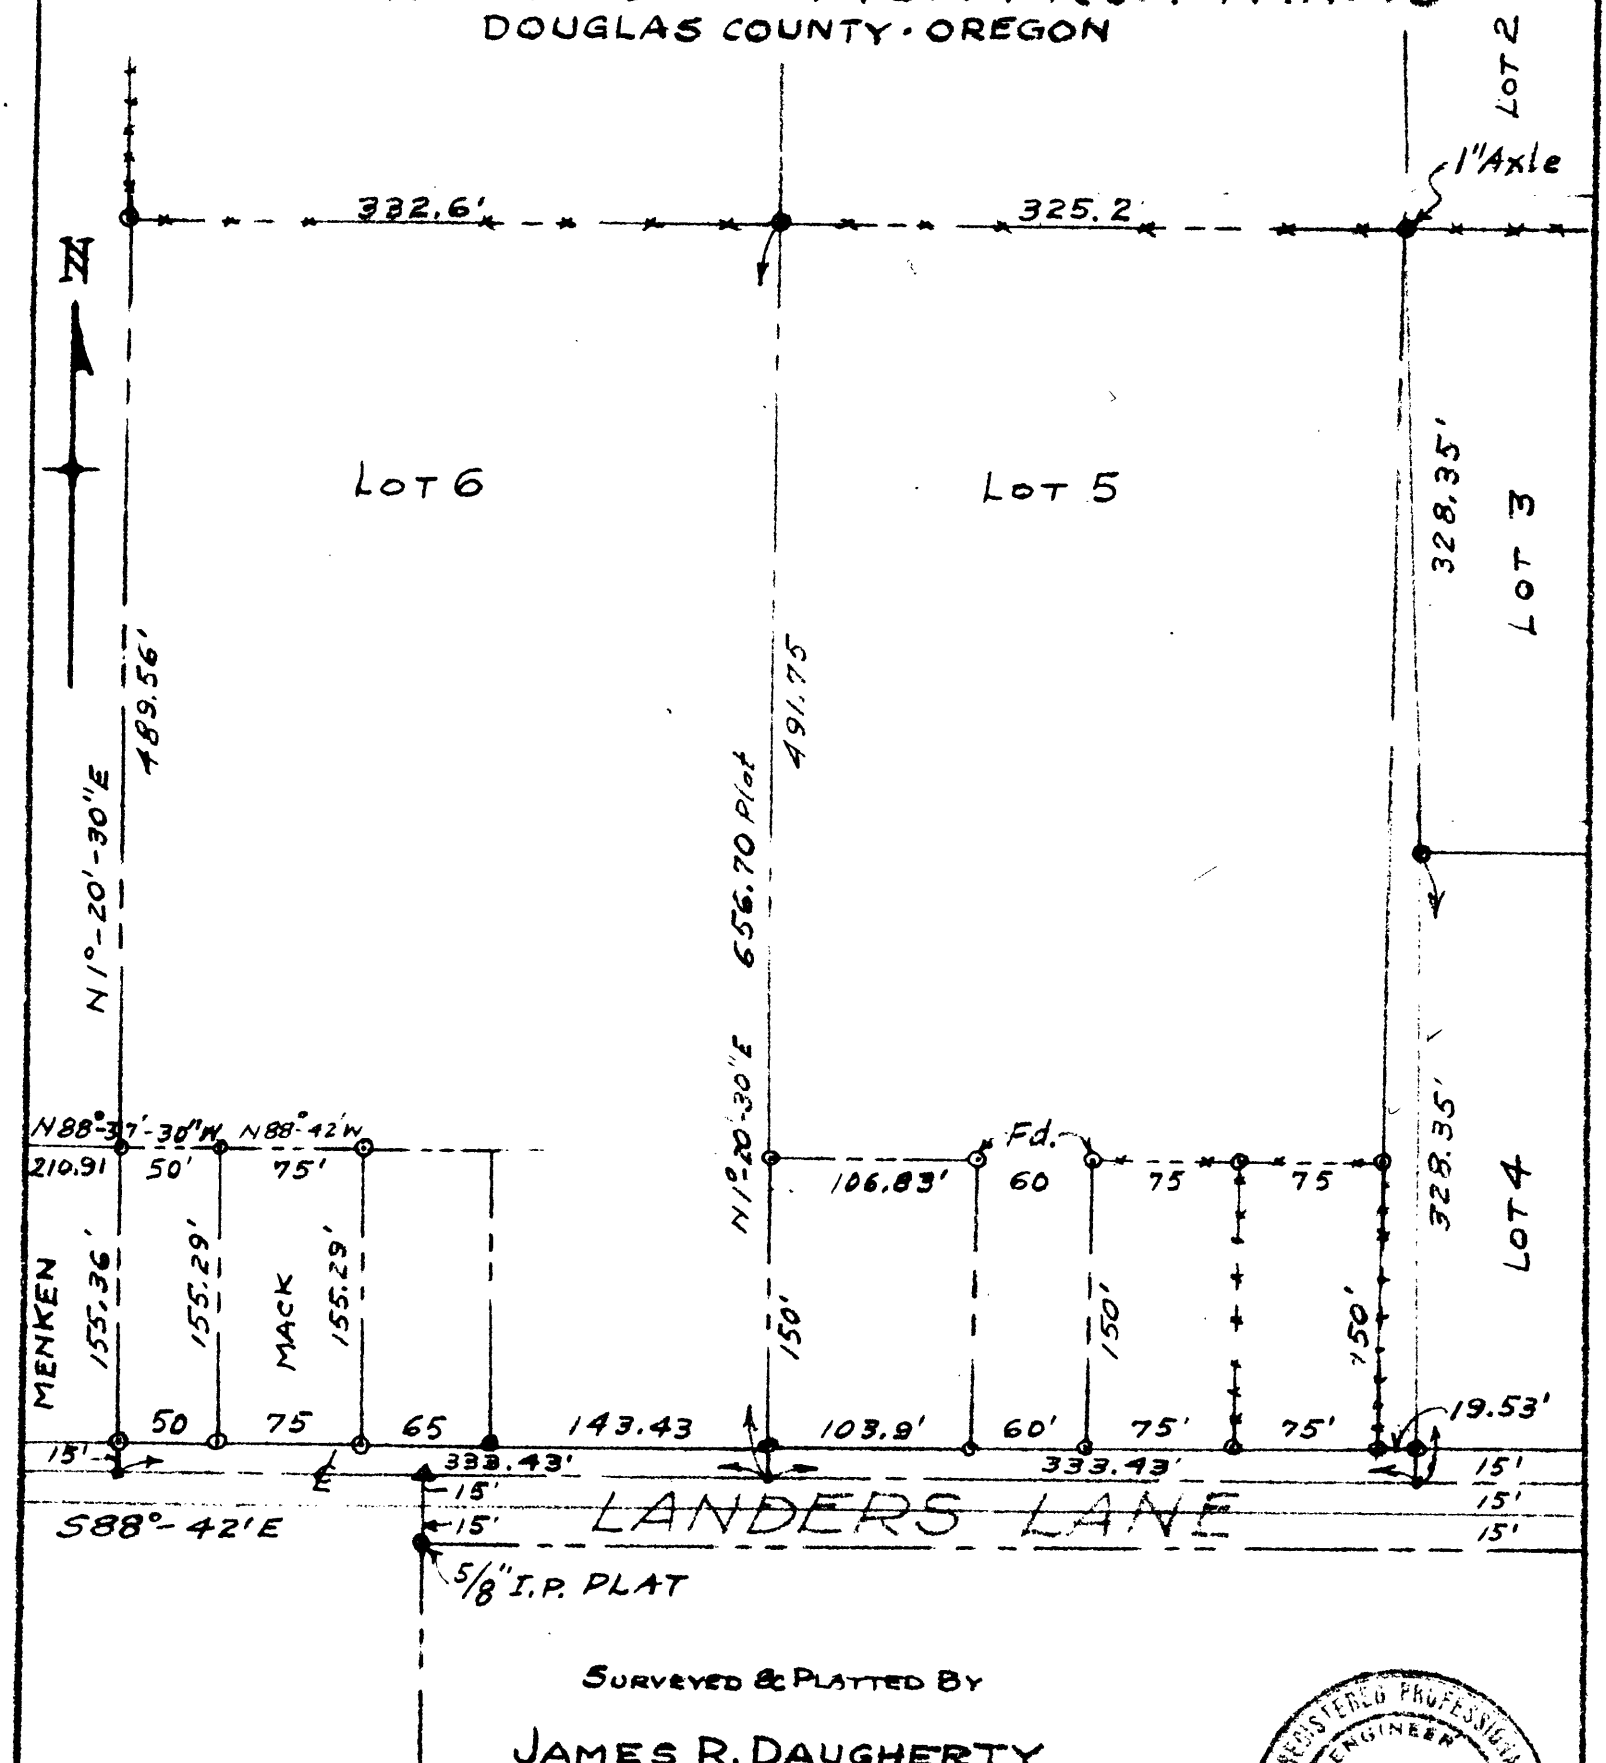

SURVEYED & PLATTED BY

JAMES R. DAUGHERTY

CIVIL-SANITARY ENGINEER

ROSEBURG · ORE.

SCALE 1" = 100'

MARCH 12, 1956

C. S. File No. P 47/103-2

REGISTERED PROFESSIONAL ENGINEER 3339 James R. Daugherty OREGON JAMES R. DAUGHERTY