

17/16
RENEW 2012, T23S R5W

FOUND - HAINESK IRON AT COR ORIG
 22" NOK 36" FIR STUMP SHOWS GOOD FERRING
 1" 2 3" N50°E 383' ORIG. 20" NOK
 40" FIR SNAG 382.5°E 13.2' SHOWS GOOD
 SCRIBBLE "T23S R5W 5218 T"
 ORIG. 30" NOK DOTTED FIR STUMP N40°W
 119'. ORIG 18" NOK 40" FIR SHOWS OLD
 SCARS I DO NOT OPEN 555°W 22'


NEW BITS
 2" R. FIR BEARS N61.5°E 37.9'
 SCRIBED 516 CSBT

8" R. FIR BEARS N84.6°W 89.6'
 SCRIBED 517 T23S R5W CSBT

8" W. OAK BEARS 512°E 223'
 SCRIBED 521 T23S R5W CSBT

OCT 30-59

DIETZGEN NO. 389-6

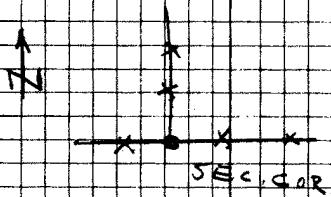

C.S. File No. 49/42-37