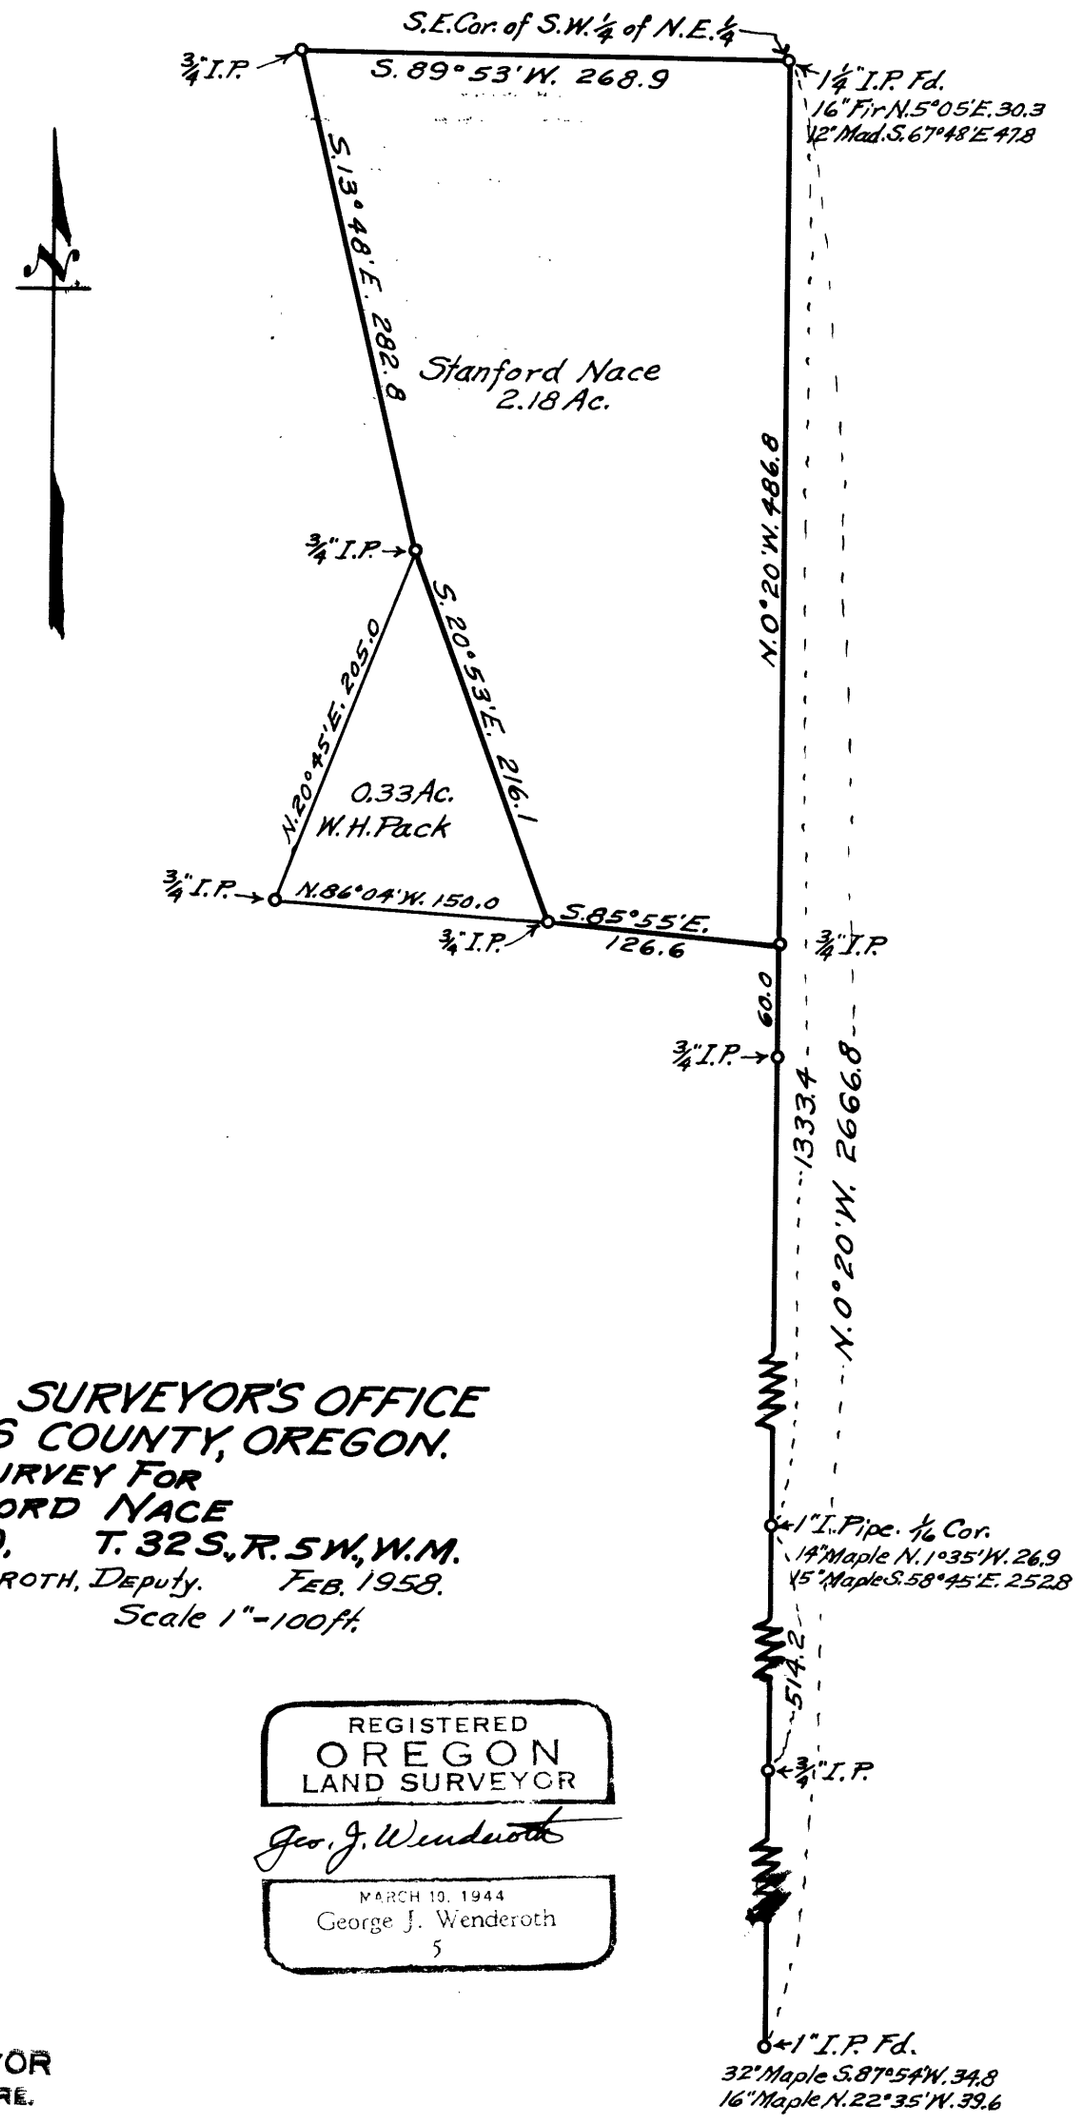

COUNTY SURVEYOR'S OFFICE
DOUGLAS COUNTY, OREGON.
SURVEY FOR
STANFORD NACE
SECTION 20, T. 32 S., R. 5 W., W.M.
GEO. J. WENDEROTH, Deputy. FEB. 1958.
Scale 1" = 100 ft.

REGISTERED
OREGON
LAND SURVEYOR
Geo. J. Wenderoth
MARCH 10, 1944
George J. Wenderoth
5

FILED
RECEIVED
FEB 24 1958
COUNTY SURVEYOR
DOUGLAS COUNTY, ORE.

C. S. File No. 49/65