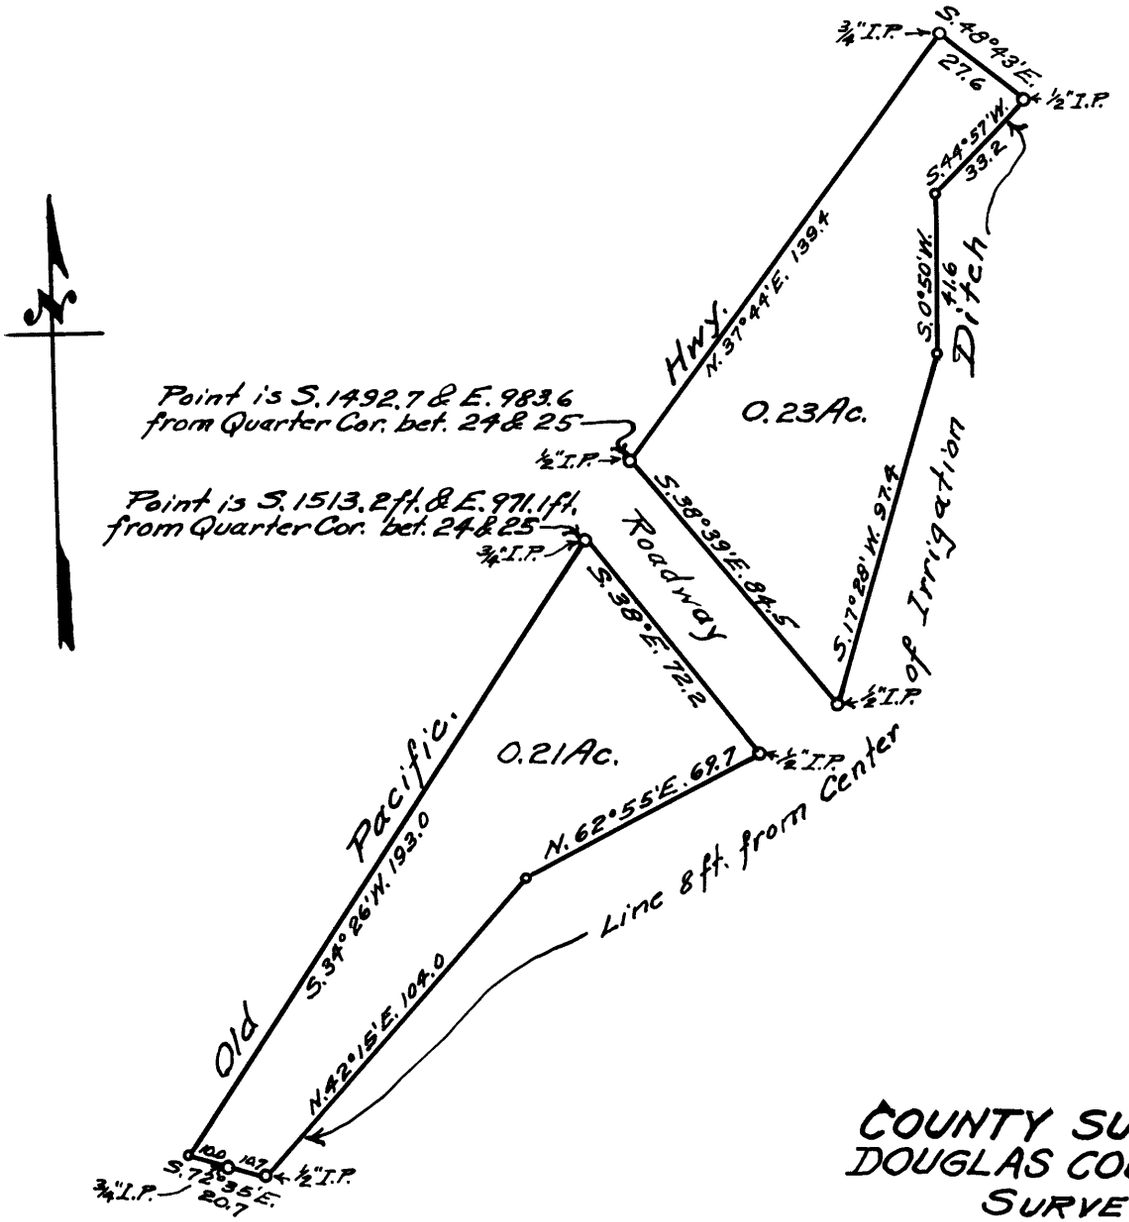

FILED
RECEIVED
SEP 2 1958
COUNTY SURVEYOR
DOUGLAS COUNTY, ORE.

REGISTERED
OREGON
LAND SURVEYOR

Geo. J. Wenderoth

MARCH 12 1944
George J. Wenderoth
5

COUNTY SURVEYOR'S OFFICE
DOUGLAS COUNTY, OREGON.
SURVEY FOR
W.F. MARTIN
SECTION 25, T.32S., R.6W., W.M.
GEO. J. WENDEROTH, DEPUTY.
SCALE 1"=50' SEPT. 1958

C. S. File No. 49/114