

RENEW

19
23

T 275 R 4

177° 44'

FOUND - STAKE AT COR. AS RECORDED
NEW BITS. NOW STUMPS SHOW GOOD
I DO NOT OPEN.

NEW BITS

20 CEDAR BEARS N 30° W 432'
SCRIBED S 14 T 275 RAW CS BT

30" R. FIR BEARS S 86° W 270'
SCRIBED S 23 T 275 RAW CS BT

✓

RENEW

23
13
24

T 275 RAW

FOUND - BRASS CAP AT COR. & 30"
R. FIR STAKE SHOWS SPAD. I DO NOT
OPEN. S 83° E 22.4'

NEW BT

36 CEDAR BEARS N 89° E 292'
SCRIBED S 13 T 275 RAW CS BT

RETRACE SEC. LINE WEST
FROM 19
23 T 275 RAW


✓

DIETZGEN AND: 5898

C S File No.

49/12/4

			579°14'30" W	S 79° W	
6		26°17' 30'08" L			-20°30' 1920
	343.79		N 87°37' W		-22°30' 17665
5		1°40' 0°50" R			
	299.27		N 88°27' W		-9.95 -15°20' 3000
4		51°51' 25'55" R			
	100.87		565°37'30" W	565° W	-9°35' 1023
3		104°34" 52°17" L			
	136.27		N 62°05'30" W		+6°40' 1372
2		49°21' 24°40" R			
	390.98		N 86°46' W		+18°40' 426' +20'25" 3010
1		4°13" 2°07" R			
	68.96		N 89°53' W	N 89° W	+12°10' 700
13/14		177°45' 88°53" L			+29°35' 793
	978			NORTH	
13/14					

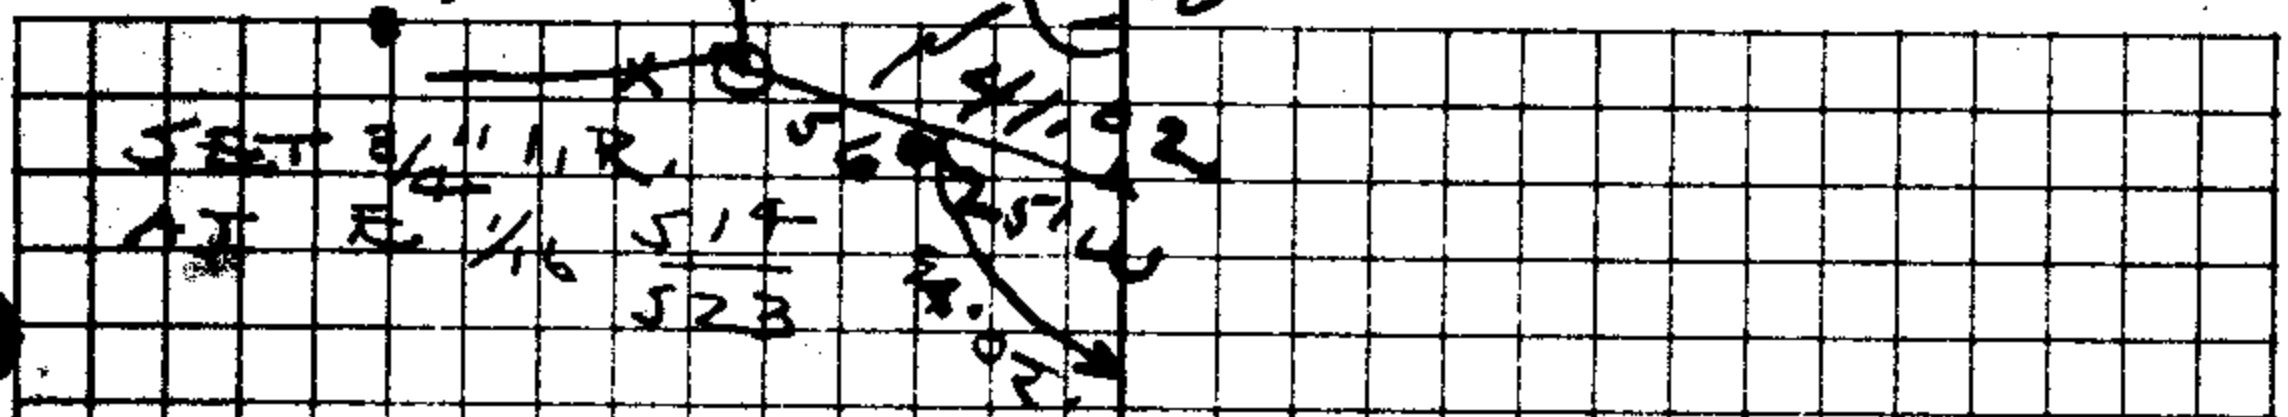

FD- 17" FIR N29" GOOD DARK SCRIBING
 1CS 3 1/2" N20°E 119' 36" CEDAR
 STUMP WEST 40.3 JMOY'S SCAR

NEW BT.
 30" R. FIR BEARS N 68° W 310'
 SCRIBED 1/16 S 14 CS BT.

DIETZMAN NO. 3886

			N 88° 29' 30" W	L 26.2'
				- 25° 15'
			N 89° W	300'
11		10° 06' 6° 33' R		
	168.46		N 89° 02' 30" W	- 15° 00'
				179'
			N 89° W	
10		17° 03' 8° 31½' R		
	245.68		S 82° 26' W S 83° W	
				- 10° 40'
				250'
9		17° 13' 8° 37' L		
				- 5° 10'
				96'
				16° 50'
	956.73		N 88° 57' W	95'
				- 10° 50'
				2933'
				- 24° 35'
				1840'
				- 33° 30'
				289'
				- 28° 40'
8		3° 56' 10° 58' L		840'
	106.72		N 86° 59' W N 87° W	
				- 21° 45'
				1149'
7		27° 32' 13° 46½' R		
	203.81		S 79° 14' 30" W	- 17° 30'
				2137'


APRIL 20-59

RENEW 1/4 COR

14 T 278 R4W

3

NO DRUG BTL FOUND
 WITH A S H L M H D
 WITH BRASS CAP & H CORNER MAD
 COUNTY SURVEYOR'S OFFICE 1959
 1/4 COR 1/2 S R 4 W S
 1/2 S R 4 W S
 A: R. F. R. BEARDS N 1/2 E 40 6'
 DESCRIBED NE 1/4 COR 1/2 S R 4 W

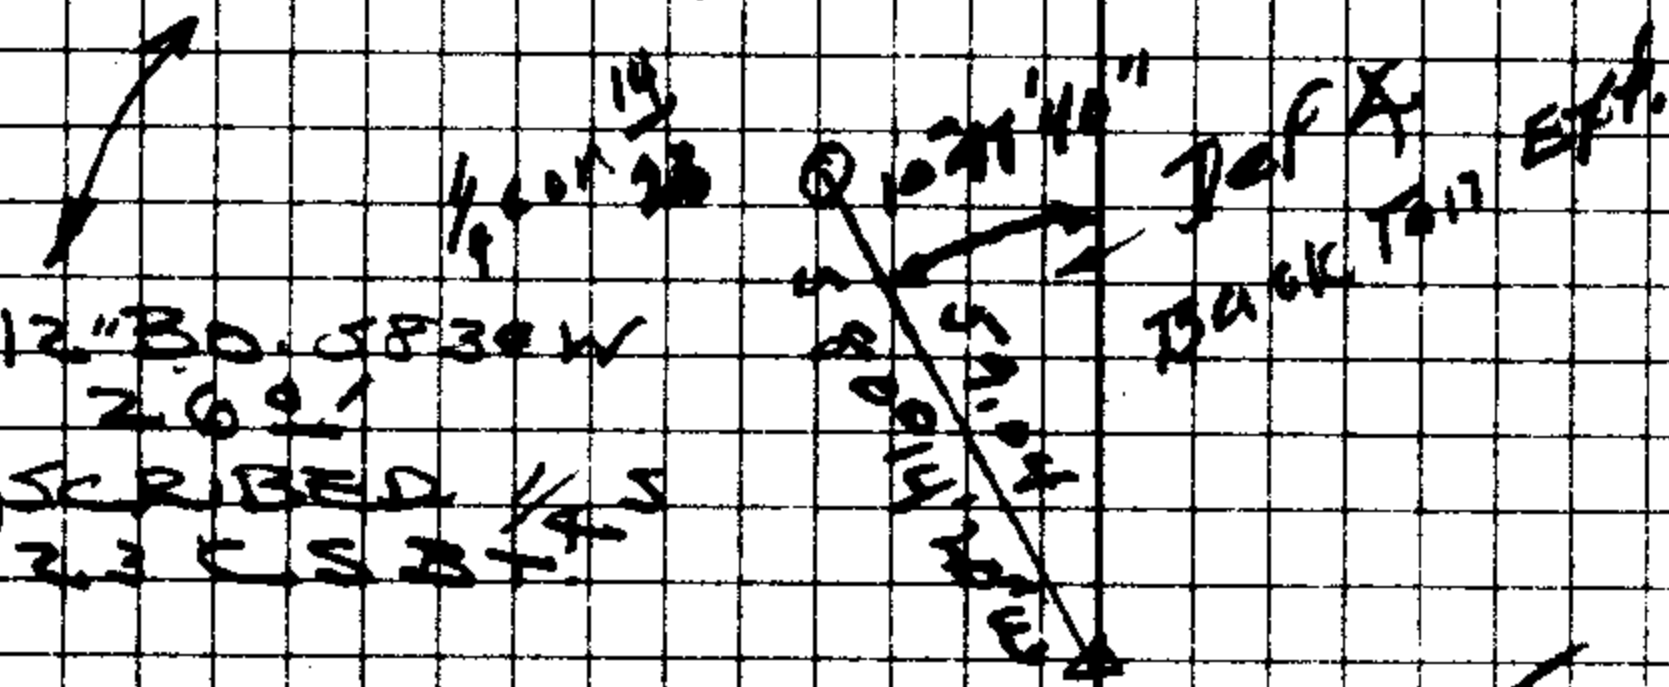

DIETZGEN, NO. 305-6

*

N 89° 57' W

C.S. File No. 79/146

			574° 36' W	
				574° W -17° 10' 265°
17		24° 15' 12° 07' L		
	104.04		586° 43' 30" W 586° W	
				-14° 10' 137°
16		30° 46' 1° 53' L		
				-5° 35' 292°
	885.25		598° 36' 30" W	-7° 45' 300°
				-8° 50' 300°
15		37° 11' 18° 36' R		
	170.97		570° 00' 30" W 570° W	+30° 00' 171°
14		2° 30' 10° 15' L		
	165.36		571° 15' 30" W 571° W	
				+9° 10' 167°
13		68° 12' 34° 06' L		
				+16° 10' 56°
	640.50		N74° 39' 30" W	+16° 10' 300°
				-7° 05' 300°
				N75° W
12		27° 41' 13° 51' R		
	297.54		N88° 29' 30" W	

FD 1, P.

1/4 Cor

15 7275 R4U

22 369.18

N8°54'E

+15.00

196.2

+14.20

187.6

20

33°56'
16°58' R

N9° E

215.51

N8°04' W

+6.30

216.9

19

7'33'

3'46 1/2

N8° W

232.69

N4°17'30" W

+4.30

233.9

18

202°13'

1.01°06' 1/2 R

N5° W

2.10'

136.2

2°35'

300.0

1°20'

300.0

600.0

2795.64

S74°36' W

2.00'

600.0

-9°20'

300.0

L 51.4

41.45

267.7

559

JAN 7 - 58

J. BYRON

M. GODFREY

J. BILLOW

VAR. 20 1/2

DIETZGEN NO. 385r6

C. S. File No. 49/146

RENEW ^{15/4} 22/23 T27S R4W

NO ORIG. BTS FOUND SEE CS
FILE

SET BRASS CAP AT CORNER MKD
S15/514 T27S R4W COUNTY
522/523 SURVEYORS OFFICE 1959

NEW BTS.


32" CEDAR BEARS N 9° E 76.5'
SCRIBED S14 T27S R4W CSBT

40" CEDAR BEARS N 43° E 52.7'
SCRIBED S14 T27S R4W CSBT

34" B. OAK BEARS S 89° E 135.4'
SCRIBED S23 T27S R4W CSBT

NO OTHER TREES NEAR

17

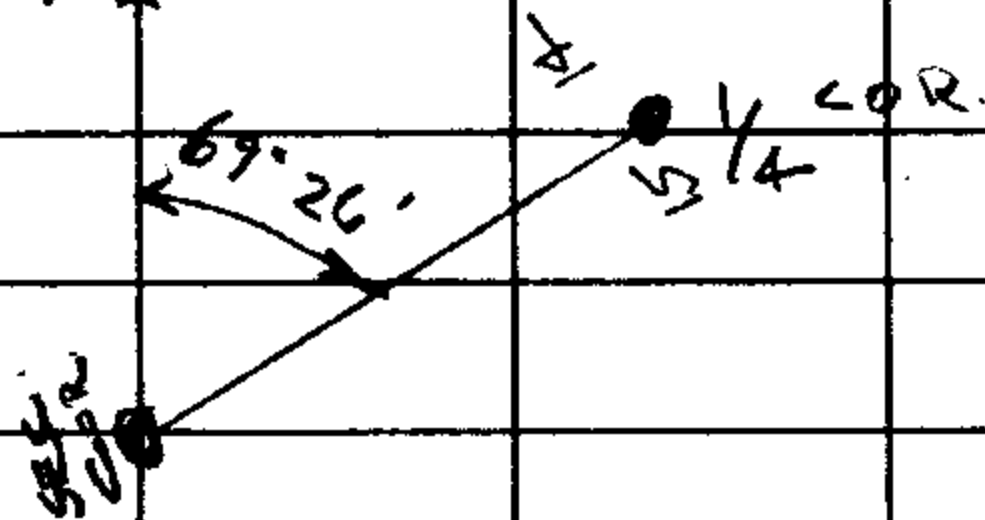

- 9° 20'
300 p
1511
- 1045
2672

ROCK - E. COR 14 + 23 + 275

793 +

959

1 700 +

67.149

3010 +

6535

426 +

1.50

2 137 +

9537

3 102 -

142

19079

300 -
995 LEV.

38198

9537

5 1765 -

11542

1928 -

6 - 452 - TO E 1/4 COR. SECS. 14
2132 -

7 1142 -

958

8 840 -

5

289 -

4590

1840 -

479

2932 -

5219

950 +

964 -

9 2502 -

10 1744 -

11 3000 -
262 LEV.

12

C. S. File No. 49/146

12 - ON W. SHOULDER OF ROAD

300° -
300° +
56° +

13 - 134² + TO 3/4" ROD W/16 SECS 14
23

167⁵ +

14
171² -

15
300° -
300° -
292³ - 5° 35'

16
107³ -

17
260° -
267⁷
51^L
300° -
300° - 2° 00'
300° - 1° 20'
300° LEV.
300° - 2° 35'
300° - 2° 00'
300° LEV
136² +

18
233⁴ +

19
216⁹ +

20
196° +
184° + 14° 20'
COR SECS 10
22

273 R4W

S 83° 0' W

S 31° 0' E

56 L

58 L

37 FT

38 FT

1/4 22/23

14 LAUREL

36 FIR

S 81° W

S 33° E

N 88° E

N 26° W

247 L

298 L

197 L

270 L

1032

1962

1302

1782

1514

3223

C.S. File No. 49/146

107

100
105
110
115
120

100-105



DIETZGEN NO. 385-6

The page contains a large grid of graph paper, approximately 20 columns wide and 40 rows high. A vertical line runs down the center of the grid, dividing it into two equal halves. The grid is currently blank, with no data or markings.

C.S. No. 49/146

54

2'23'
10 11 1/2 R

235.12

N0°54'E

-13°00'
NORTH 2413'

53

2'13'
10 07 R

849.37

N0°13'W

~~150~~
-16°20'
64-3
-16°30'
2912
244.0
1570
-16°15'
2500

N1°W

-16°15'
980

52

2'52'
10 26 L

L149°

N1°13'E

51

POT

L157

316.7

N1°13'E

L3010

N7°E

50

5'56'
2'58' R

330.22

N1°45'W

-372
+6°35'
3000

N2°W

2223
2627

TRAVERSE WEST BUY SEC. 23

47437

48902

46005

46005

DIETZGEN NO. 385-6

C. S. File No. 49/146

				N 13 1/2 W	10° 30'	300.0'
58		79° 03'	57° 02'			
					-9° 50'	182.35'
	457.36			N 23° 42' 30" E		
					-22° 42'	301.9'
				N 23 1/2 E		
57		108° 06'	54° 03' 12"			
					-17° 15'	215.6'
	243.22			N 30° 20' 30" W N 31° W		
					-18° 45'	4.19'
56		64° 52'	32° 26'			
	83.61			N 2° 05' 30" E		
					-14° 05'	86.2'
55		POT				
					-6° 20'	271.75'
	670.14			N 2° 05' 30" E		
					-18° 40'	263.0'
					-18° 05'	158.0'

RENEW 1/4 COR. 22/23 T27S R4W

NO TRACE OF ORIG. B.T.S. HD.

JEE CS FILE #

WEST BRASS CAPAT CORNER MKO
COUNTY SURVEYORS OFFICE 1959


1/4 S 22/23 T27S R4W

NEW B.T.S.

5" R. FIR BEARS S73°E 52.1'
SCRIBED 1/4 S 22/23 CS BT

12" R. FIR BEARS N 56° W 24.0'
SCRIBED 1/4 S 22/23 CS BT.

DIETZGEN NO. 386-6

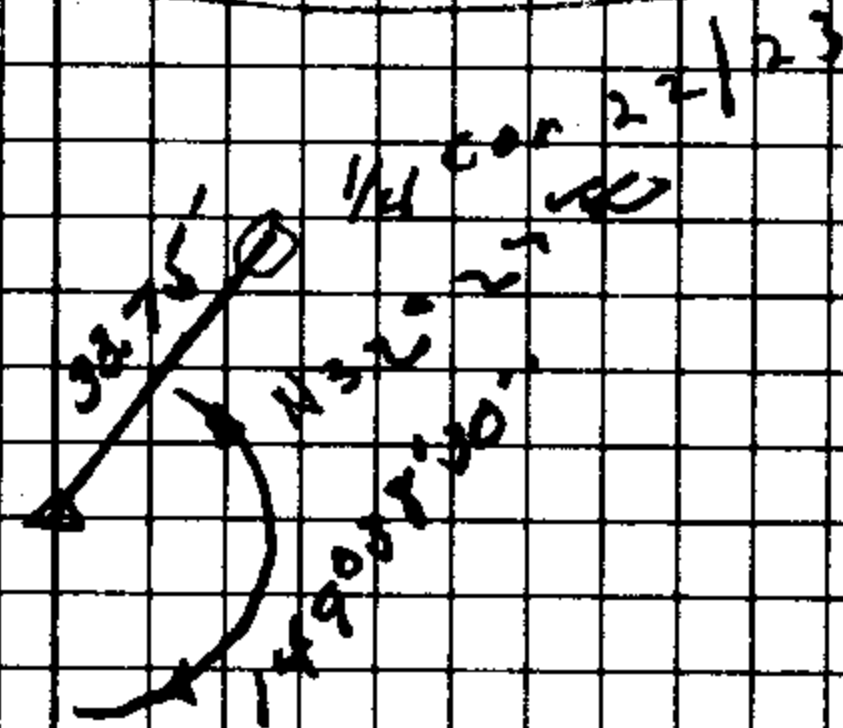

15061

C. S. File No. 99/146

17

586°43'30" W 55°50'00"

16

135°18'
67°35'

630.36

N25°37'30"W

+7°50'
118.7

N26°W

-4°48'
215.0
6°10'
300.0

60

101°10'
50°35' L

+2 1/2°
44.3

1241.66

N24°57'30"E

+13°45'
300.0

+6°20'
297.8

L1640

9°10'
297.1

N25°E

-11°50'
154.0

59

71°33 1/2'
38°17' R

364.35

N13°19'30"W

8°05'
70.0

MARCH 31-59

J. B.
M. G.
S. B.

DIETZGEN NO. 385-6

C. S. File No.

49/146

ROCK - COR. SECS

22/23
27/26

T27S
R4W

300° + 4° 35'

372 LEV.

50

301° - EV

157 LEV.

51

149° - LEV

52

298° - 16° 15'

250° - 16° 15'

157° + 2° 40'

297° - 8° 30'

64° - 6° 20'

53

241° - 13° 00'

54

158° - 18° 05'

263° - 18° 10'

271° 75' - 6° 20'

55

86° -

56

419° -

215° -

57

301° -

182° 35' -

58

300° -

70° -

59

C. S. File No.

89/196

9 157° -

297° -

164° -

277° -

300° -

44° -

215° -

300° - 6'10"

118° - 47'00"

16

N58°W
25'

CS FILE FOLDER

CONTAINS

MORE

INFORMATION