

DIETZEN NO. 388-6

INDEX

T 258 T 265 RAW

SEE 3A, SEE 3

C. S. File No. 49/155

RENEW $\frac{1}{4}$ CAP $\frac{39}{3}$ T 25 S RAW
T 25 S

FOUND -

ORIG. NOW 48" CEDAR
SHOWS GOOD BARK SCRIBING " $\frac{1}{4}$ S BT"
8' W 2.0 P'

ORIG. NOW 36" R. FIR
N 33° W 25' SHOWS GOOD BARK
SCRIBING " $\frac{1}{4}$ S "

SET BRASS CAP AT CORNER
MND. COUNTY SURVEYORS OFFICE
1959. $\frac{1}{4}$ S $\frac{39}{3}$ T 25 S RAW
53 T 26 S

DIETZGEN NO. 388-6

NEW BITS.
18" LAUREL BEARS N 57° E 3.5'
SCRIBED $\frac{1}{4}$ S 39 CS BT

8' W. FIR BEARS S 78° W 2.9'
SCRIBED $\frac{1}{4}$ S 3 CS BT

✓✓✓

C. S. File No. 49/155

			53°57'W		
✓	229.5			S 2°W	+22°10' 2478
6		3°42' 1°51' R			+6°00' 1684
				SOUTH	9°35' 3019
✓	4643		52°06'W		
5		POT			
✓	78.9		52°06'W		3°40' 79
4		0°20' 6°10' L			
			52°16'W		+11°15' 1048
✓	102.8			S 2°W	
3		7°52' 3°58' R			
✓	285.2		51°40'E		+14°20' 2949
2		POT			
✓	167.6		51°40'E		+18°45' 1770
		7°21' 3°40' L		S 2°E	
1					+11°15' 675
✓	363.3		S 2°W	S 2°W	78°00' 30010
A					
	2.3		573.25 E		
1/4 COR.					
	39 T 25 S				
	3 T 26 S	R 4 W			

92607 ✓

99952 ✓

98609 ✓

99795 ✓

98079 ✓

98887 ✓


94693 ✓

98079 ✓

99027 ✓

H. 1919
A. 1920
A. 1921
TIP RIDGE

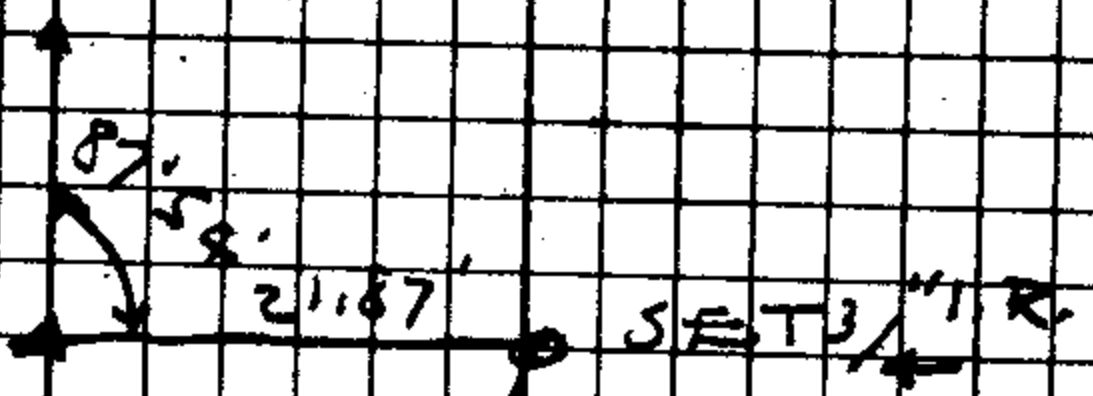

SET 3/4" R

MID SEC 1/2" R

MAY 21-54

SCRIBED
1/2" R. TIP
C. S. B. T.

DIETZGEN NO. 388-6

5 1/4 COR 53

181.7

514°09'E

515°E

-8°30'

1837

10

35°45'

17°53' L

-2°30'

248

-5°35'

946.5

53°44' W

300

-12°30'

54° W

300

-9°40'

1086

9

3°52'

1°56' R

+3°30'

152

+14°52'

1096

+11°50'

301

-2°30'

1835

2207.4

2207.9

51°48' W

4°30'

203

-6°50'

2665

-9°25'

300

-8°35'

2986

-15°40'

300

8

0°34'

0°17' L

L 219

313.7

52°05' W

-9°40'

127

✓ L 291.8

51° W

+13°25'

300

7

3°45'

1°52' L

RENEW 1/4 COR 3 T 265 R4W
10

FOUND - ORIG 14" NOW 34" B.O.
IF STATE 990' I OPEN & FIND
GOOD VERBINE 1/4 S" I FIND NO TRACE
OF ORIG. 1/4 S" B.T.

SET BRASS CAP AT CORNER AND
COUNTY SURVEYORS OFFICE 1759

1/4 3/4 T 265 R 4W
5/10

NEW B.T.S.
15" B. OAK BEARS S 7° W 699'
SCRIBED 1/4 S 10 COR BT

98813 ✓ 14" B. OAK BEARS N 23° E 572'
SCRIBED 1/4 S 10 COR BT

98930 96653

98763 ✓

99905 ✓

~~99813~~ 99692

99280 ✓

98652 ✓

98880 ✓

98285 ✓

98580 ✓

~~TOP R. O. G. E.~~

97271 ✓

DIETZGEN NO. 3886

AC 9 F.S. 8 L TO RT

	H.A.	V.A.	TIME
9	82°25'	37°05'	P.M 3:38:42
10	82°52	39°25	3:40:03

4	81°59	38°40	3:40:58
10	82°33	39°10'	3:41:36

+	81°41	38°25'	3:42:24
+	82°14'	38°52'	3:43:10

6'
Not used

+	82 22	38°08'	3:44:56
+	81°51	38°35'	3:44:43

+	81°05'	37°53'	3:45:26
+	81°40'	38°22'	3:46:01

127

140

307

DIETZGEN NO. 308-6

C. S. File No. 49/155

AT 9 F S L TO ~~HT~~

HA VA

TIME

MAS COURSE N 1°30'E

PM

4
5
6
7
8
9
10
11
12
1
2
3
4
5
6
7
8
9
10
11
12

+

101°33'	37°23'	3:47:17
---------	--------	---------

to

102°5'	37°47'	3:48:1
--------	--------	--------

+

101°15'	37°06'	3:49:45
---------	--------	---------

to

101°48'	37°35'	3:50:26
---------	--------	---------

+

101°00'	36°55'	3:50:3
---------	--------	--------

to

101°33'		3:50:42
---------	--	---------

+

101°44'	36°37'	3:51:36
---------	--------	---------

to

101°18'	37°05'	3:52:1
---------	--------	--------

+

100°44'	36°20'	3:53:1
---------	--------	--------

to

100°59'	36°45'	3:53:13
---------	--------	---------

+

100°9'	36°05'	3:54:23
--------	--------	---------

to

100°40'	36°30'	3:55:11
---------	--------	---------

MAY 11 - 1959

J. B.

B. B.

DIETZGEN NO. 305-6

C. S. File No. 79/155

	212.50		N 21° 01' E	N 24° E	+15° 00' 220°
57		71° 06' 35° 33' R			+7° 30'
	87.25		N 14° 32' W	N 14° W	88°
56		22° 16' $\frac{1}{2}$ 1° 08'			
	215.15		N 3° 24' W		L 61.9' -26° 20' 171°
55		19° 46' 9° 52' $\frac{1}{2}$ R			
	174.04		N 13° 16' 30" W		-26° 45'
		46° 57'		N 10° W	194°
54		23° 28' $\frac{1}{2}$ R			
			N 36° 45' W		
	656			N 35° W	
53		74° 15' 37° 07' $\frac{1}{2}$ L			
	152.54		N 0° 22' 30" E		-12° 00' 46°
				N 1° E	-17° 45' 112°
52		3° 33' 1° 46' R			
	142.02		N 1° 23' 30" W	N 1° W	-19° 00' 150°
51		2° 15' 1° 07' L			
	114.16		N 0° 16' 30" W	N 1° W	-11° 30' 116°
50		4° 33' 2° 16' $\frac{1}{2}$ L			
	32.6		N 2° E	N 2° E	
Δ		P.O.T.			
			N 2° E		
1					

619


DIETZGEN NO. 388-6

73 LINE

C. S. File No. 49/155

	344.89		N2°40'E		495.3
				N3'E	+3'50" 300
64		7°16' 3'38L			
64	352.10		N6°18'E		+5'25" 516 2'30" 301
63		P.O.T.			
	473.54		N6°18'E		+4'40" 174 2'00" 300
		79°54' 39°57R		N15'E	
62	155.14		N33°39'W		
				N34'W	+6'00" 156
61		34°27' 17°13L			
	137.81		N16°25'30" N17°W		-6'30" 1387
60		21°08' 10'34L			
	297.07		N6°51'30" W		
				N7°W	-4'00" 2978
59		32°45' 16'22L			
	1898		N10°31'E		
				N13°	
58		21°00' 10'30L			

DIETZEN NO. 385-6

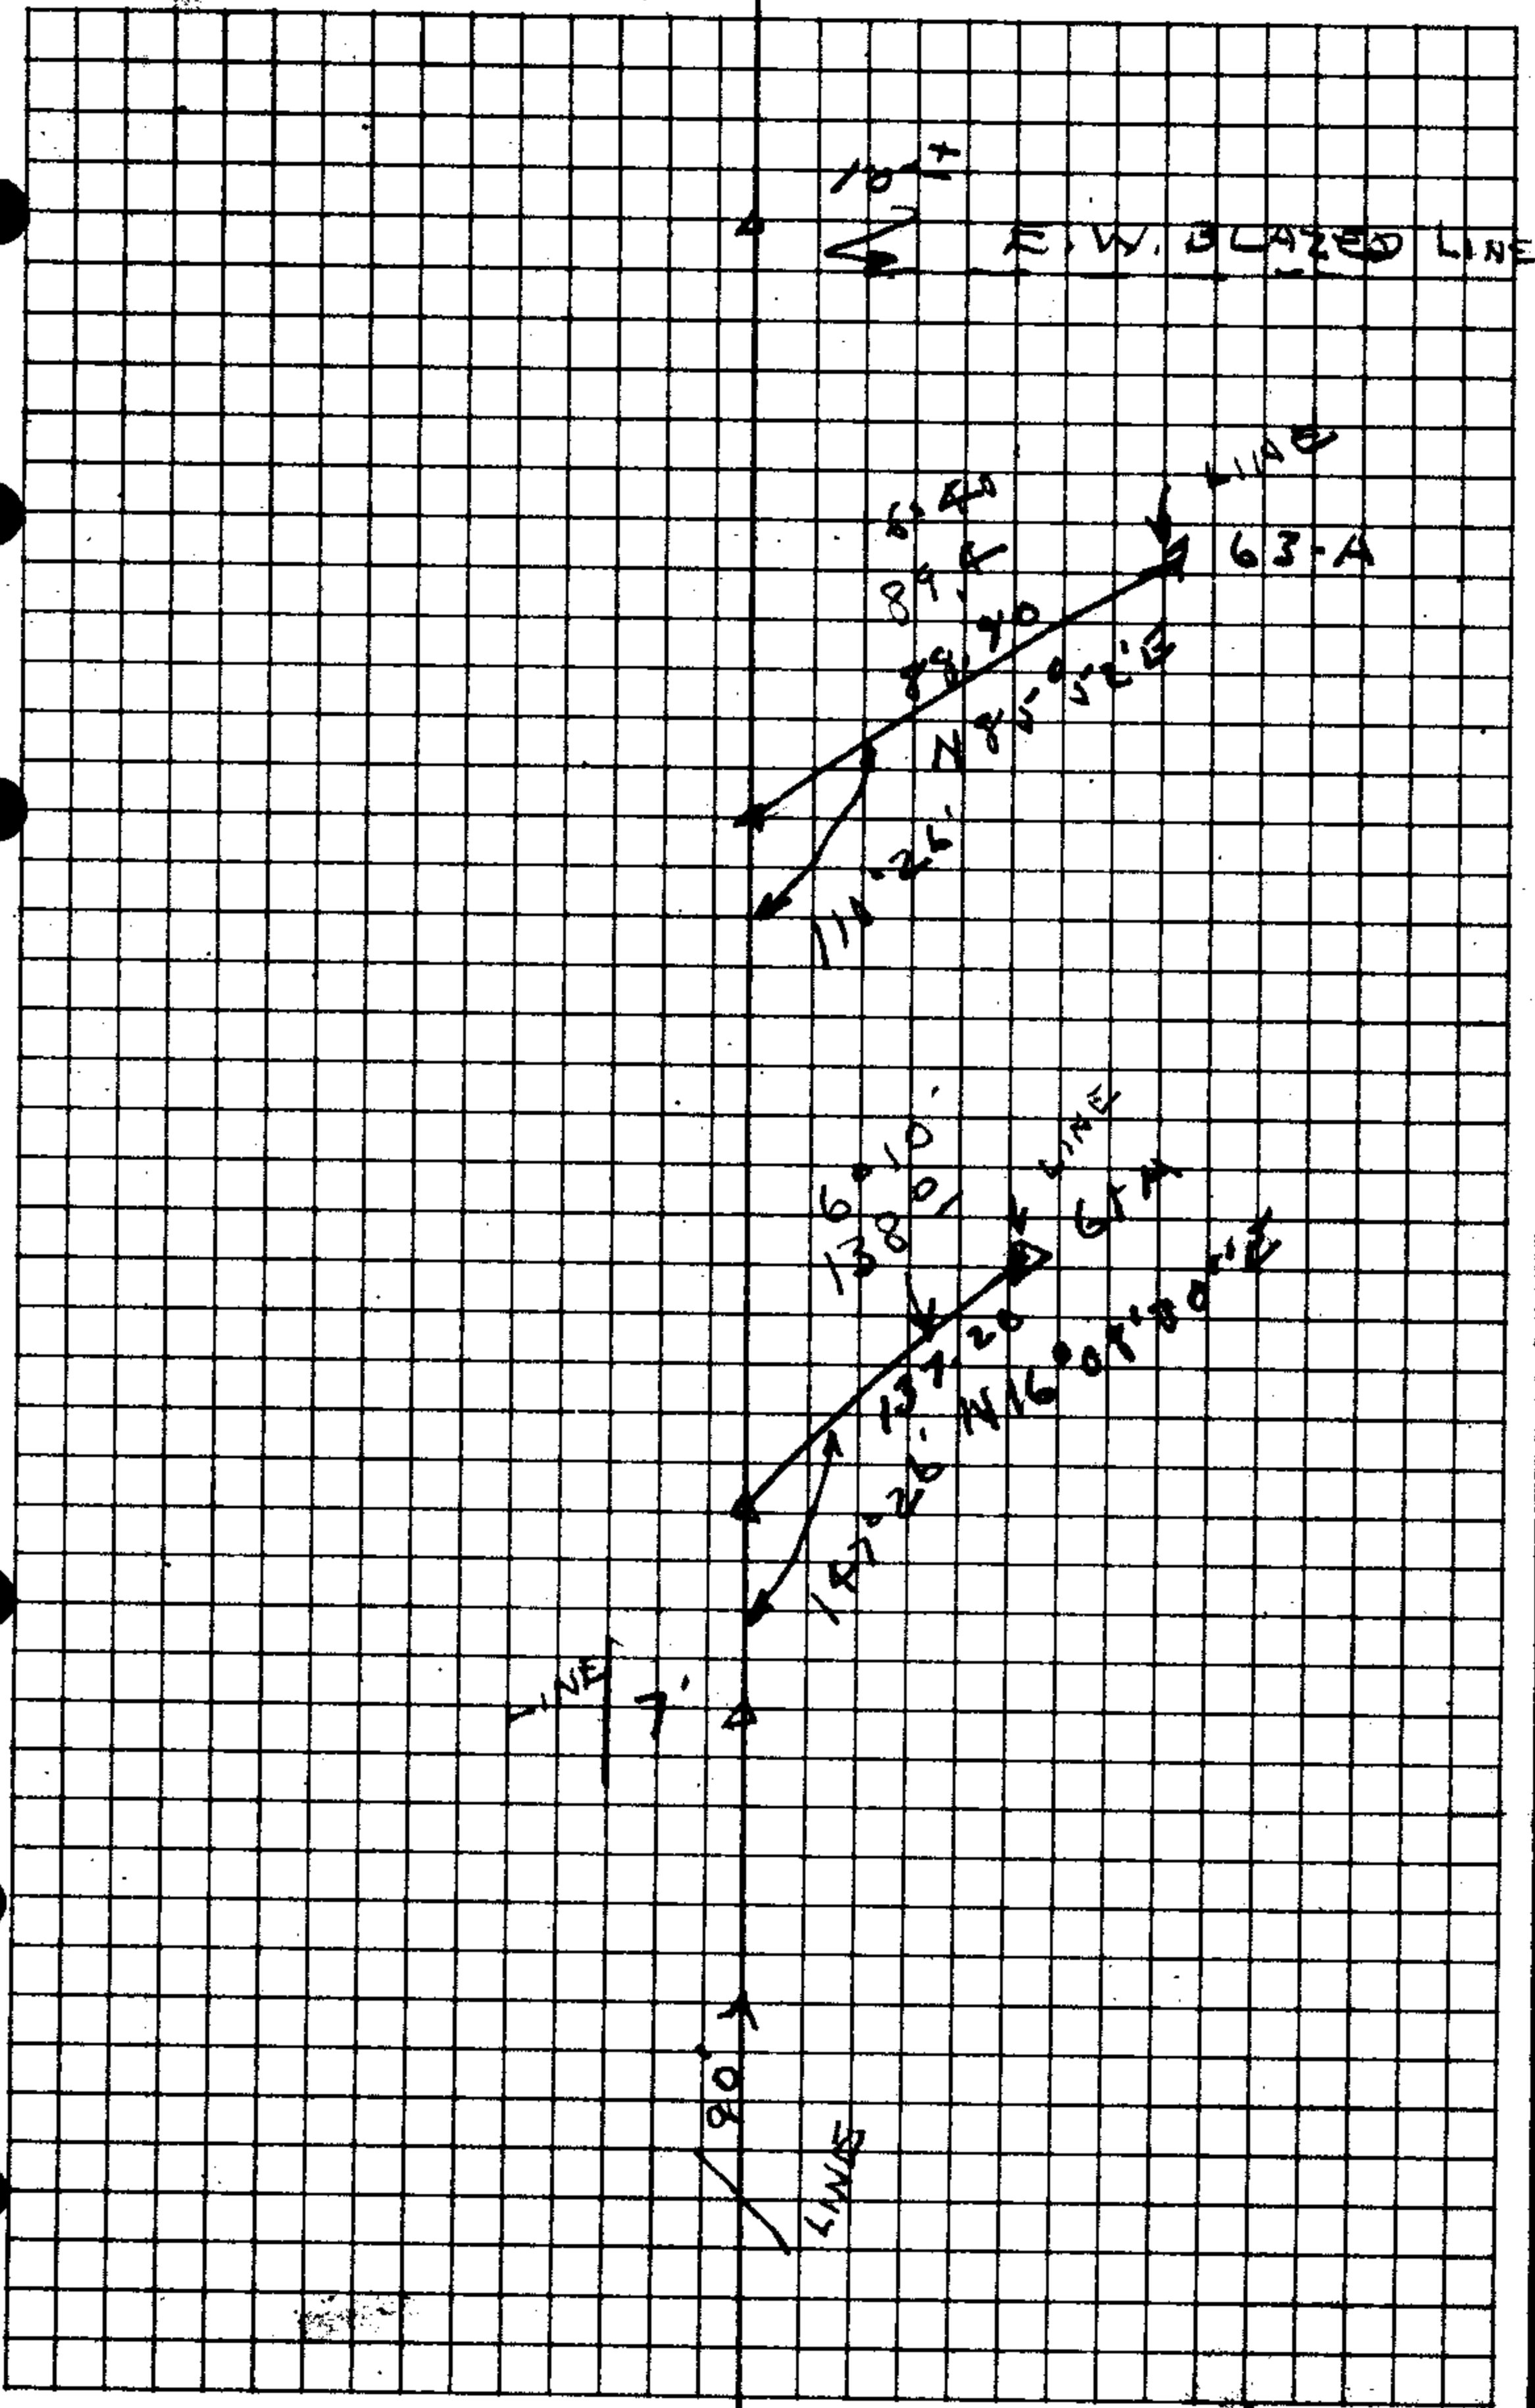

C. S. File No. 49/155

			N21°04'E N21°E	
71		20°04' 10°02'R		+11°00' 1666'
	457.84		N11°02'E	
				+10°10' 299°
70		37°28' 18°44½R		
	253.77		N74°23'W	
				+25°00' 280°
69		11°01' 5°31'L		
	131.58		N2°11'30"W	
				+29°30' 1446'
68		39°57" 19°58½L		
	234.21		N17°47'E	
				+6°00' 2355'
67		86°04' 43°02'R		
	187.19		N25°15'W	
				5°20' 188°
66		47°12' 23°36'L		
				L17.9
				+2°00' 300'
	668.12		N1°39'W	
				L500'
				L300°
			N2°W	
65		8°38' 4°19'L		

ON STAMP

DIETZGEN NO. 305-6

C. S. File No. 49/155

74

99.68

N69°30'E

24'20"
109.4

N69° E

73 =

80°01'
40°01'R

SEE CS FILE
42/44

N28°29'E

1030'
154.3

154.25

N27° E

72

14°49'
7°25'R

223.17

N21°04'E


75'45"
224.3

MAY 22 - 1959

J. BYRON
U.S. B. LOW
U.S.A. RUBLE

YAR 20 1/2"

DIETZGEN NO. 3885-6

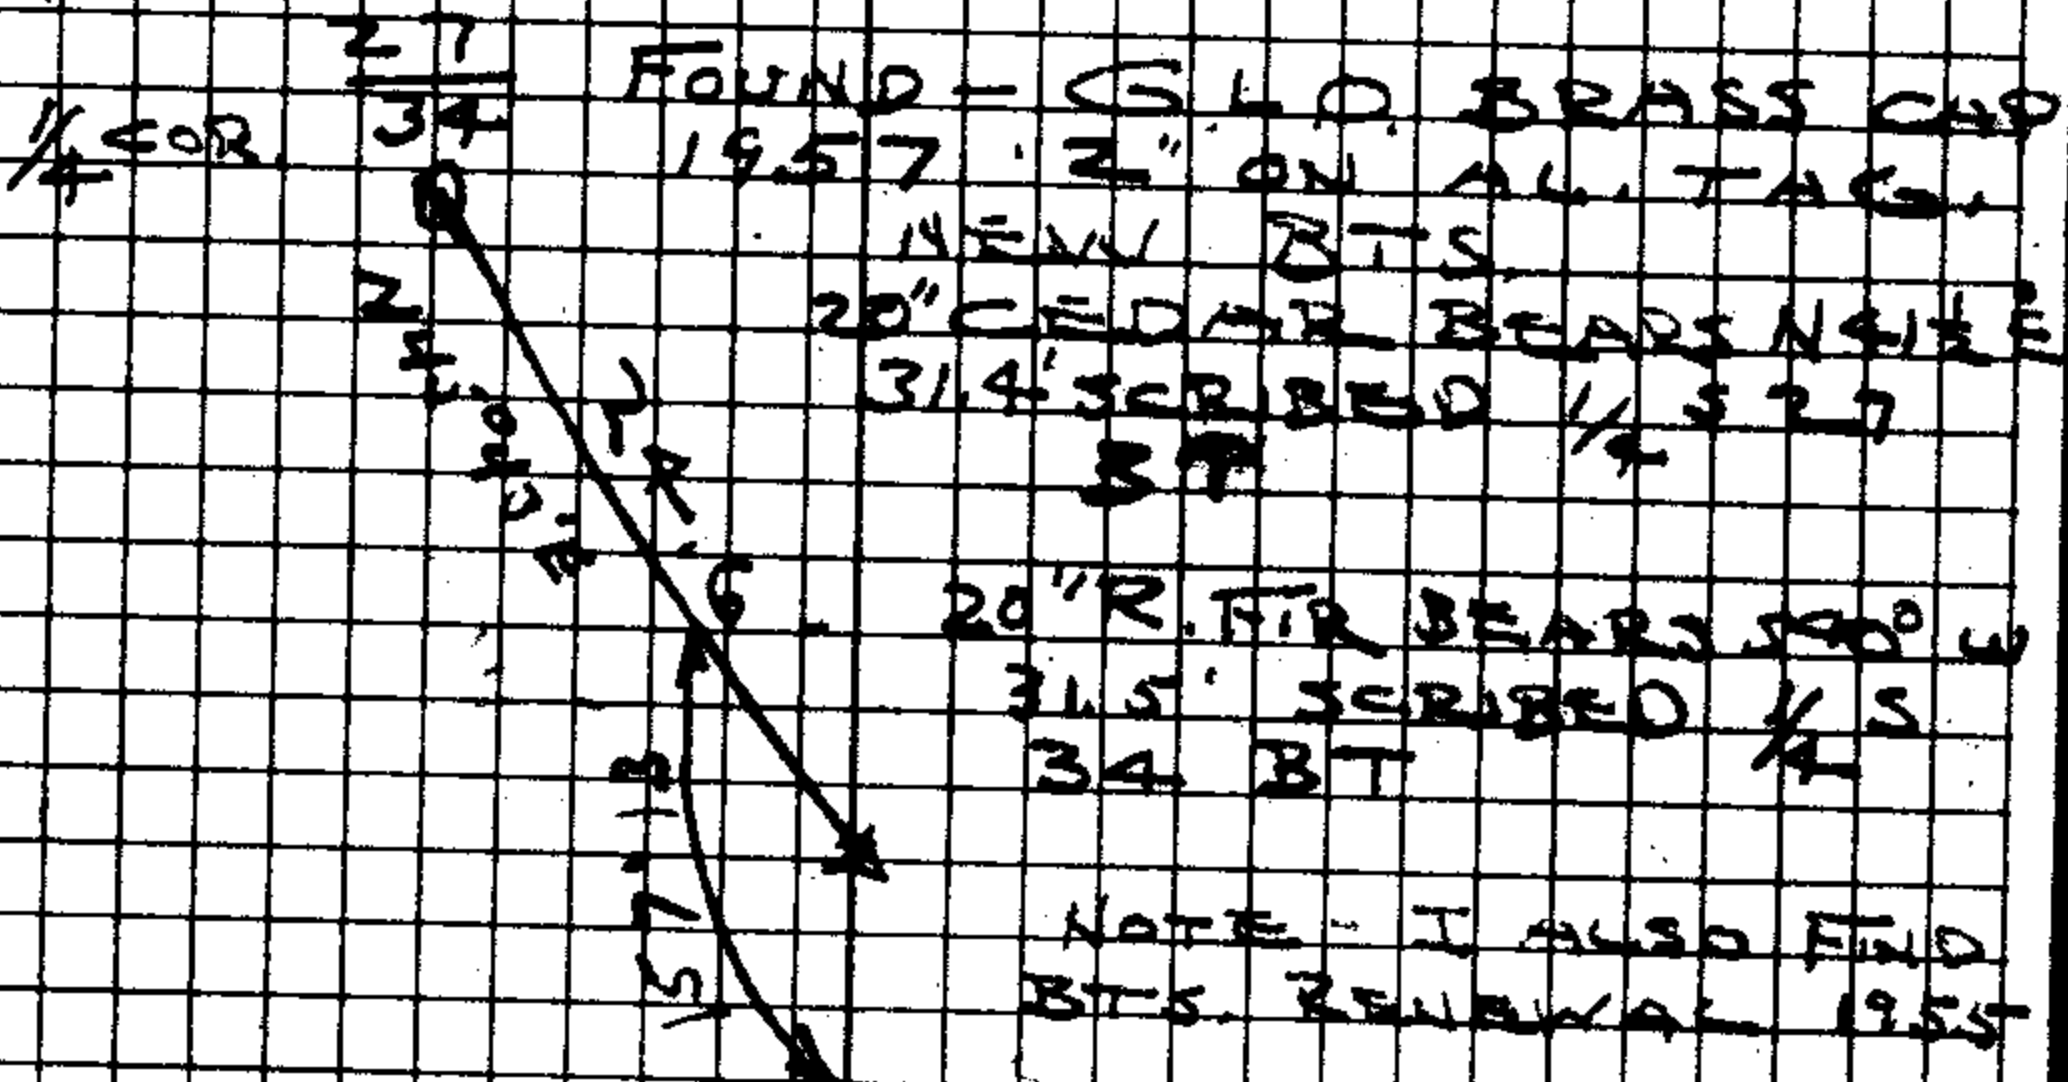

AMIK 118 STUMP

C. S. File No. 49/155

72 FS 71 A2 TO RT

H.L

V.L

TIME
PM

9

51°31'

47°35'

2:59:36

10

50°54'

47°50'

3:00:25

9

51°55'

47°05'

3:01:20

10

51°22'

47°30'

3:02:24

9

51°21'

47°05'

3:03:11

10

51°43'

47°15'

3:03:46

9

52°40'

46°30'

3:04:36

10

52°1'

47°00'

3:05:16

9

53°00'

46°18'

3:06:02

10

52°24'

46°13'

3:06:53

WATCH IS 5 min slow

CS FILE FOLDER

CONTAINS

MORE

INFORMATION