

Nov. 1, 1959.

East + West Center Line Section
29, T. 32 S., R. 5 W.

Begin at $\frac{1}{4}$ Corner bet. 29 + 30.
as recorded.

East Var. $20\frac{1}{2}^{\circ}$

885.0 Top Spur.

1320.0 Drive $\frac{1}{2}$ " I.P. 46.7 S. to hold line.

1400.0 Drive $\frac{1}{2}$ " I.P. 50.2 S. to hold line.

2500.0 Drive $\frac{1}{2}$ " I.P. to hold line

2640.0 Drive $\frac{1}{2}$ " I.P. to hold line.

4800.0 Top Ridge.

5301.5 Find $\frac{1}{4}$ Cor. bet. 28 + 29.


188.3 ft. South.

$\frac{1}{4}$ Cor. as found.

$1\frac{1}{4}$ " Iron Pipe.

12" Fir S. $86^{\circ}15'W$. 21.0 ft.

12" Fir N. $70^{\circ}36'E$. 39.4 ft.

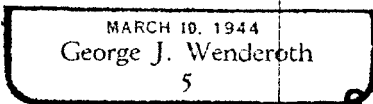

S. File No. 49/188