


JESSE BAILEY  
 OAKLAND  
 SECTION 4, T.25SR5W  
 MARCH 1954 SCALE 1" = 40'

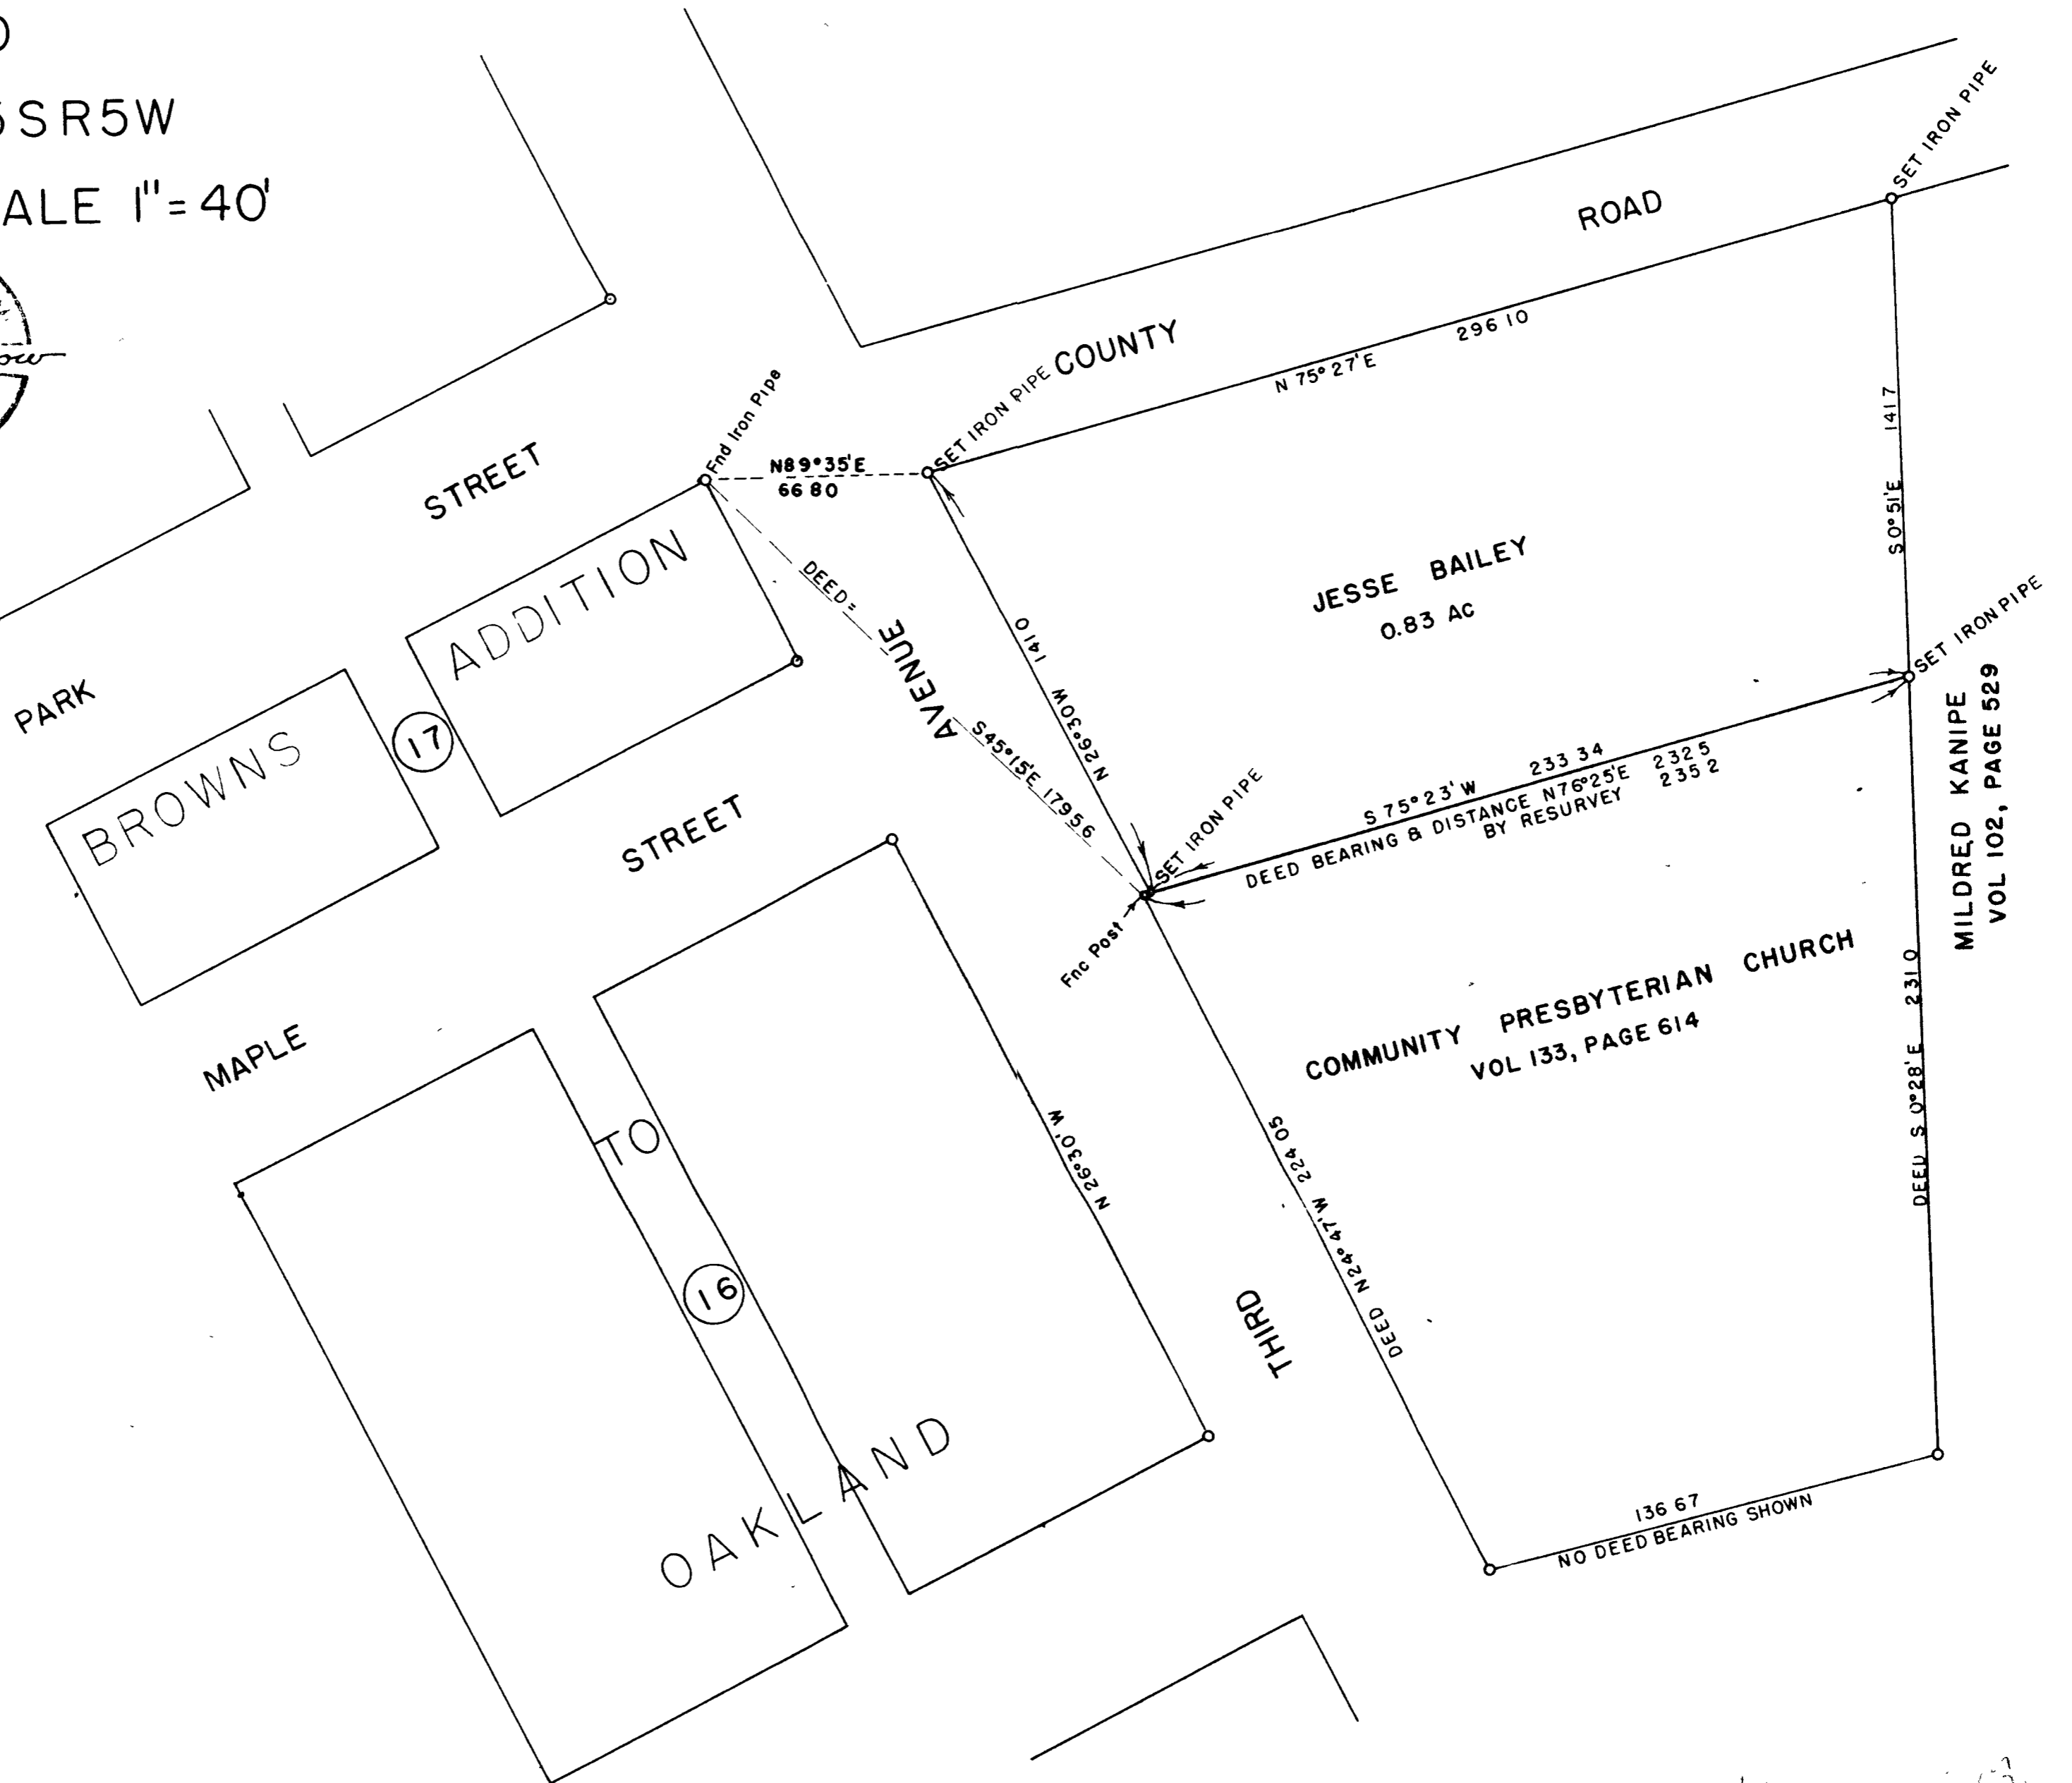

MILDRED KANIPE  
 VOL 102, PAGE 529

FOR INFO  
 T.M.C. 11-15-63