T22R6 Sec 16

I, FRED L DOW OF SUTHERLIN, OREGON DO HEREBY CERTIFY THAT THIS MAP WAS MADE FROM NOTES TAKEN DURING AN ACTUAL SURVEY MADE BY ME ON JUNE 22nd 1950 THAT THE MONUMENT SHOWN ON THIS MAP CONSISTING OF A 1"x36" IRON PIPE IS N65°15 E 1972 2 FEET FROM THE SOUTWEST CORNER OF THE NORTH AND WEST EXTENTION OF THE JOS PUTNAM DLC No 38 IN SECTION 16, T22S R6W WM, IN DOUGLAS COUNTY, ORE

Fred L Dow

REGISTERED PROFESSIONAL ENGINEER 382 OREGON MAR 9 FRED L DOW

SURVEY FOR
BRUCE CUNNINGHAM
DRAIN ORE

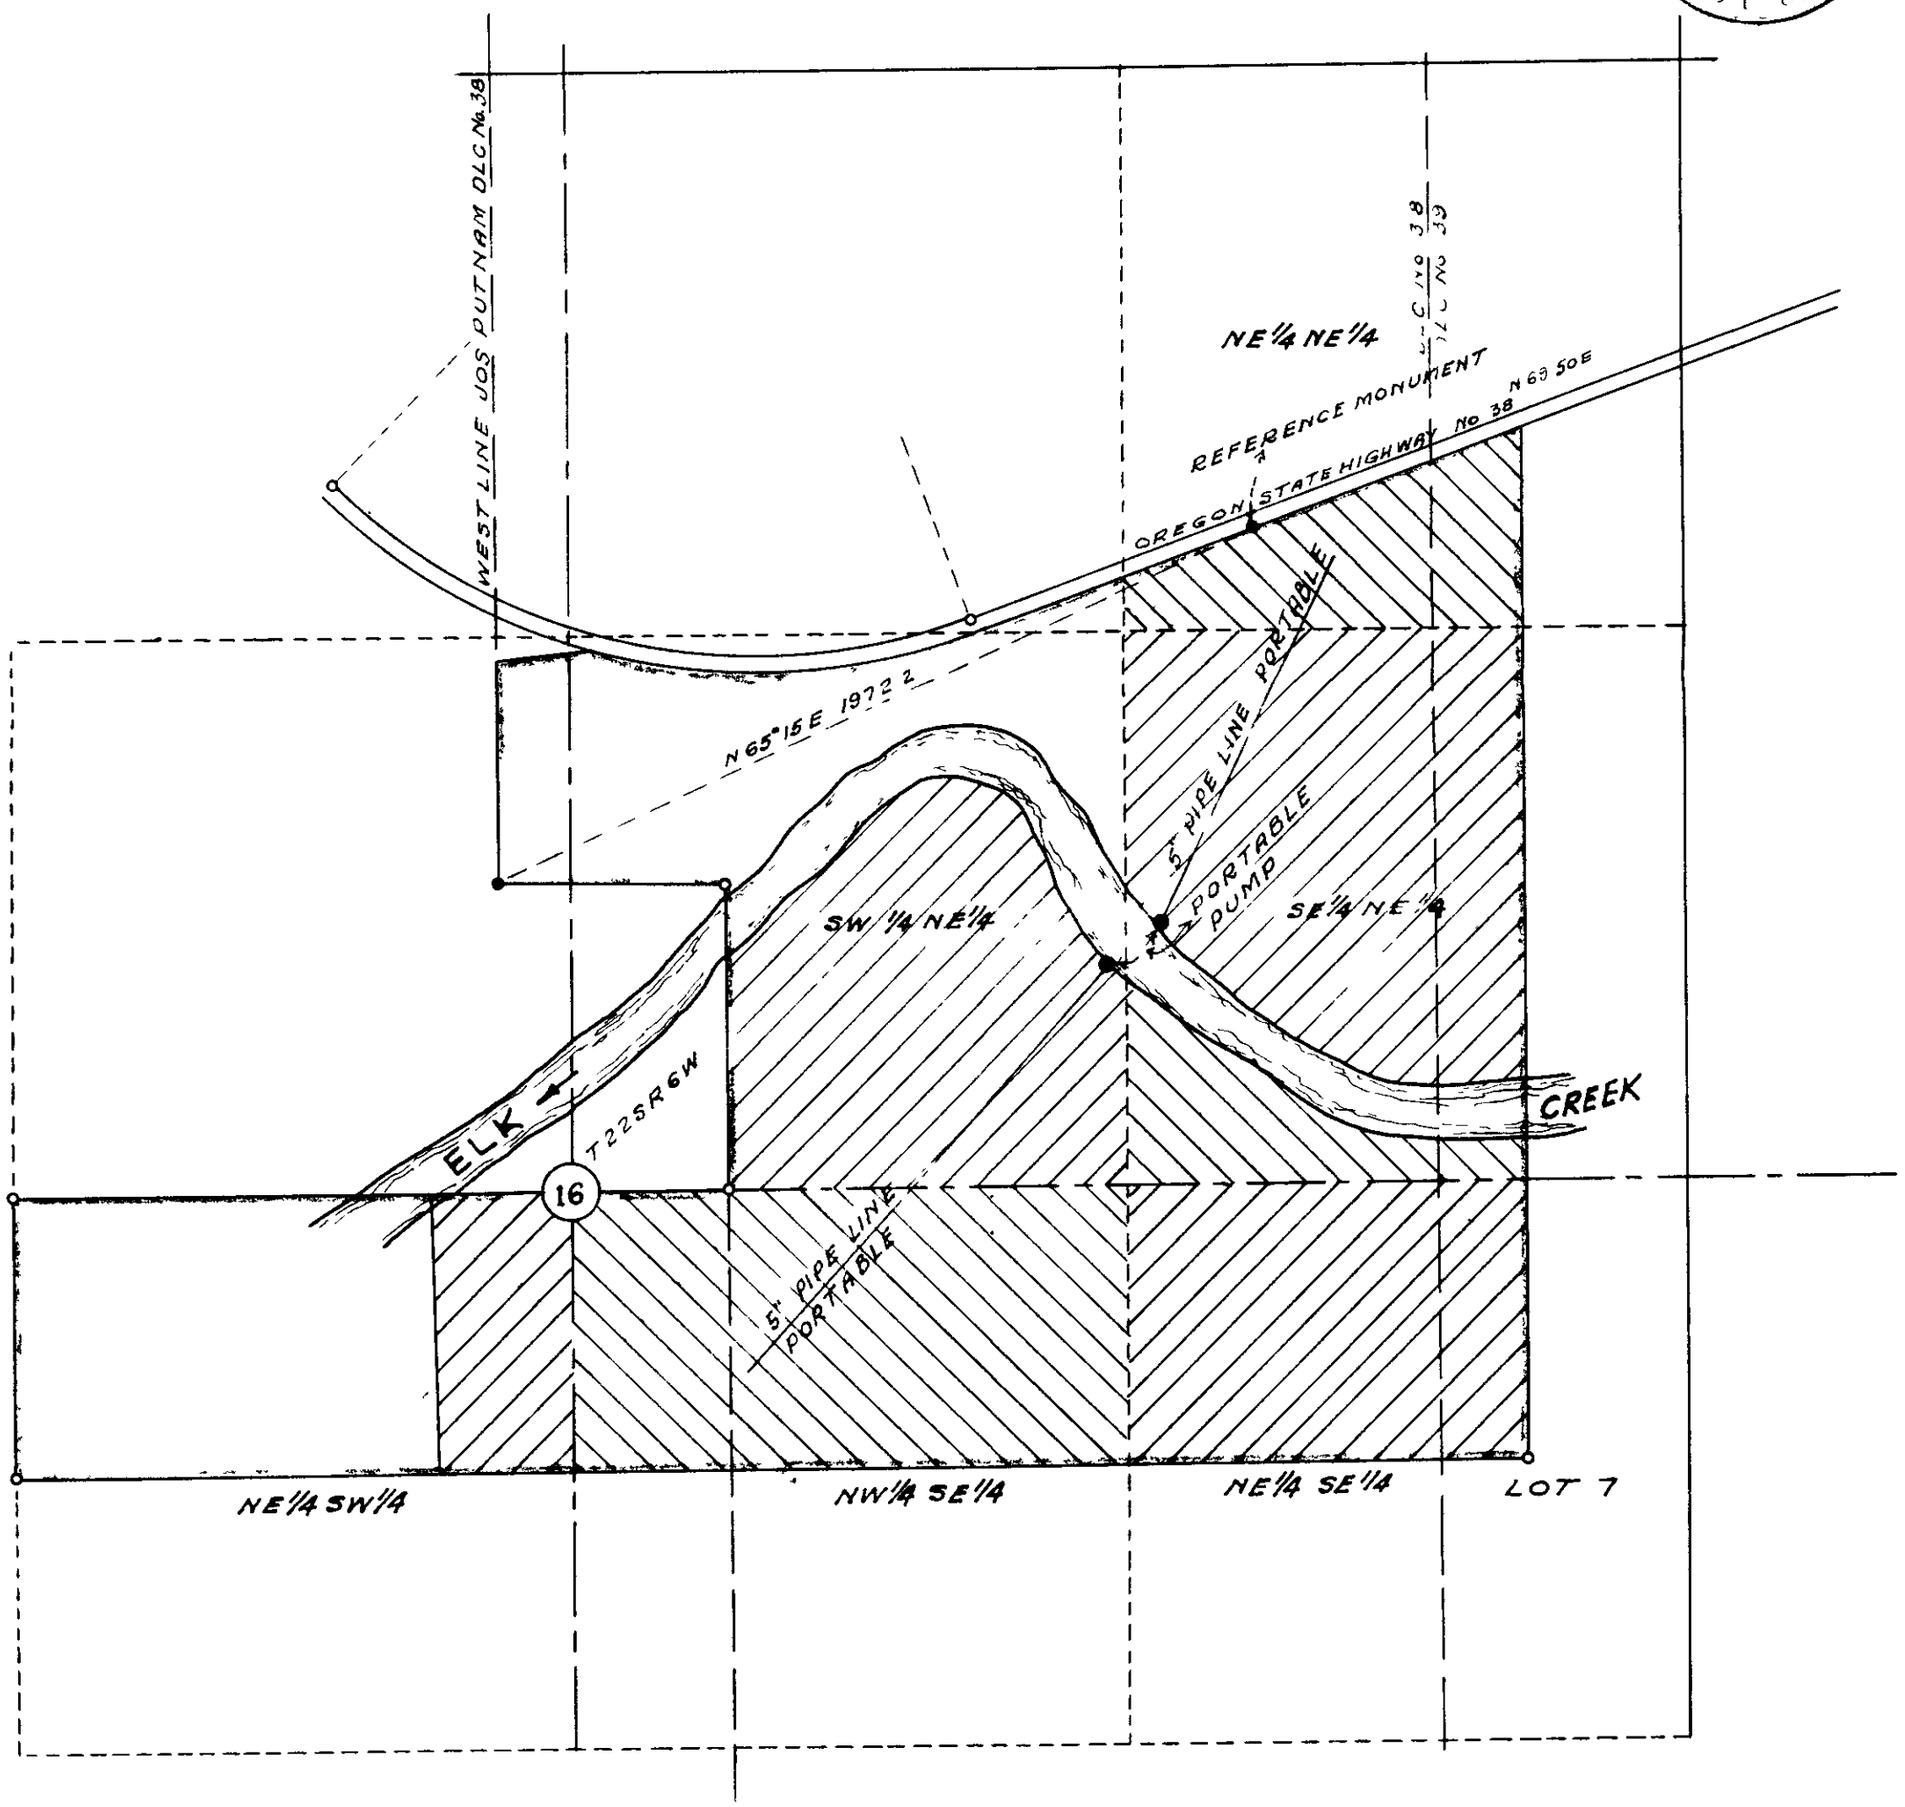

C S File No 50/27