COUNTY SURVEYORS FILE DATA
DO NOT REMOVE FROM OFFICE

SURVEY FOR MRS ALTAVERNE F DOWLER

JUNE 1948
SCALE 1" = 200
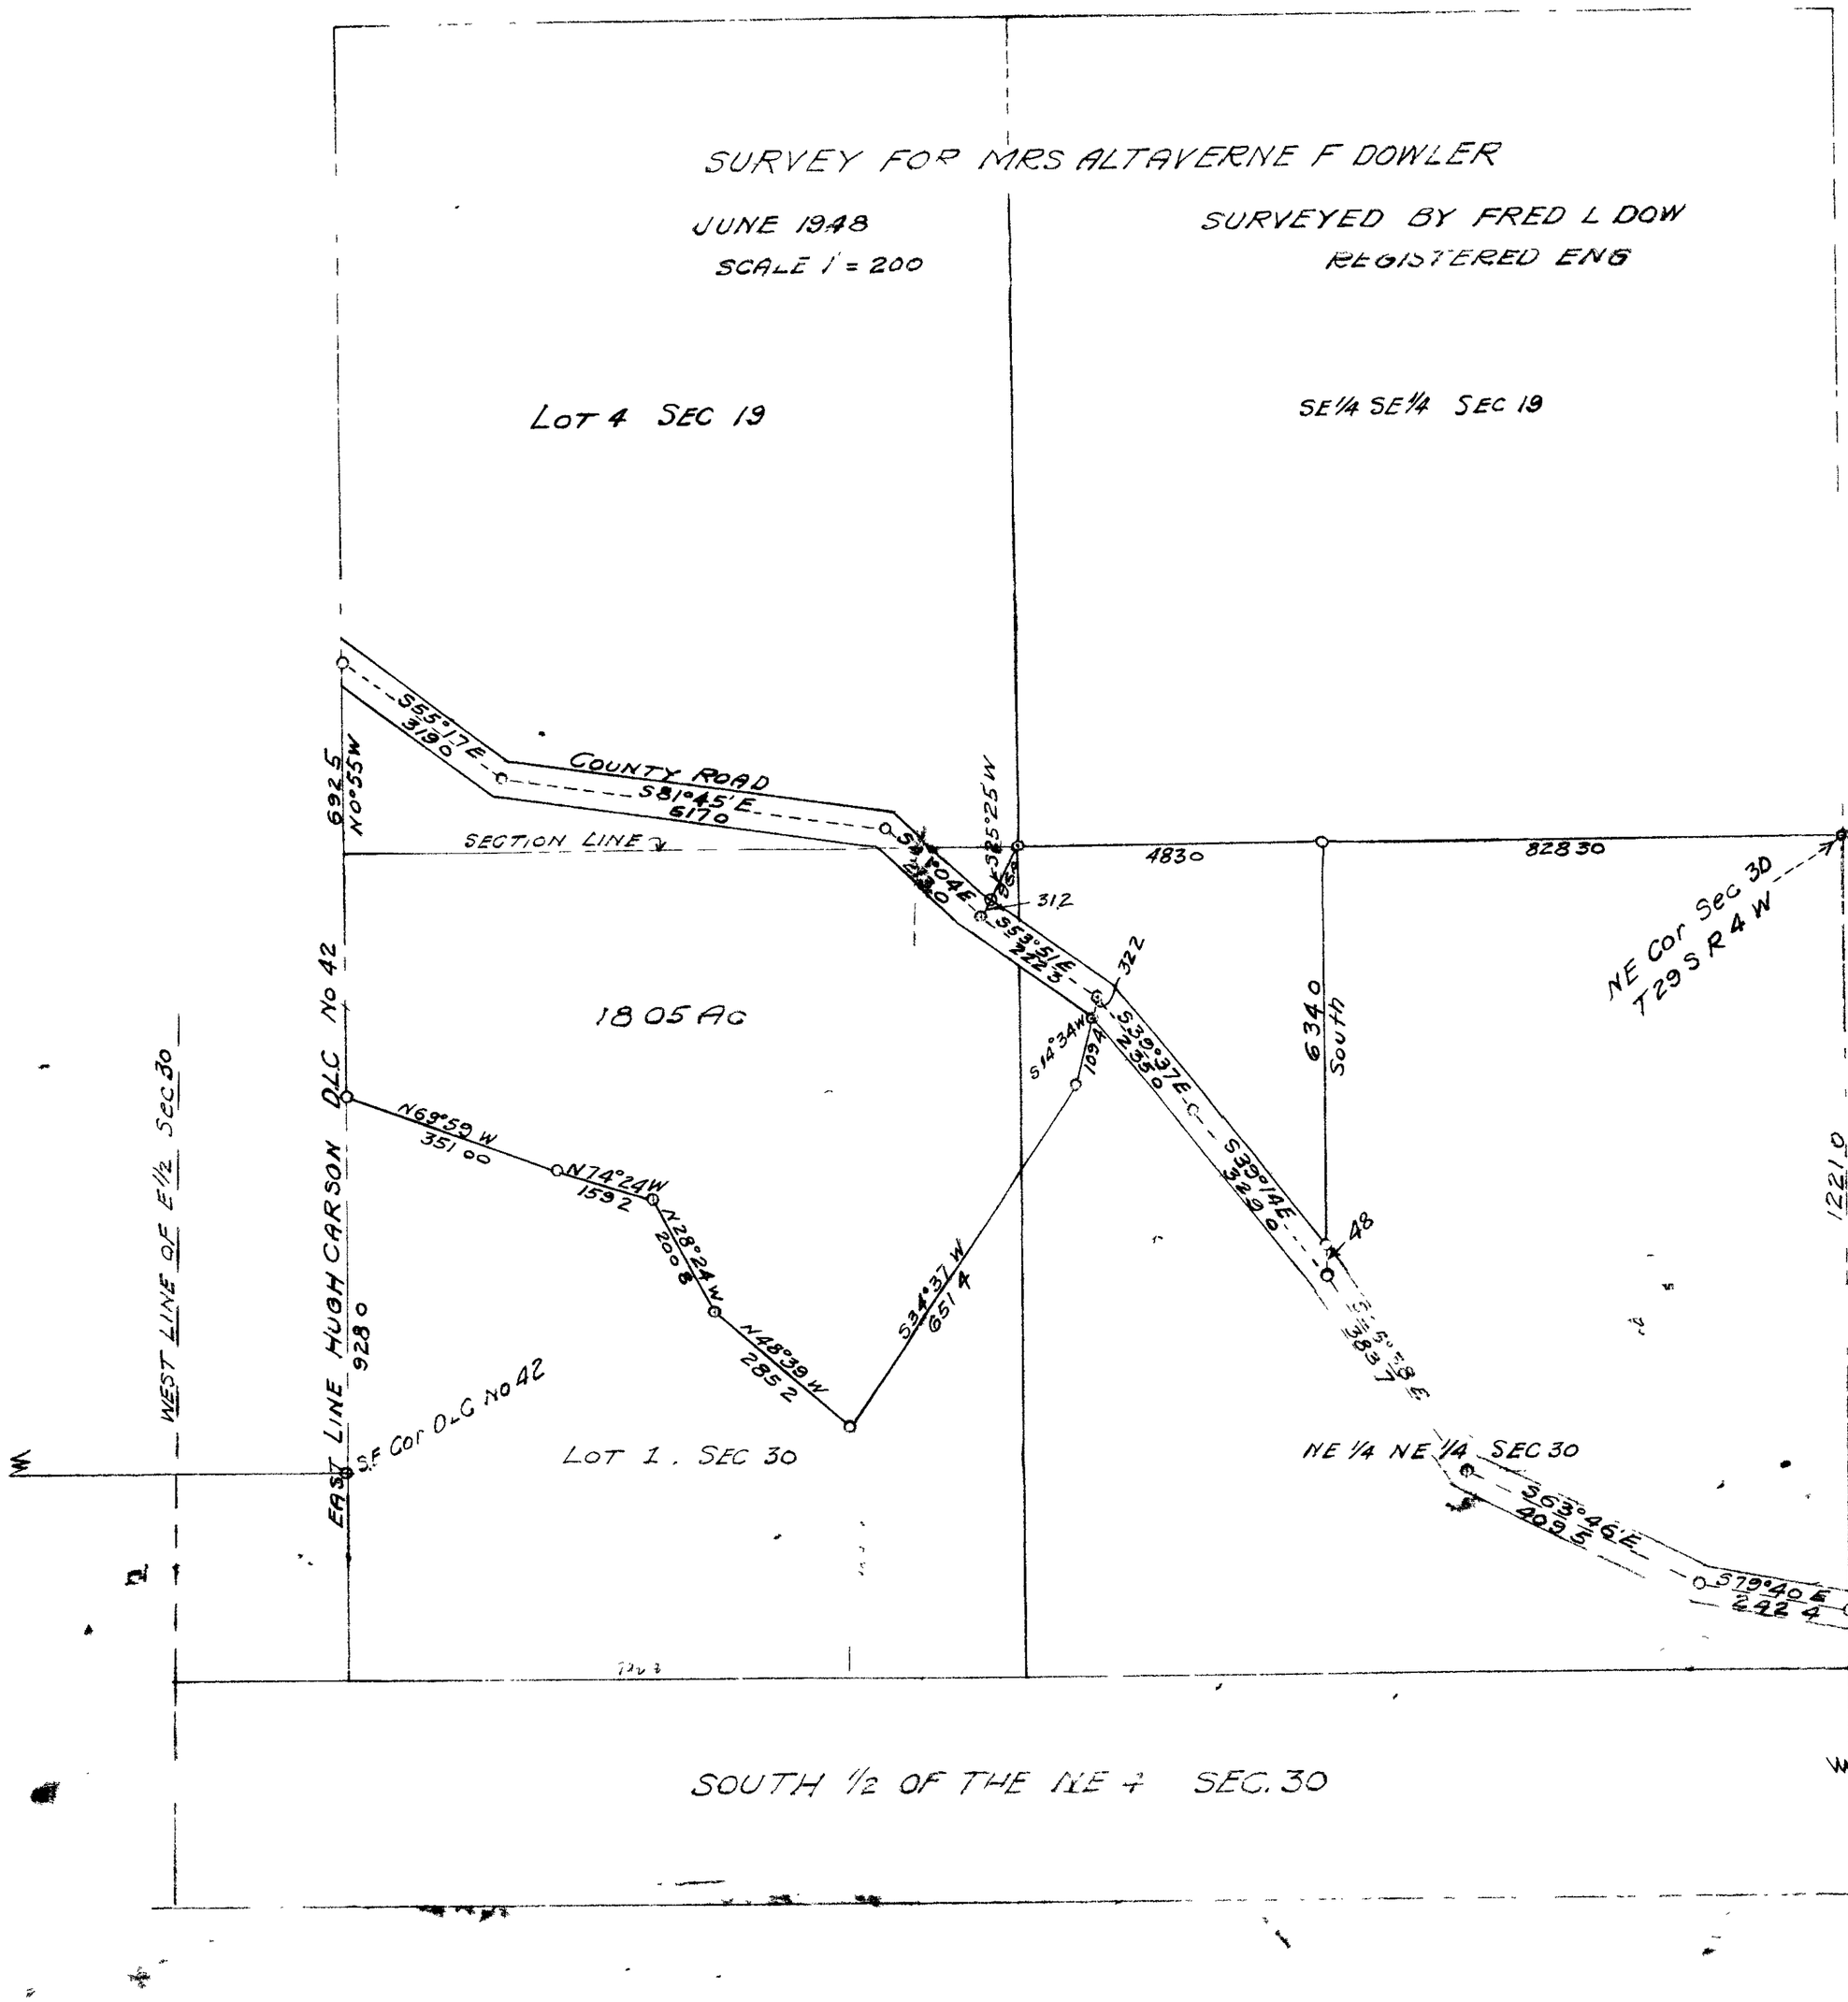
SURVEYED BY FRED L DOW
REGISTERED ENG